


20913-A

SEE 1-00-058-A

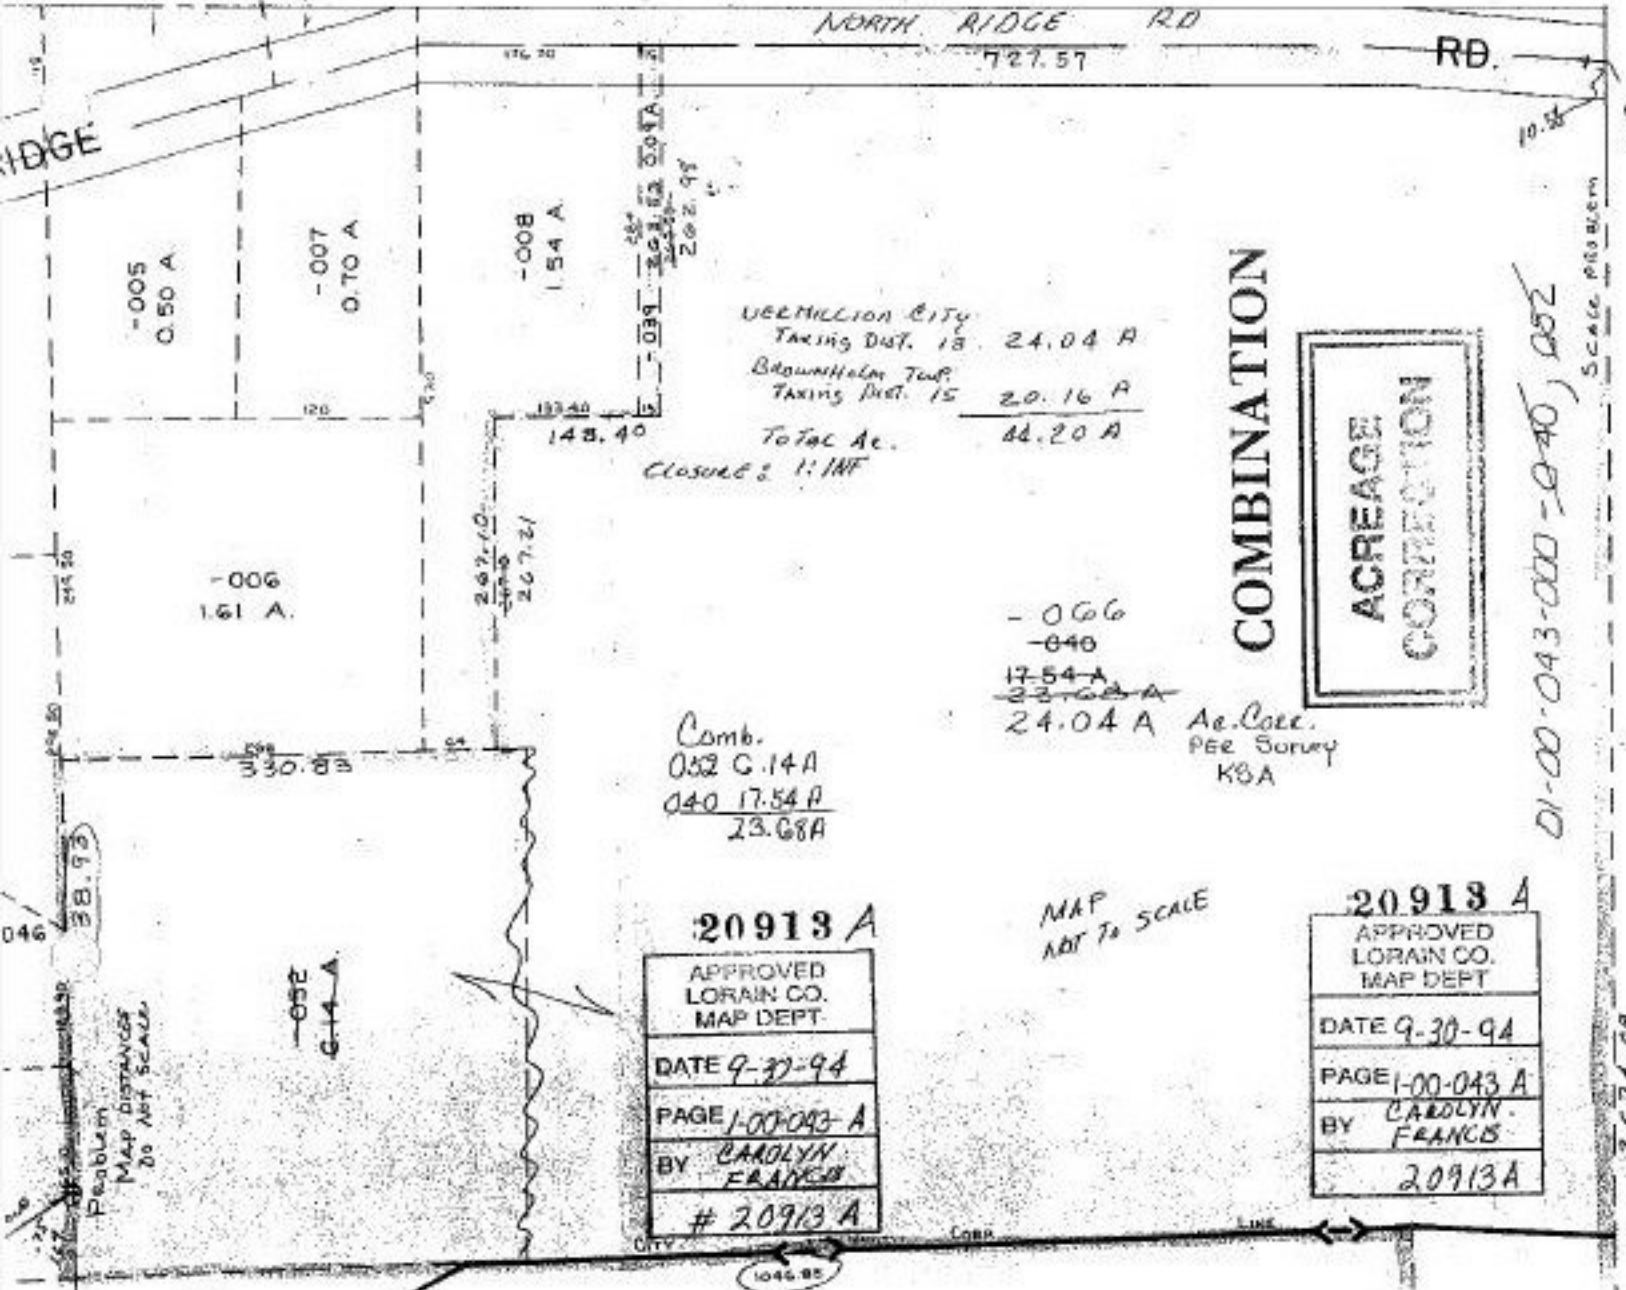

VERMILION CITY  
 TAXING DIST. 13 24.04 A  
 Braunhelm Twp.  
 TAXING DIST. 15 20.16 A  
 Total Ac. 44.20 A  
 Closed & 1:1NF

COMBINATION

ACREAGE  
 CORRECTION

-066  
 -040  
 17.54 A  
 23.68 A  
 24.04 A Ac. Corr.  
 P&E Survey  
 KBA

Comb.  
 032 6.14 A  
 040 17.54 A  
 23.68 A

20913 A  
 APPROVED  
 LORAIN CO.  
 MAP DEPT  
 DATE 9-30-94  
 PAGE 1-00-043 A  
 BY CAROLYN  
 FRANCIS  
 # 20913 A

MAP NOT TO SCALE

20913 A  
 APPROVED  
 LORAIN CO.  
 MAP DEPT  
 DATE 9-30-94  
 PAGE 1-00-043 A  
 BY CAROLYN  
 FRANCIS  
 20913 A

01-00-043-000-040, 052

Scale Problem

2674.09

Problem Map Distances Do Not Scale