

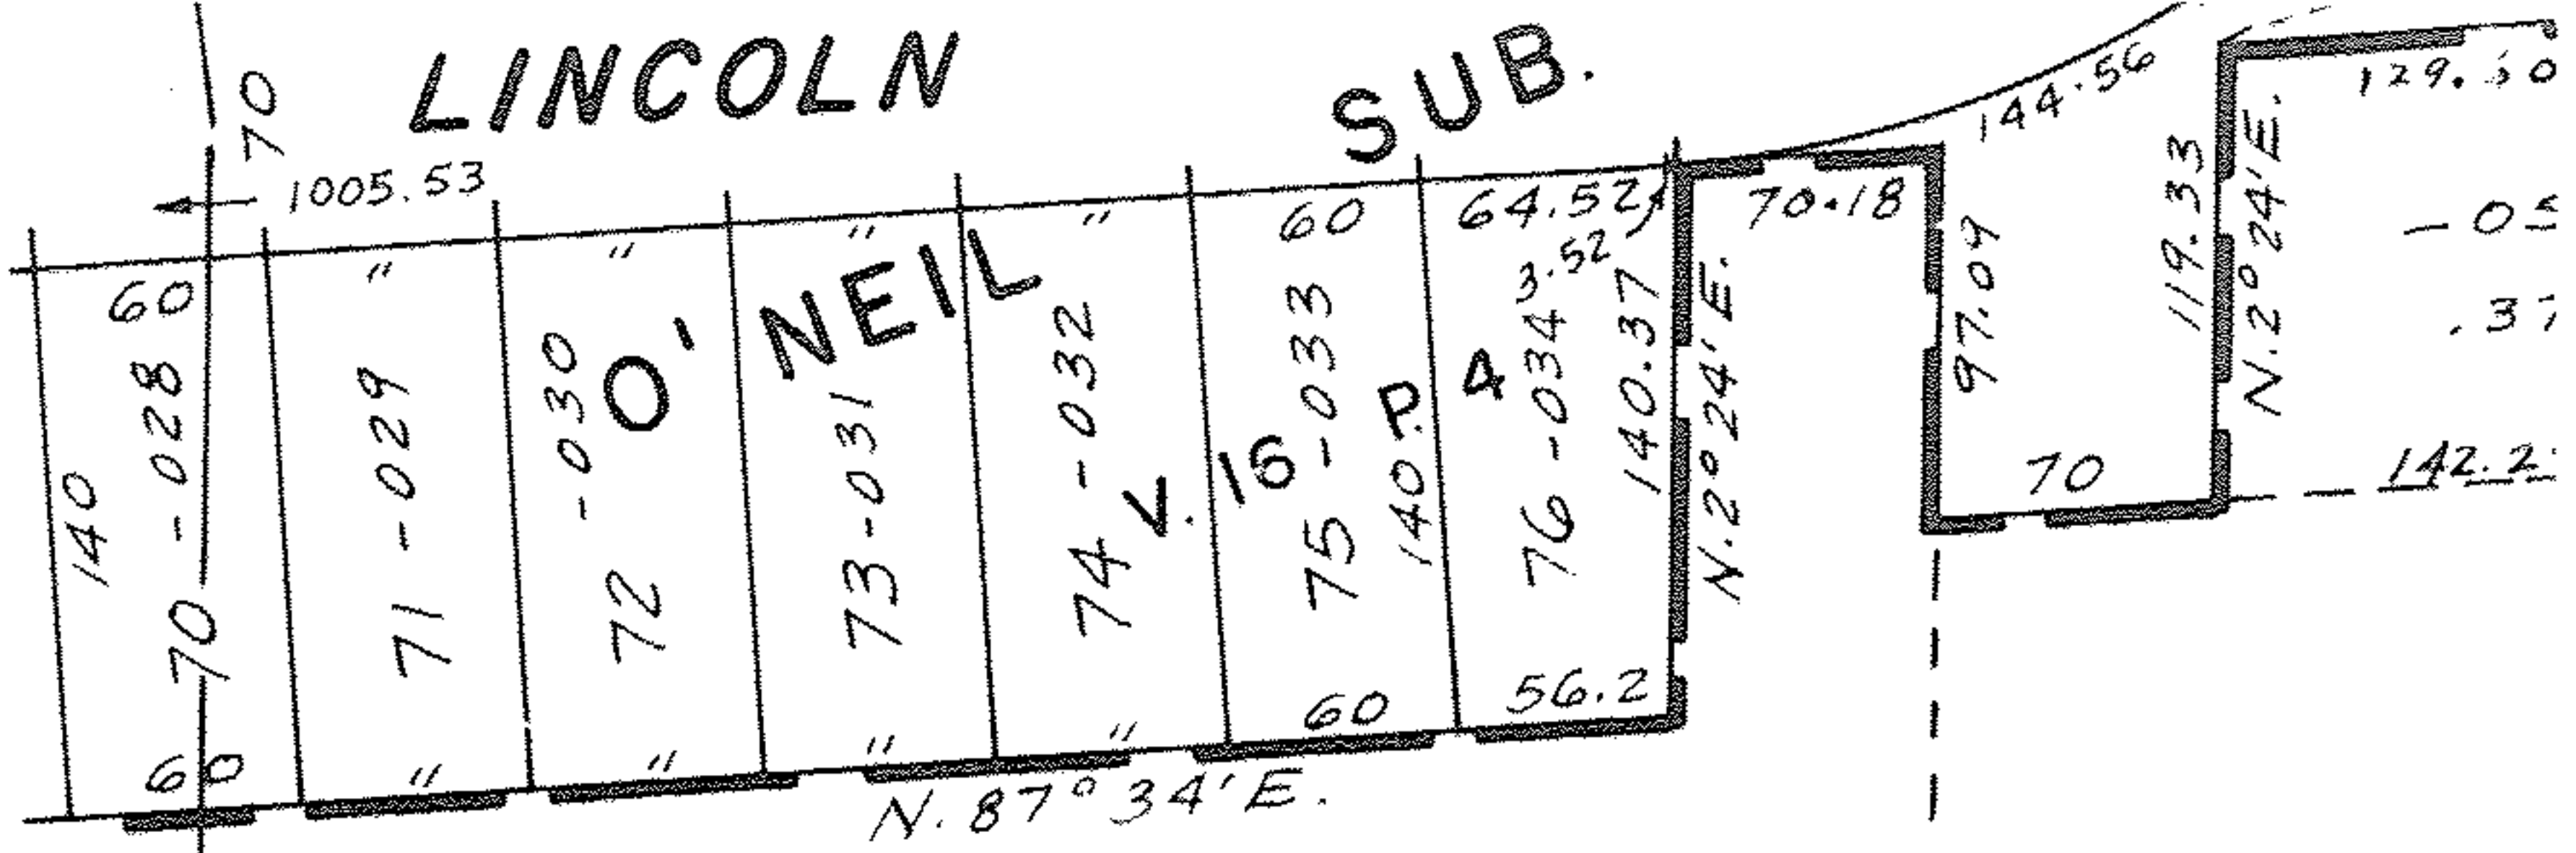


LINCOLN SUB.

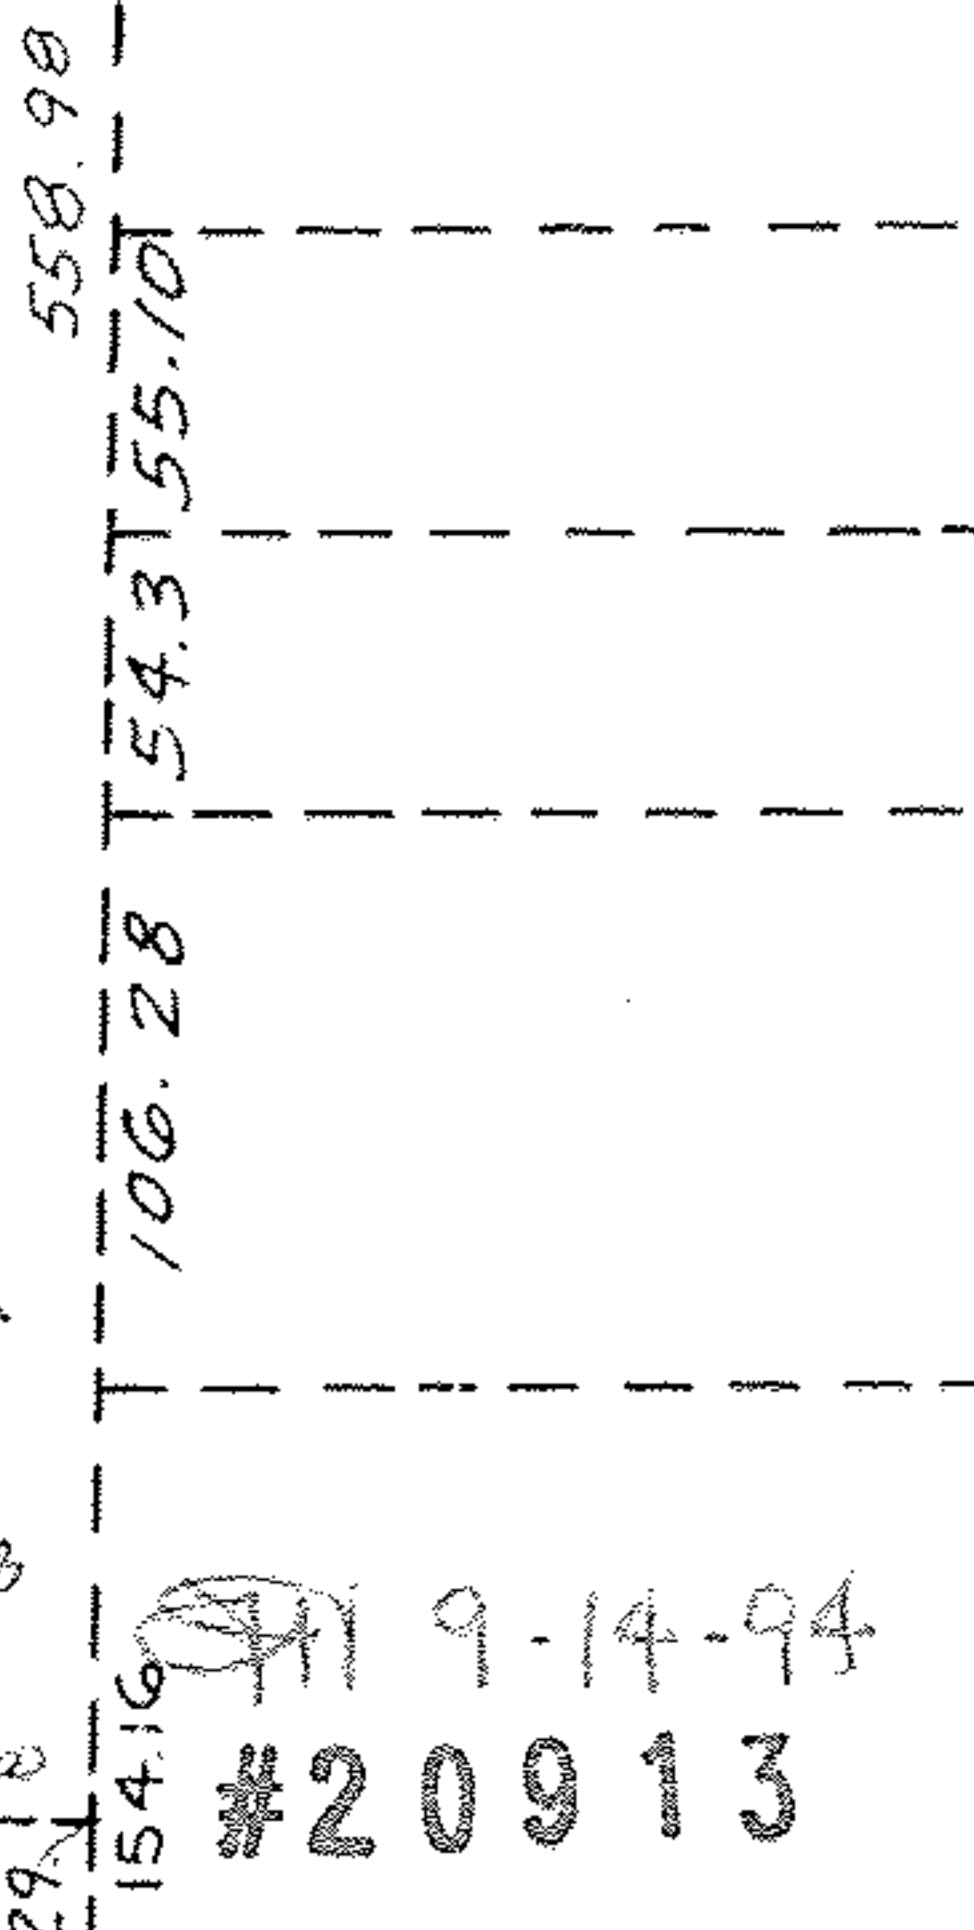

SEE 3-00-112-A

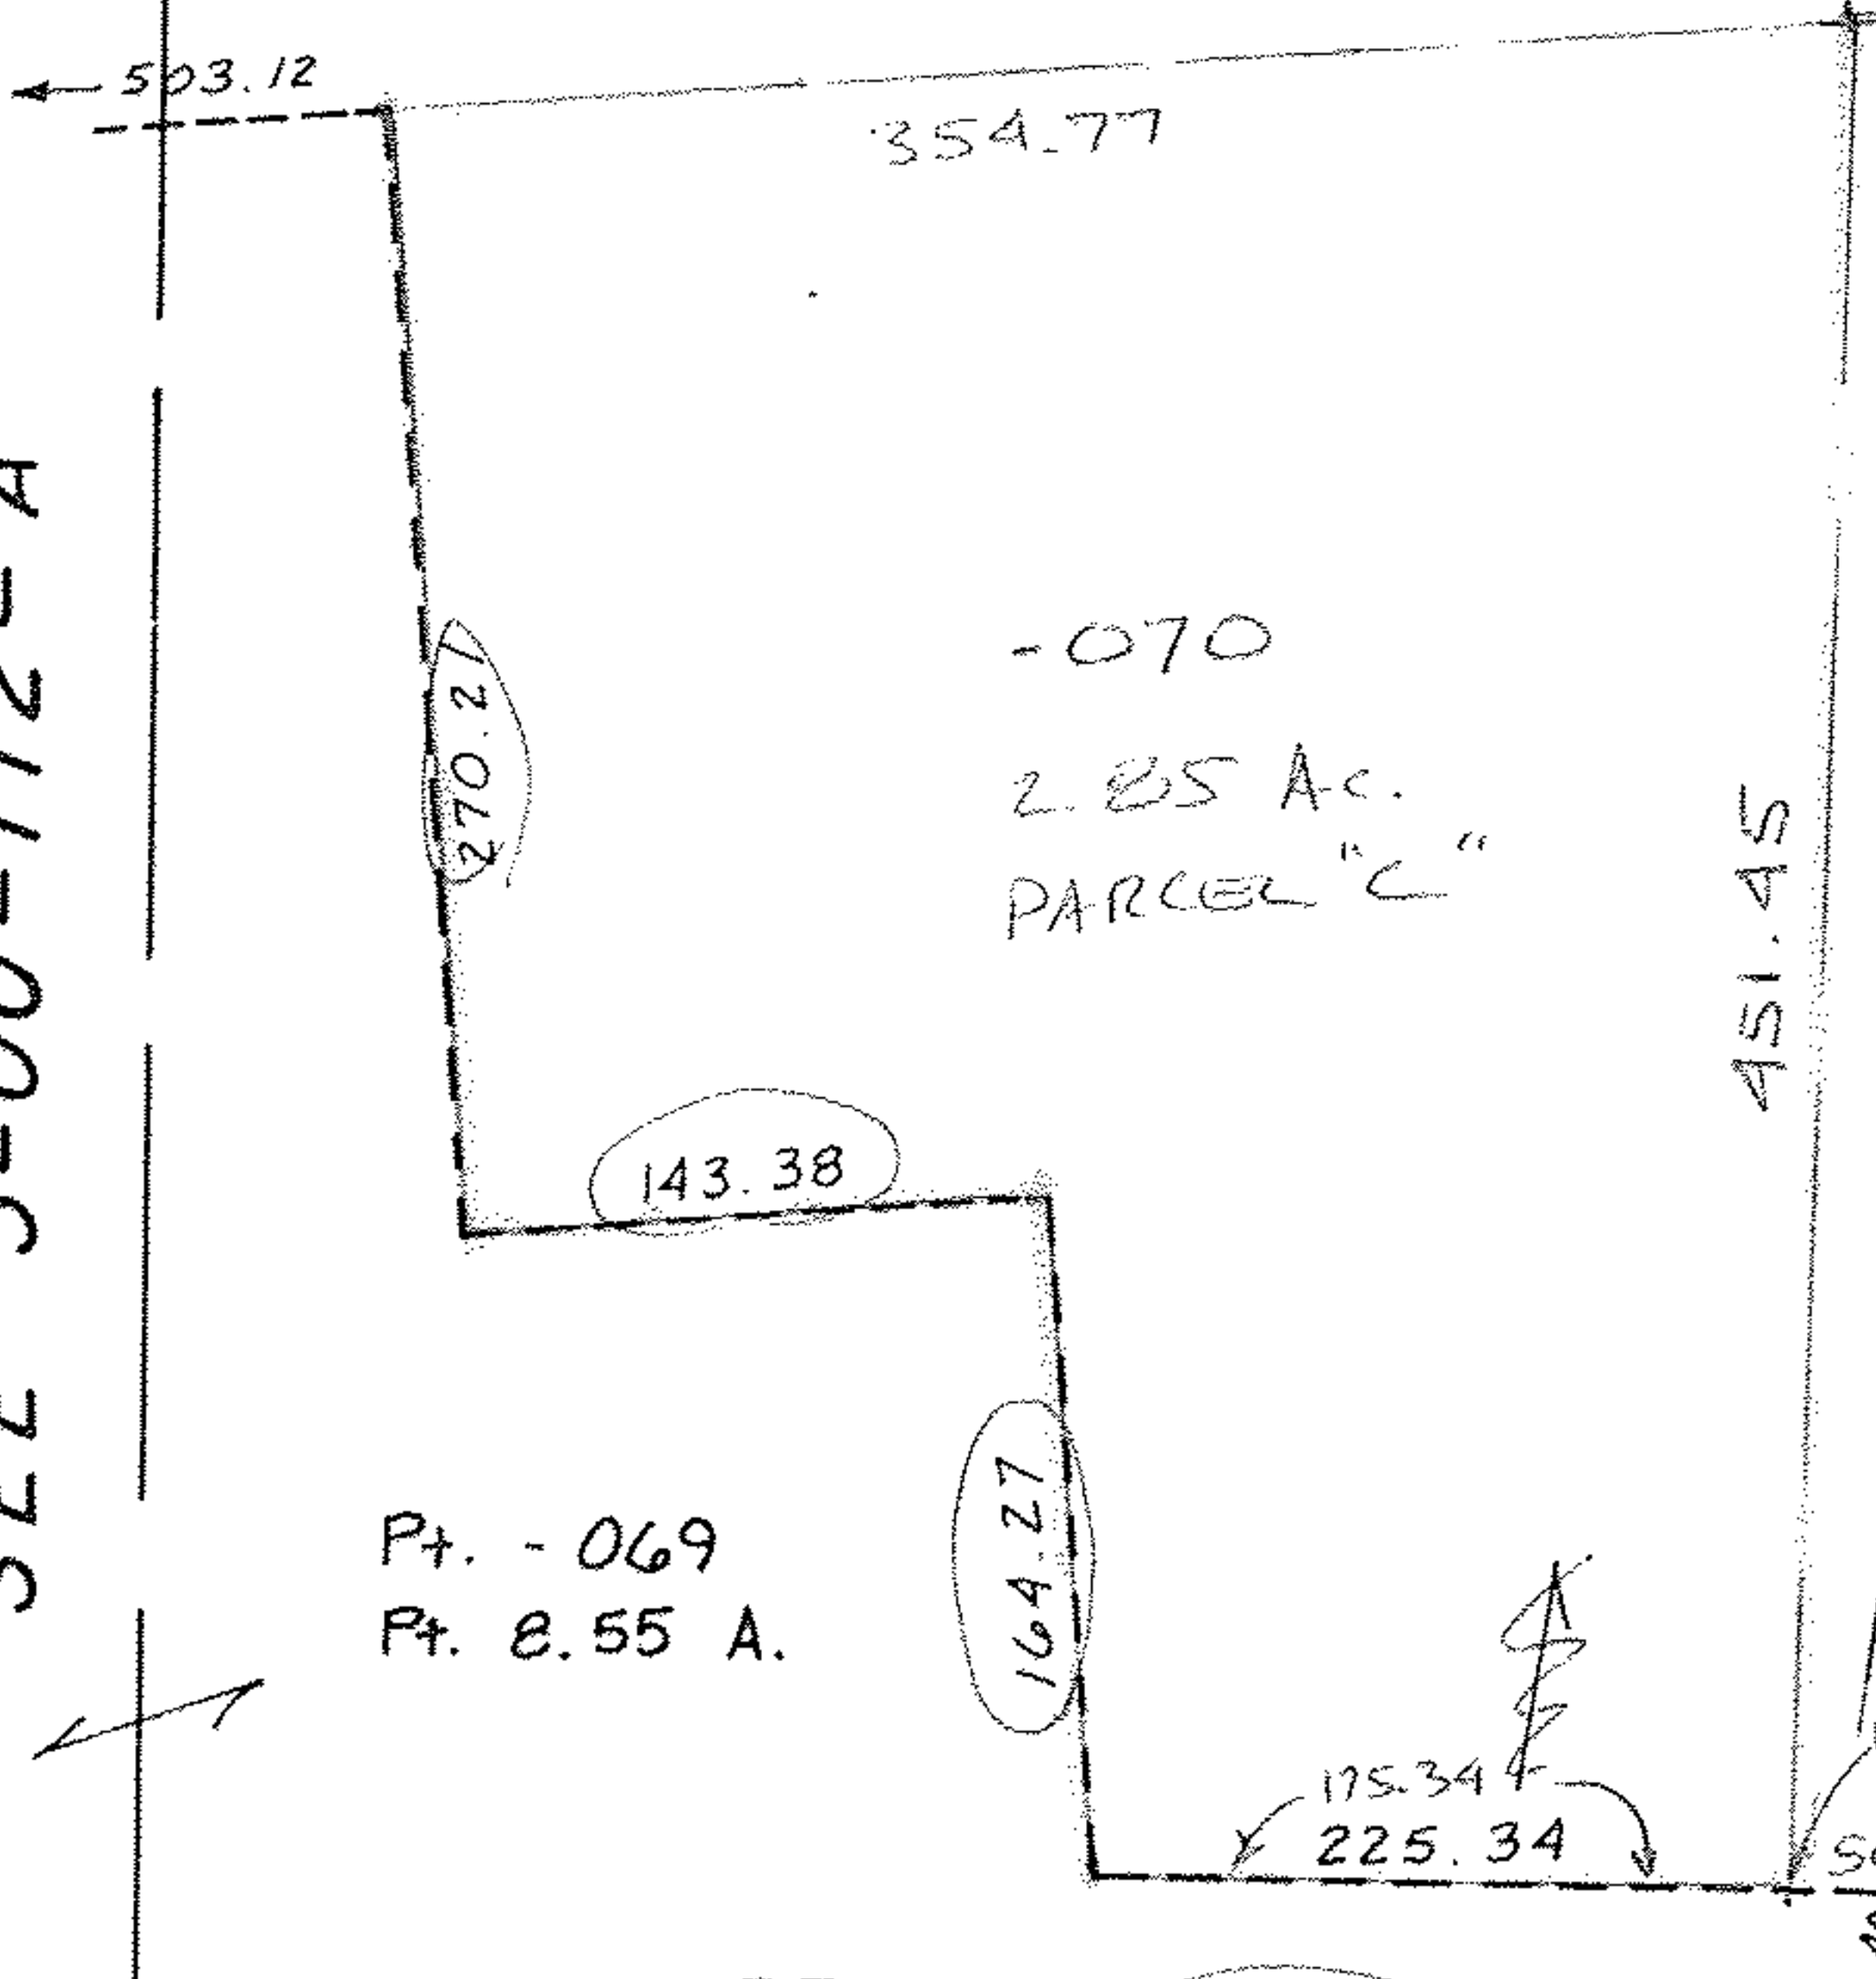

9-14-94
#20913

APPROVED	
LORAIN CO.	
MAP DEPT.	
DATE 6-24-94	
PAGE 3-00-112-B	
BY T. McMain	
VOID AFTER	20913

~~Pt. -068~~
~~Pt. 44.70 A.~~

Pt. -072
Pt. 35.81 Ac.

SEE SURVEY BY -
LESLIE R. KENT, PS 6627
SEYMOUR D. WEISS & ASSOC.
CL @ 1: 285A 1: 168, 596
PRIOR INST. REF - DV 1356/548

#20913

APPROVED	
LORAIN CO.	
MAP DEPT.	
DATE 6-24-94	
PAGE 3-00-112-B	
BY T. McMain	
VOID AFTER	20913