

NEW LONDON - EASTERN

1972.06

(50)

748.44

1498.56

209
-007
10
100
209

- PARCEL "D" = ACREAGE CORRECTION 7.67 A TO 9.80 A
- PARCEL "A" = ADD TO DUP. 20-03-014-000-009
- PARCEL "B" = ADD TO DUP. 20-03-014-000-008
- PARCEL "C" = ADD TO DUP. 20-03-⁰¹⁵000-000-010
- PARCEL "E" = ADD TO DUP. 20-03-013-000-007

-006
94.91 A.

Drop FROM Dup
20-03-014-000-~~005~~ 005
-001 -002 R
43.00 A. 47.95 A.


2947.56
14

1780.5
1
12.88
A.09 Ac. (A)

#20920-

APPROVED
LORAIN CO.
MAP DEPT.
DATE 4-27-95
PAGE 20-11
BY F. COLBERT
VOID AFTER 20920-X

1498.86

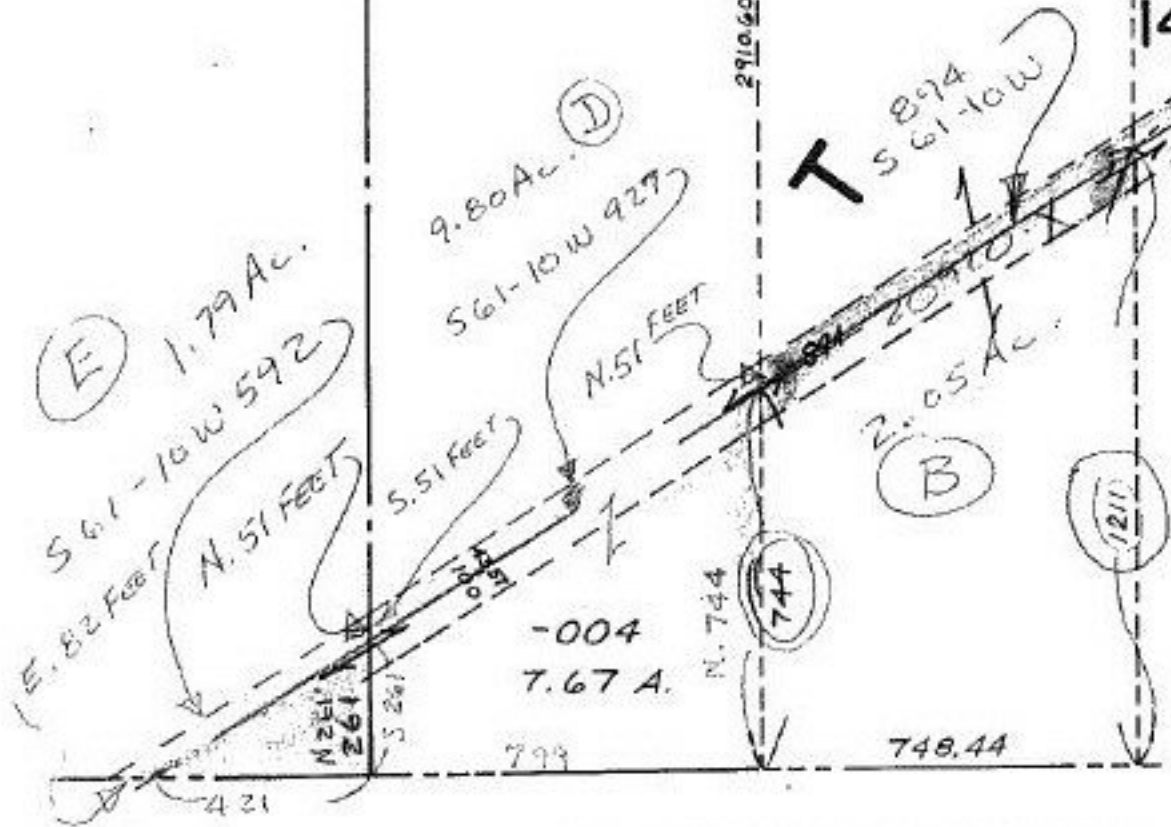

DO NOT COLLECTED TWD