


JONES ST.

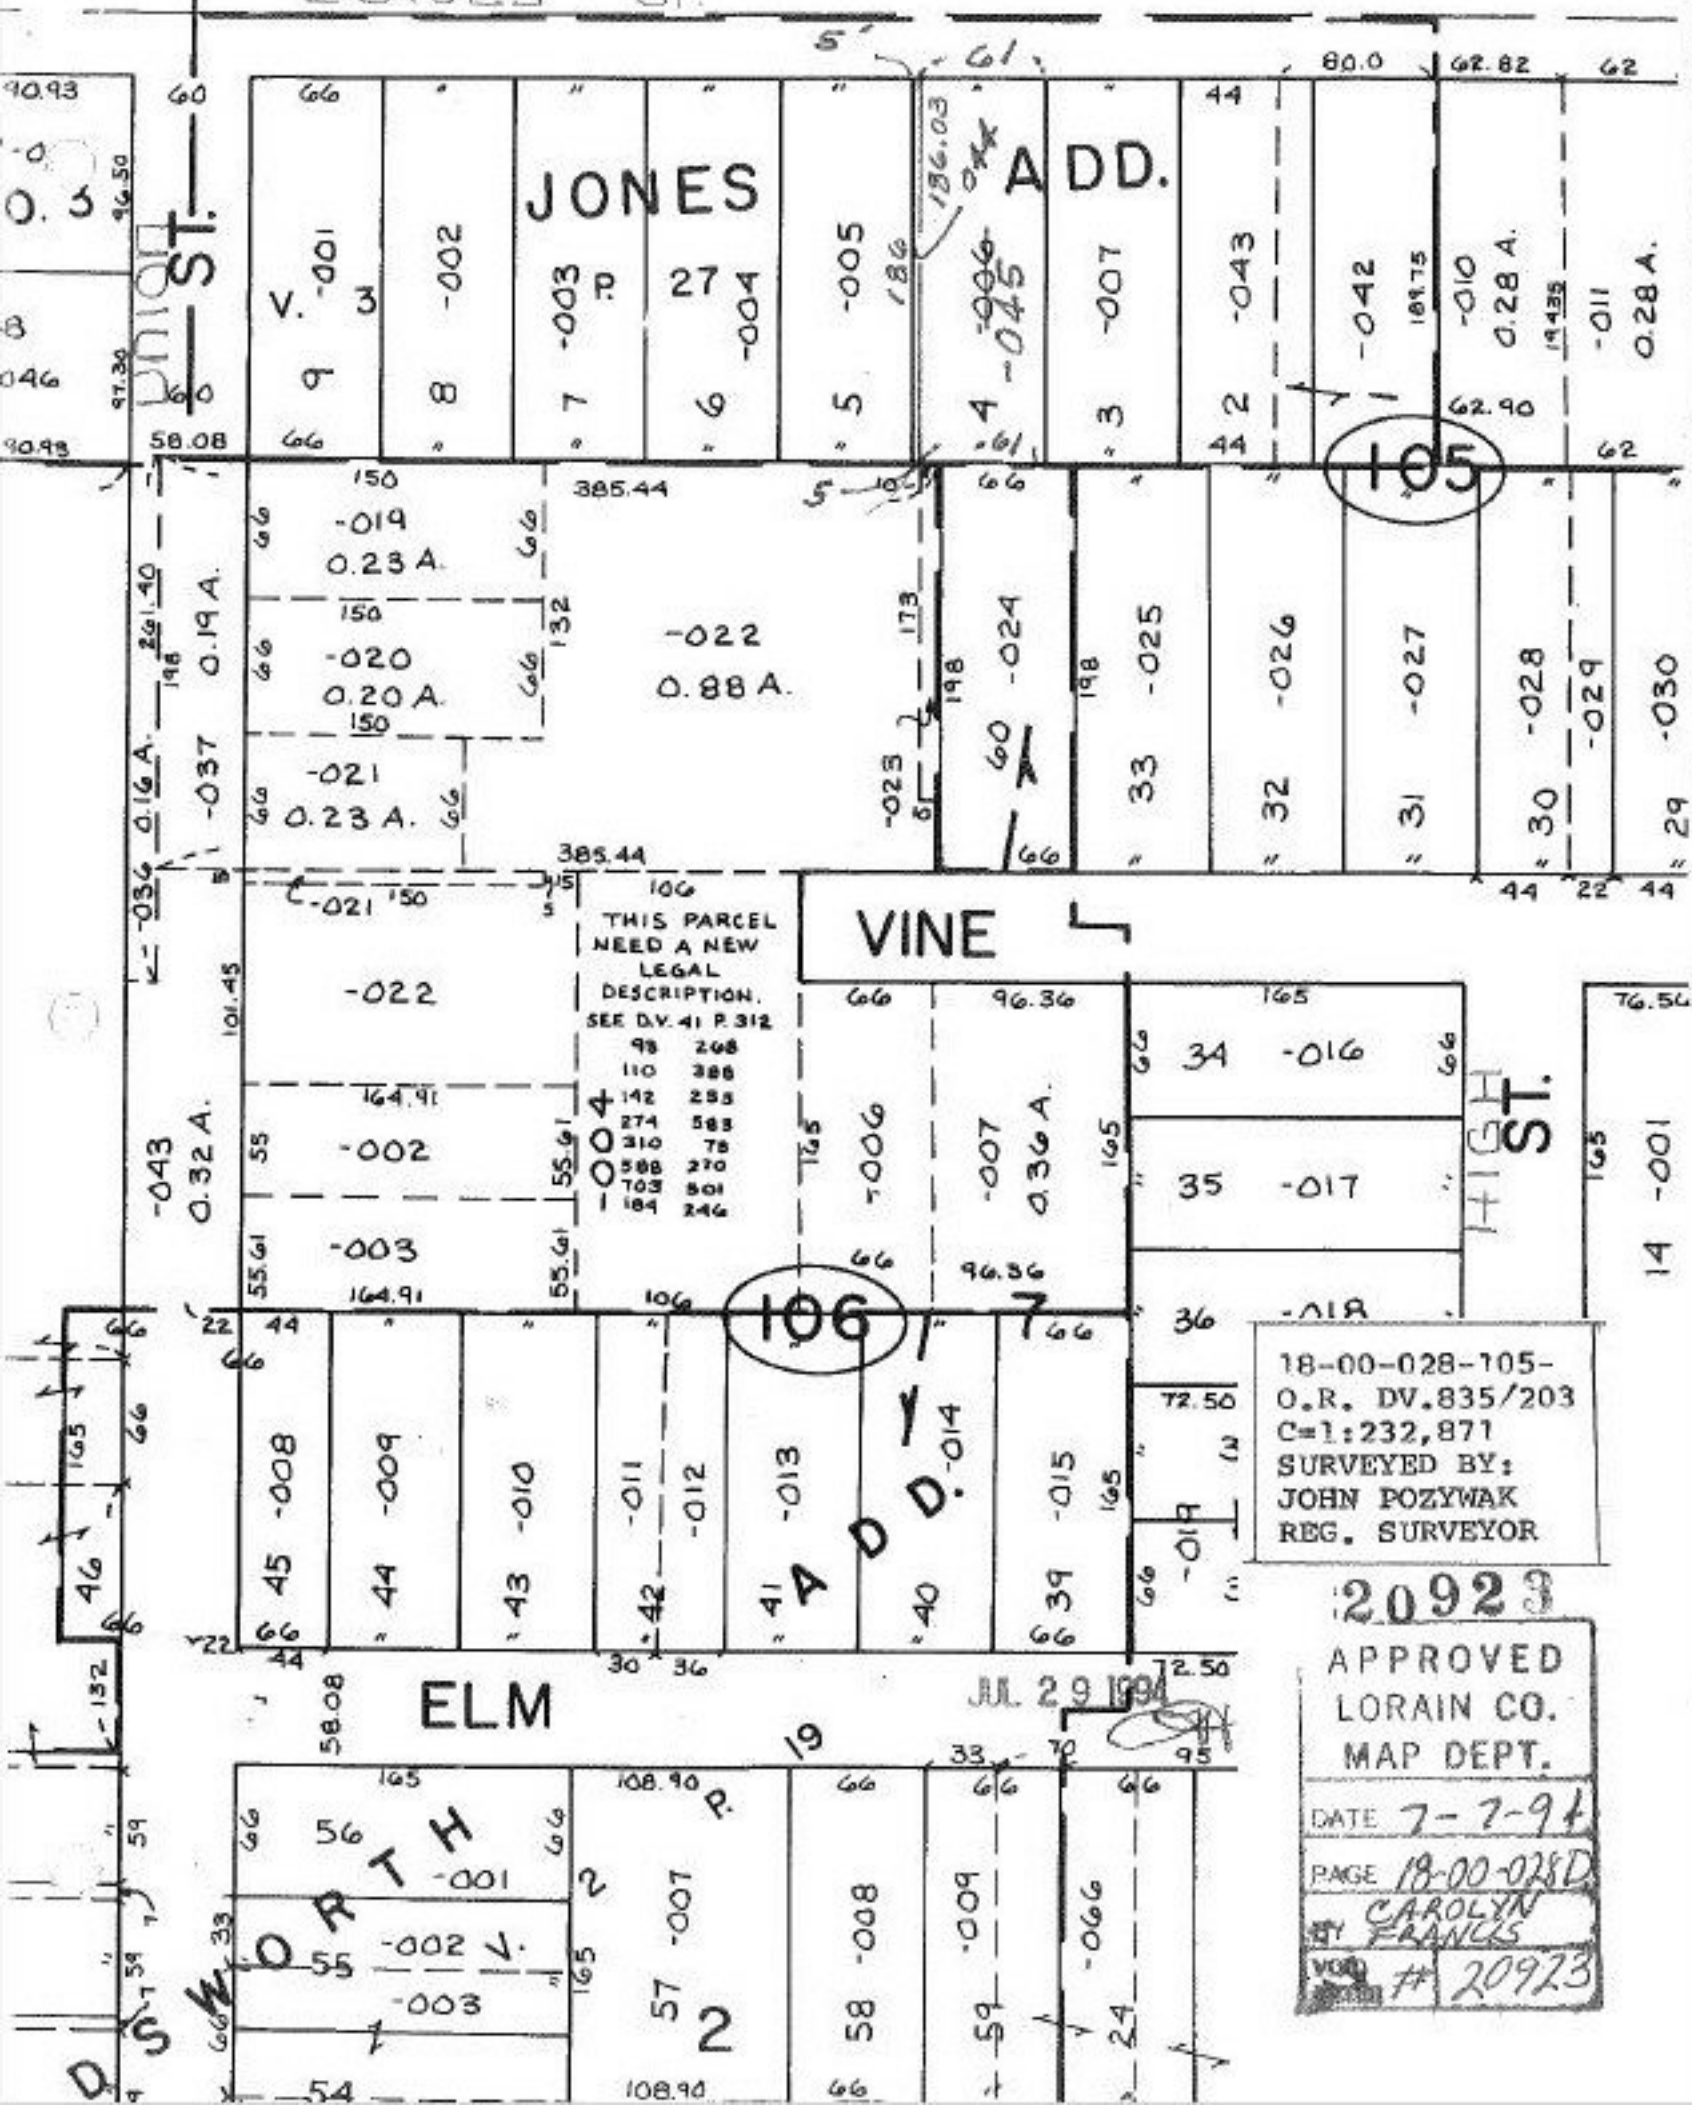

THIS PARCEL
NEED A NEW
LEGAL
DESCRIPTION.
SEE D.V. 41 P. 312

98	298
110	388
142	255
274	583
310	78
588	270
703	801
84	246

18-00-028-105-
O.R. DV.835/203
C=1:232,871
SURVEYED BY:
JOHN POZYWAK
REG. SURVEYOR

2092
APPROVED
LORAIN CO.
MAP DEPT.
DATE 7-7-94
PAGE 18-00-028D
CAROLYN
FRANCIS
20923

JUL 29 1994