


50.87A
1.38 A

49.49A

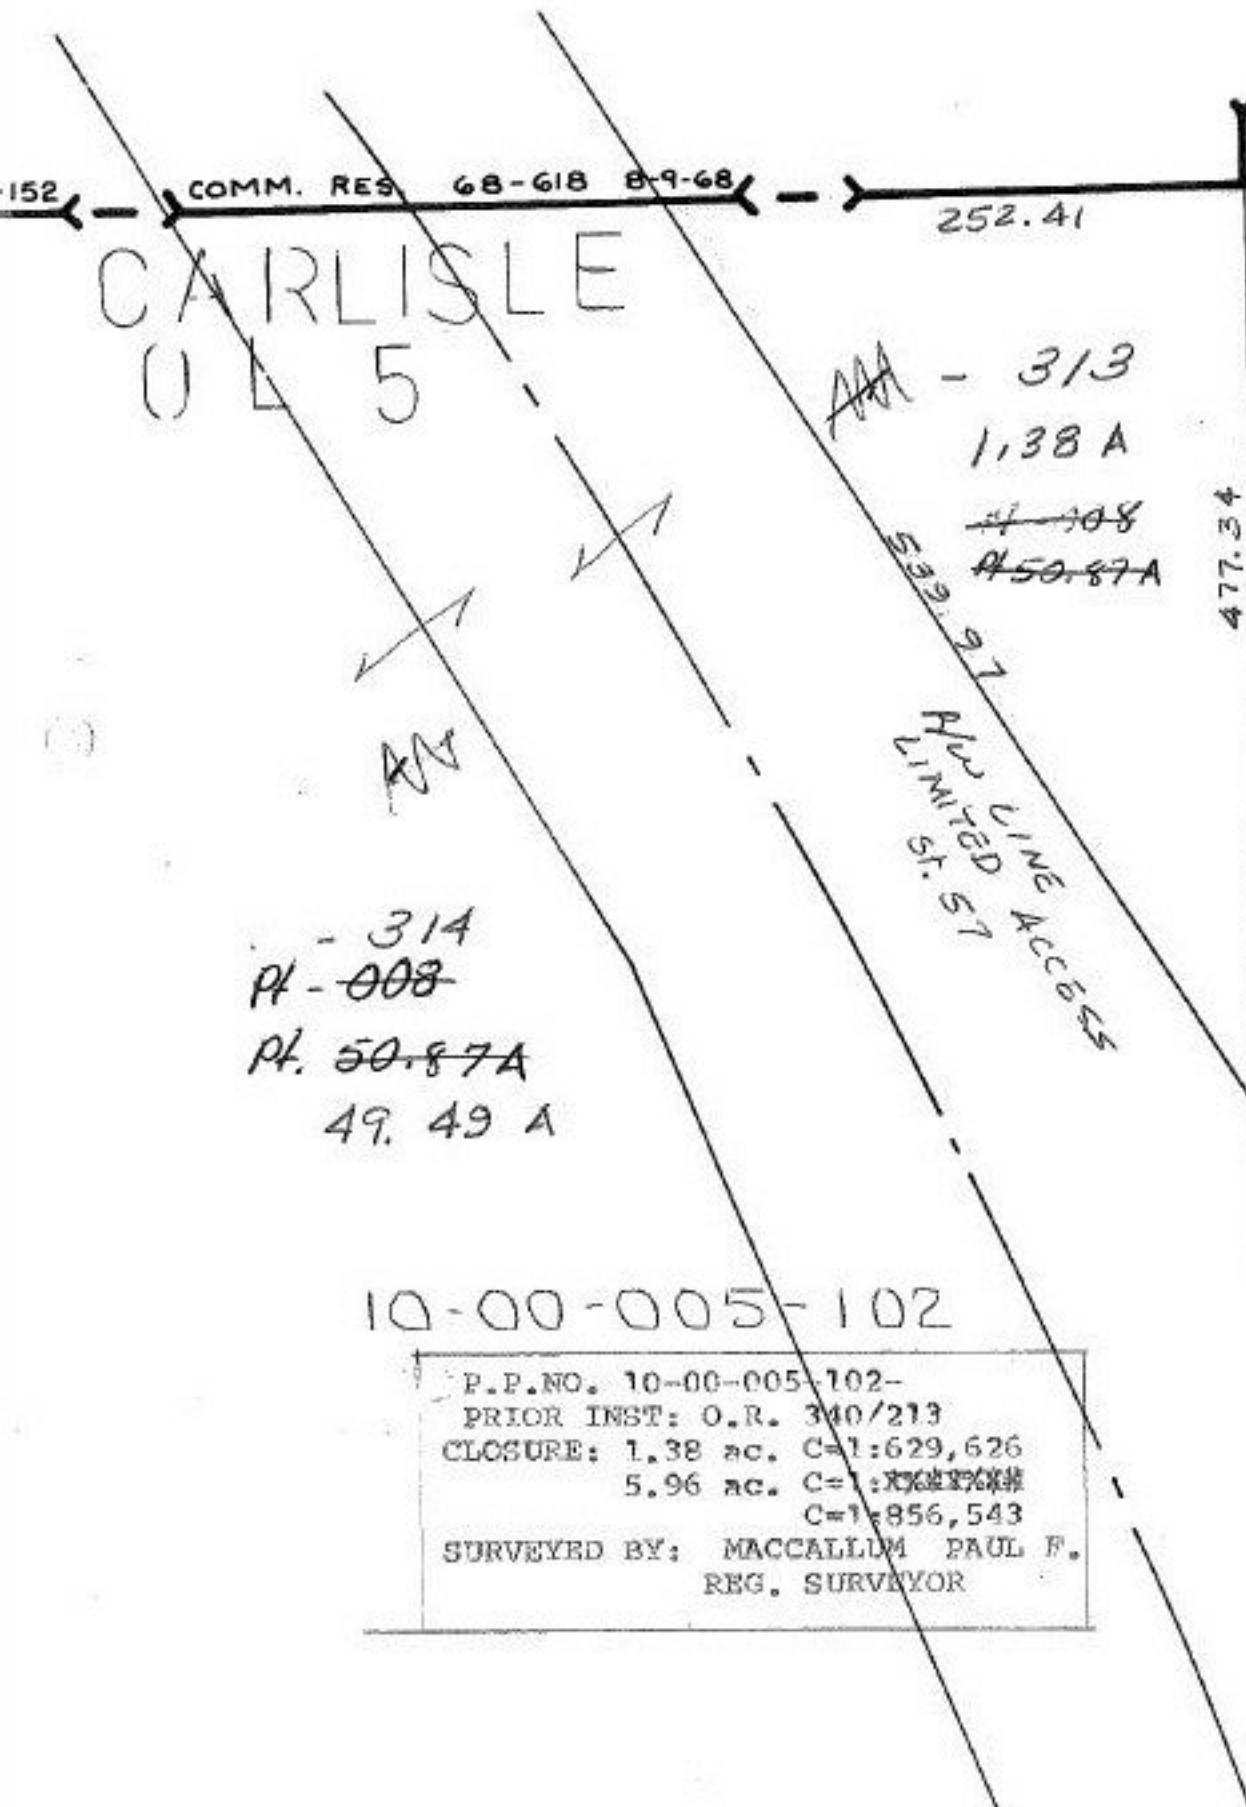

CARLISLE
OLD 5

COMM. RES 68-618 8-9-68

252.41

477.34

~~AAA~~ - 313
1.38 A
~~A-008~~
~~50.87A~~

R/W LINE ACCESS
ST. 5

- 314
A-008
Pt. 50.87A
49.49 A

10-00-005-102

P.P.NO. 10-00-005-102-
PRIOR INST: O.R. 340/213
CLOSURE: 1.38 ac. C=1:629,626
5.96 ac. C=1:856,543
SURVEYED BY: MACCALLUM PAUL F. REG. SURVEYOR

8/19/94
20930

APPROVED LORAIN CO. MAP DEPT.	
DATE 7-8-94	D
PAGE 10-00-005-102	
BY CAROLYN FRANCIS	
WORD NUMBER #	20930

998.99' FROM
INTERSECTION OF NORTH LINE
CHESTNUT RIDGE AND SUB.
EAST LINE D.L.S.