

LATTASBURG - ELYRIA

- 005
40.00 A.


- 001
50.00 A.

*
SEE 20796

- 002
50.00 A.

SEE G. PENFOLD SURVEY
CL 11 757.751
PRIOR INST. ECV. -
PR 916/373

95

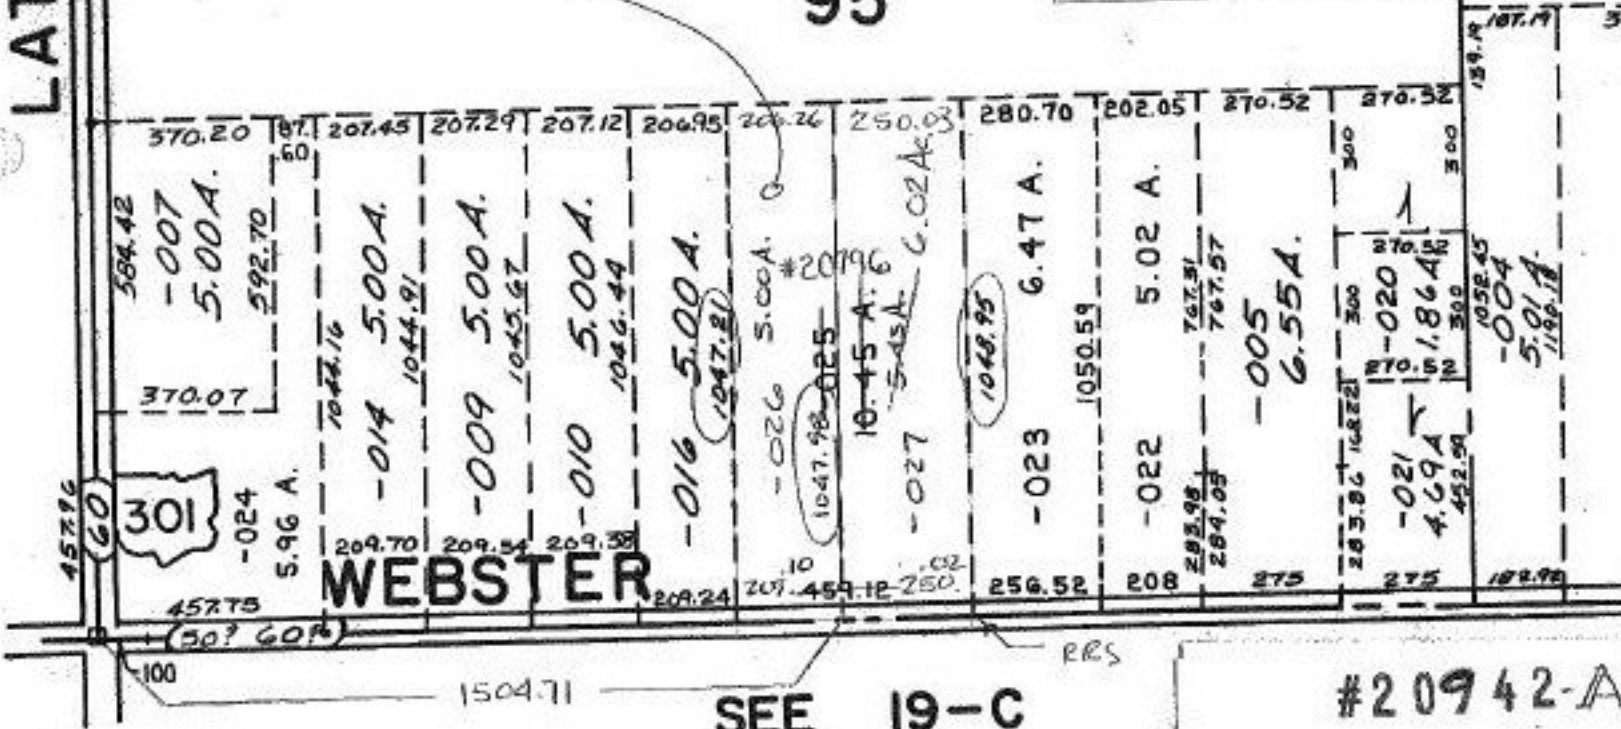

66, 67, 74, 75, 86, 87, 94, 95

ACREAGE
CORRECTION

APPROVED
LORAIN CO.
MAP DEPT.
DATE 7-27-94
PAGE 15-G
BY Tom Main
20942-A