

20960


VOID

1452

1003.95

30.19
14.60

93
~~-017~~
~~015~~ ~~013~~
 -014
 245.44 A.
 243.44 Ac.
 242.13 Ac.
 244.44
 243.13 A
 243.44 A
 1.81 H
 242.13

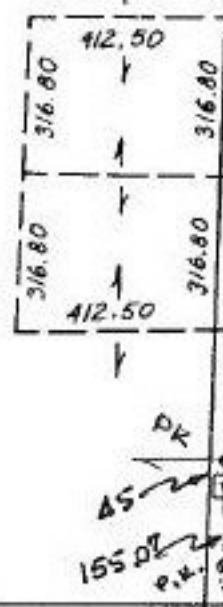

VOID NOT FILE
 DID NOT FILE
 # SPLIT NO.
 20810

PARCEL
 -014
 015 NOT USED
 SPLIT #20810
 VOIDED

P.P. NO. 05-00-093-000-
 PRIOR INST: O.R. 635/750
 CLOSURE: 1.81 Ac. C-1: 6/7, 949
 SURVEYED BY: K.S.A.

QUARRY 974.82

20960

APPROVED
LORAIN CO.
MAP DEPT

DATE 7-21-94

PAGE 5-E

BY CAROLYN
FRANCIS

20960

-018
6.68 A.

92

CORP

1510.98

110.45

162.91
182.5
264
264

4290
30.01

804.34

-C
5.2