


ORDINANCE NO. 94-128

AN ORDINANCE VACATING A PORTION OF AN UNNAMED ALLEY IN THE CITY OF "ELYRIA", OHIO

SITUATED IN THE CITY OF ELYRIA, COUNTY OF LORAIN, AND STATE OF OHIO, BEING KNOWN AS PART OF BLOCK NO. 85 IN HEMAN ELY'S ORIGINAL TOWN PLAN OF ELYRIA AS RECORDED IN VOLUME 3, PAGE 14 OF LORAIN COUNTY PLAT RECORDS.

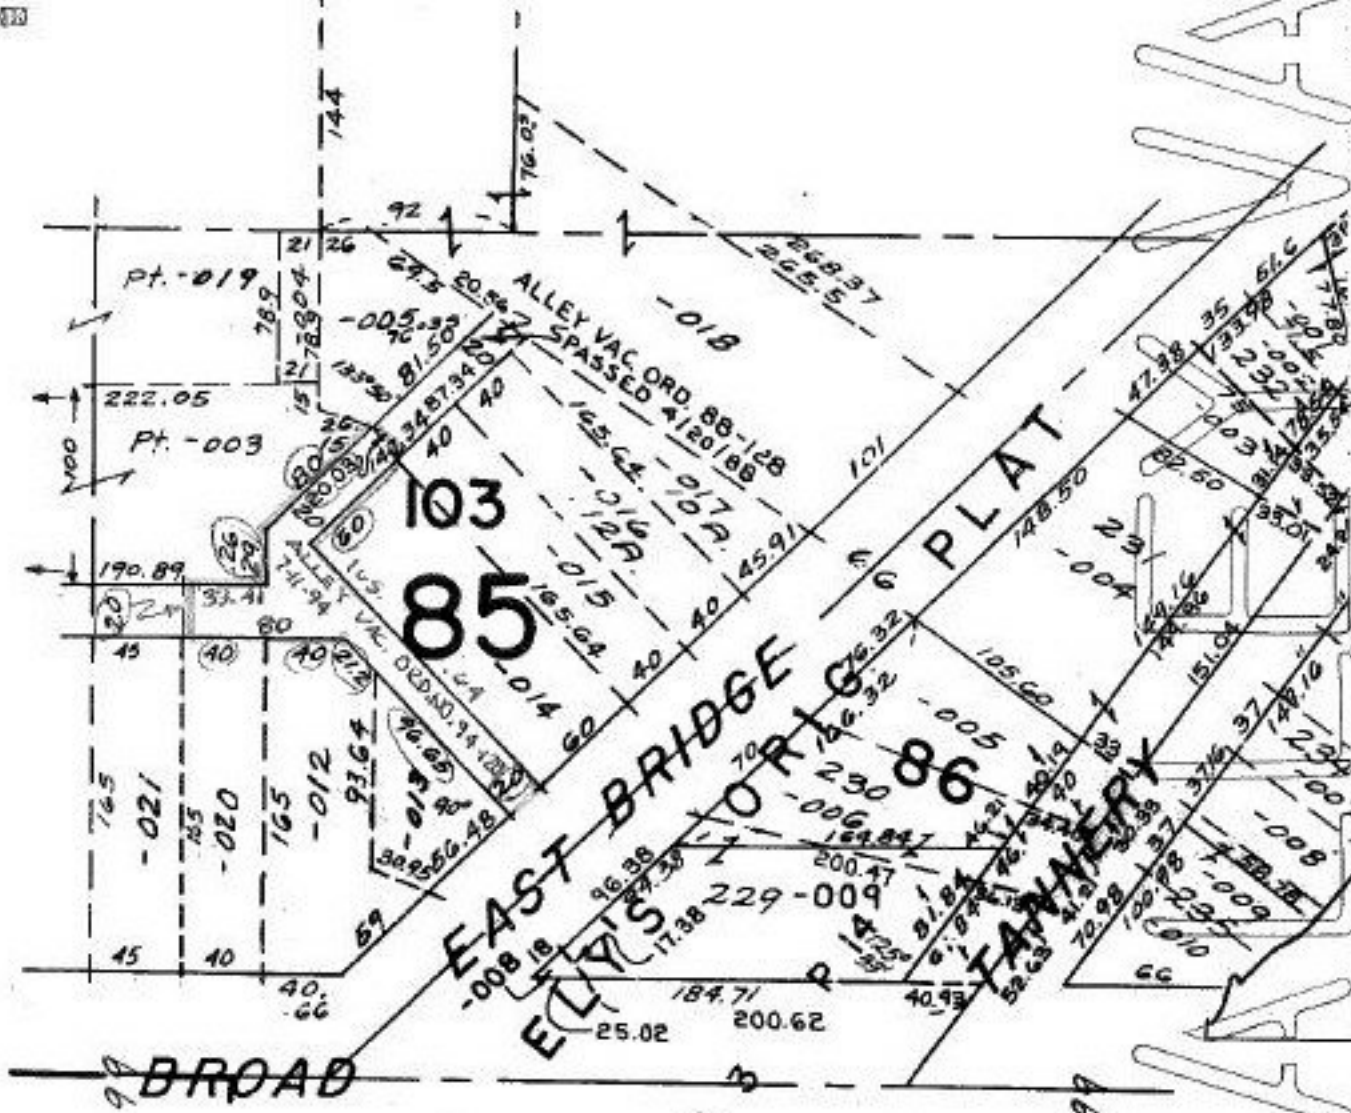

BROAD

EAST BRIDGE STREET

HEMAN

61

9-12-94
20968-V

APPROVED LORAIN CO. MAP DEPT
DATE 8-2-94
PAGE 6-121
BY CAROLYN FRANCIS