


-093
~~-043~~
 29.60 A.
 28.67A.

29.60 A 0.93 A
 0.93 A 1.67 A
 28.67 A 2.60 A
 13.03 A
 1.67 A
 11.36 A

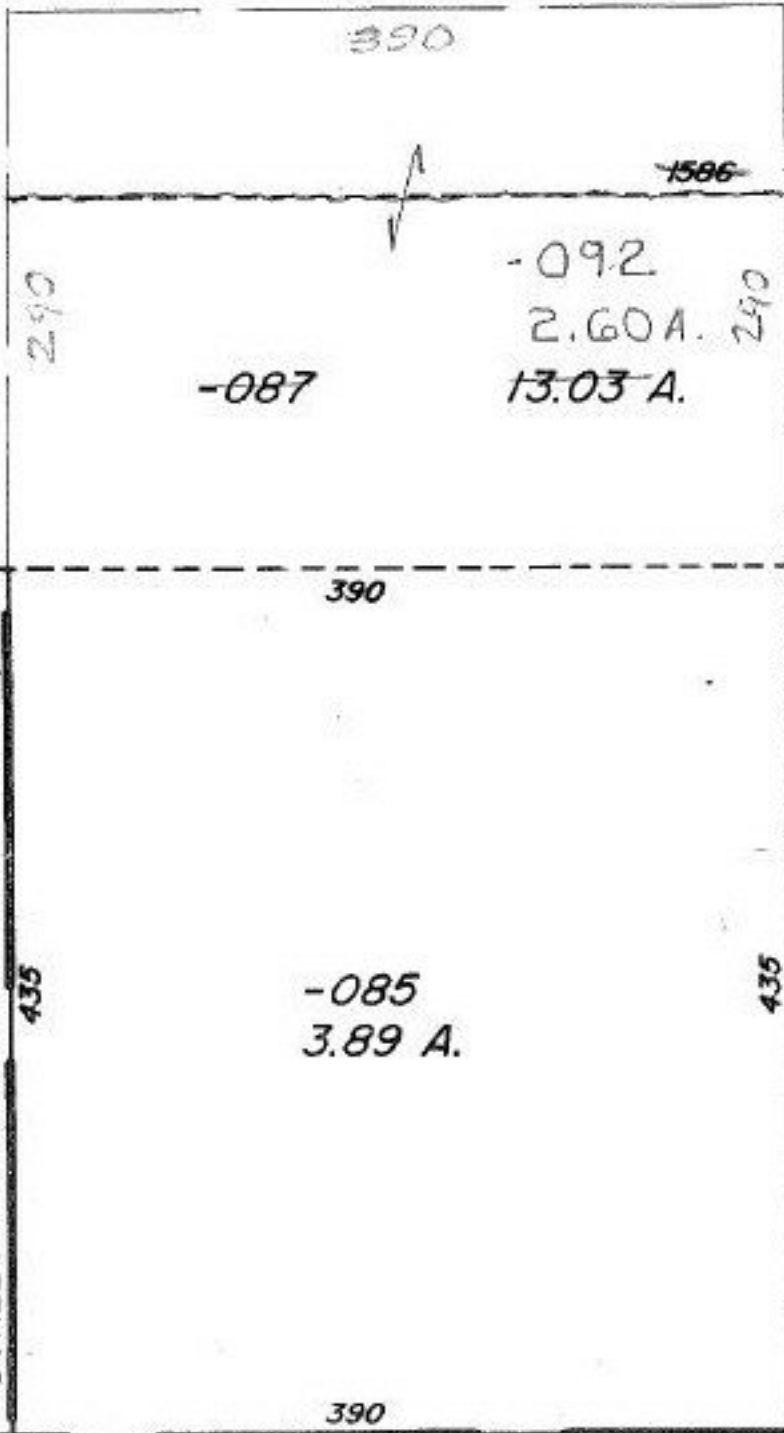

1586
 094
 11.36 A

P.P. NO. 18-00-020-000-
 PRIOR INST: DV. 1396/747
 CLOSURE: 1:3,859,645
 SURVEYED BY: POGGEMEYER
 DESIGN GROUP, INC.

SM 9-1-94
 20971

APPROVED
 LORAIN CO.
 MAP DEPT
 DATE 8-1-94
 PAGE 18-00-020-D
 BY CAROLYN
 FRANCIS
 # 20971

INDUSTRIAL 900 -001 0.60 A. AVE.
 STREET DEDICATION PLAT P.V. 45, P. 9

80 60 390
 -001 35 Pt. 4.09 A.
 ON PLAT VOL. 42, PG. 55