

SEE 4-00-028-E

42.60

101.12

CHESTER

183.48

32A

1299.11

45.63

111.12

1
1

371.68

419.27

XV


2099

(Signature)

APPROVED
 LORAIN CO.
 MAP DEPT.
 DATE 10-3-68
 4-00-028-F
 BY
R. J. Kelling

7-14-86 L.L.

Done

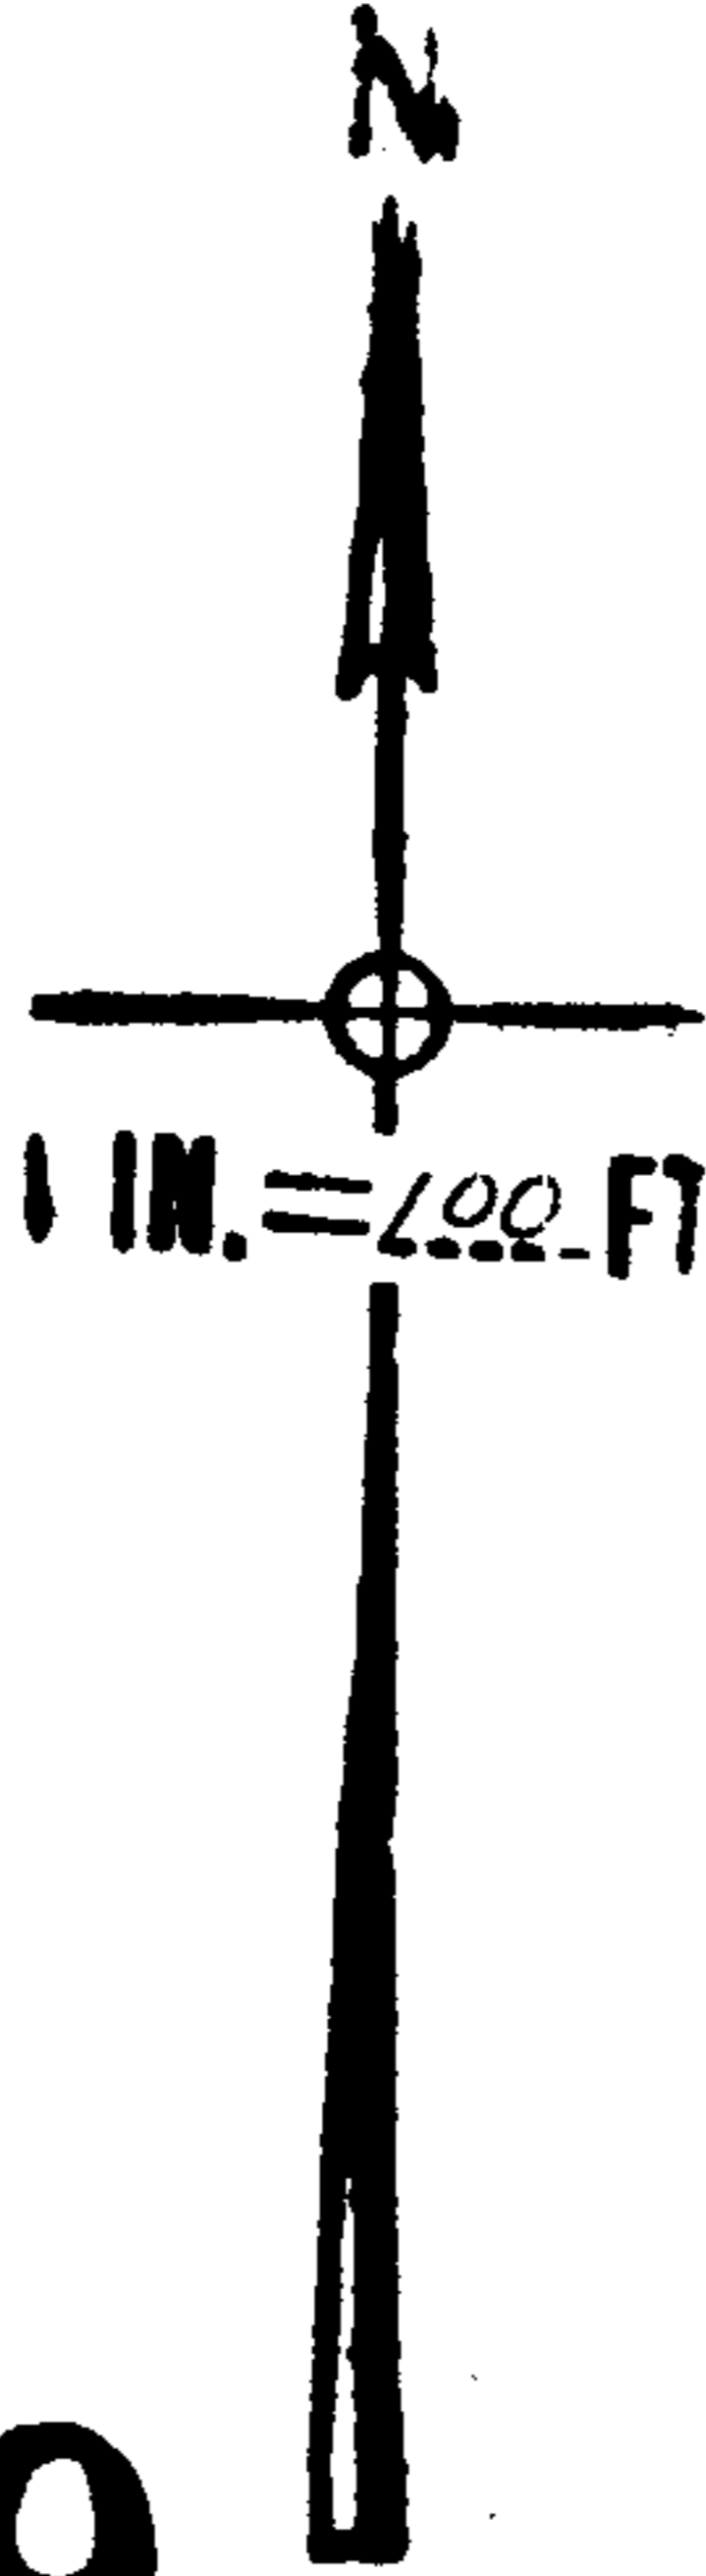

-051
20.31 A.

~~-021~~
~~20.63 A.~~

1187.03

-022
3.00 R.

1175.68

-023
8.45 A.

101

2