


GARFIELD RD

RD.

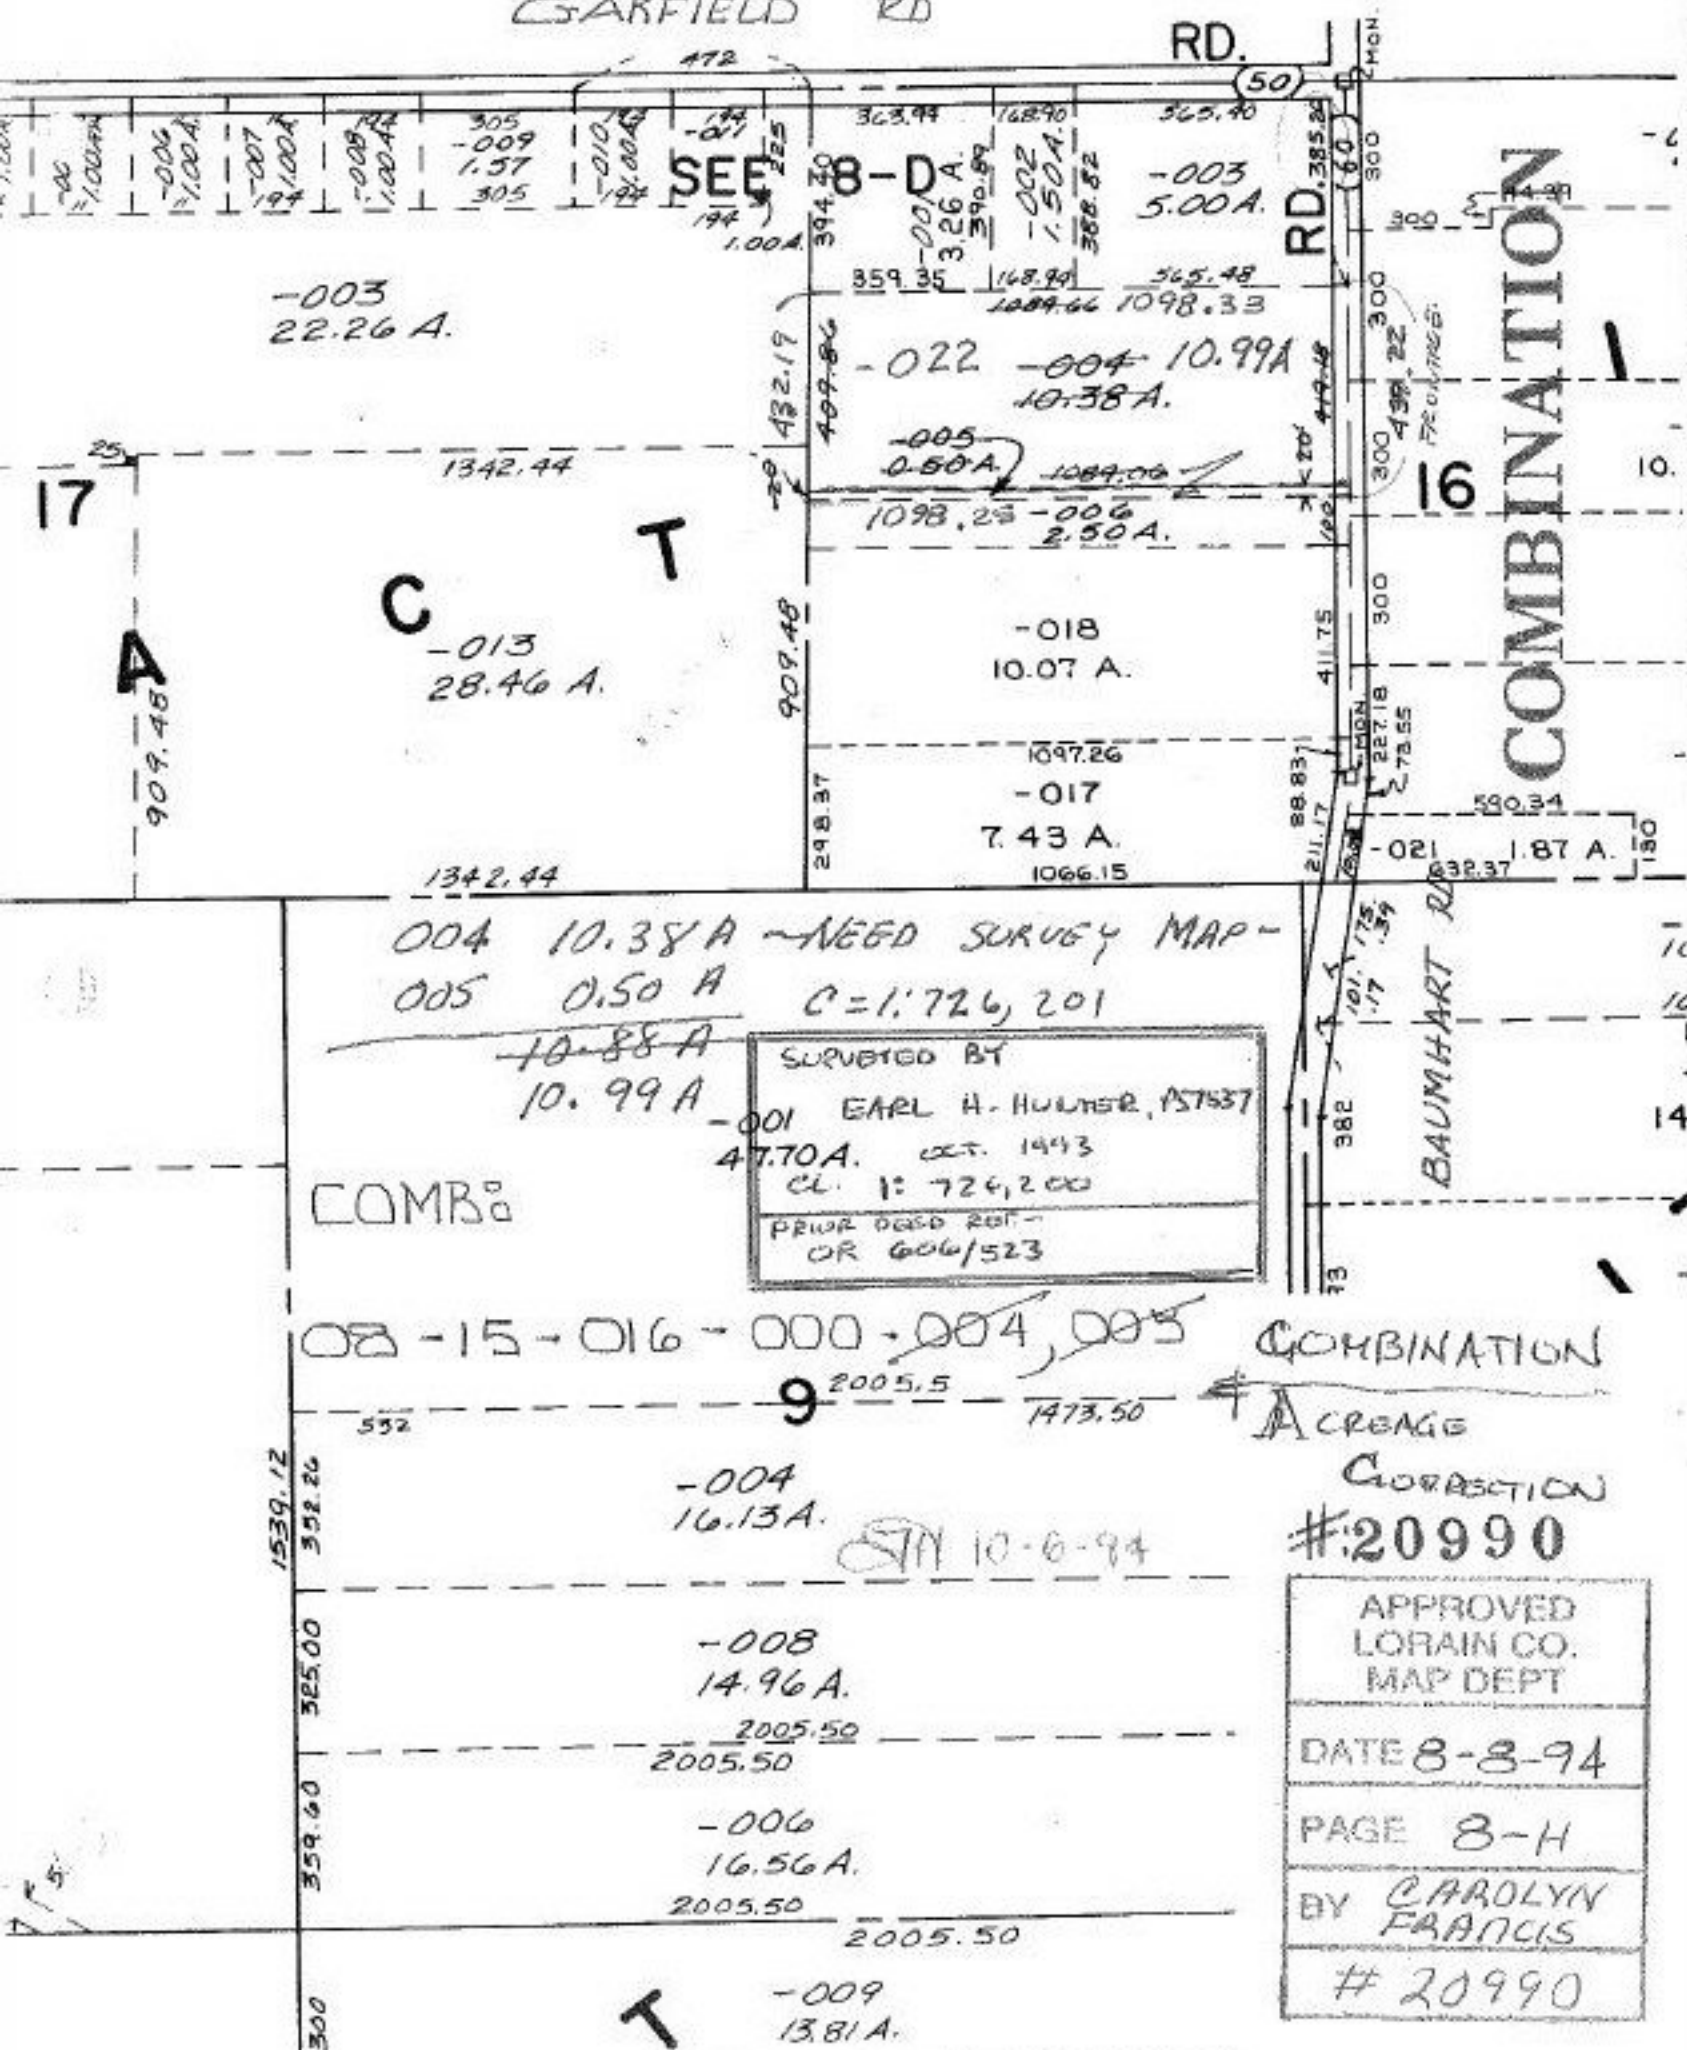

17

909.48

C

T

-003
22.26 A.

-013
28.46 A.

-018
10.07 A.

-017
7.43 A.

004 10.38 A - NEED SURVEY MAP -
 005 0.50 A C=1:726, 201
 10.88 A
 10.99 A

SURVEYED BY
 EARL H. HULTER, PST537
 47.70 A. OCT. 1993
 CL. 1: 726, 200
 PRIOR DEED REF -
 OR 606/523

COMB

08 - 15 - 016 - 000 - 004, 005 COMBINATION
 9 2005.5 1473.50
 532

ACREAGE
 CORRECTION
 #20990

-004
16.13 A.

STA 10-6-94

-008
14.96 A.

2005.50
2005.50

-006
16.56 A.

2005.50
2005.50

-009
13.81 A.

T

APPROVED
 LORAIN CO.
 MAP DEPT
 DATE 8-3-94
 PAGE 8-H
 BY CAROLYN
 FRANCIS
 # 20990

COMBINATION

BAUMHART RD

RD. 385.28

411.75

211.17

382

73

RD.

50

RD.

60

RD.

70

RD.

80

RD.

90

RD.

100

RD.

110

RD.

120

RD.

130

RD.