


2.24 A.

20998

SEE 6-X

CITY  
RES. 94-360 5/5/94  
TWP 356.98 CITY RES. 94-360 5/5/94  
388.56

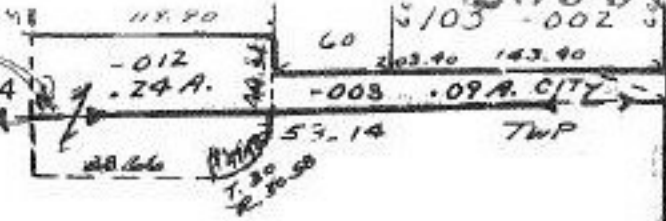

# 24 ANNEXATION FROM ELYRIA TWP TO ELYRIA CITY

RES NO. 94-360 MAY 5 1994

PARCEL INVOLVED:

06-24-013-000-003	0.07 A.
- 004	0.02 A
06-24-013-000-005	0.08 A
06-24-024-109-016	12.64 A
- 021	0.41 A
- 022	10.63 A
- 023	0.68 A
06-24-024-109-024	1.13 A

022  
10.63 A

ORD. 94-185 PASSED 8/15/94  
RES. 94-360 AINSD 5/5/94 CITY

2119.99

PARCEL LINE  
ELYRIA CITY LINE

TAKE OUT CORP LINE - PUT IN

1520  
CITY RES 94-360 AINSD 5/5/94  
COUNTY P.  
ORD. 94-185 PASSED 8/15/94

109

Pt. 016  
Pt. 12.64 A.

1519.80

20996X

APPROVED LOFIAN CO. MAP DEPT
DATE 10-7-94
FORM G-77
BY CAROLYN FRANCIS
20996X