


SEE 7-00-011-B

0.74 A	Comb	0.17 A
0.57 A	047	1.09 A
0.17 A	039	1.26 A
<hr/>		
		1.26 A

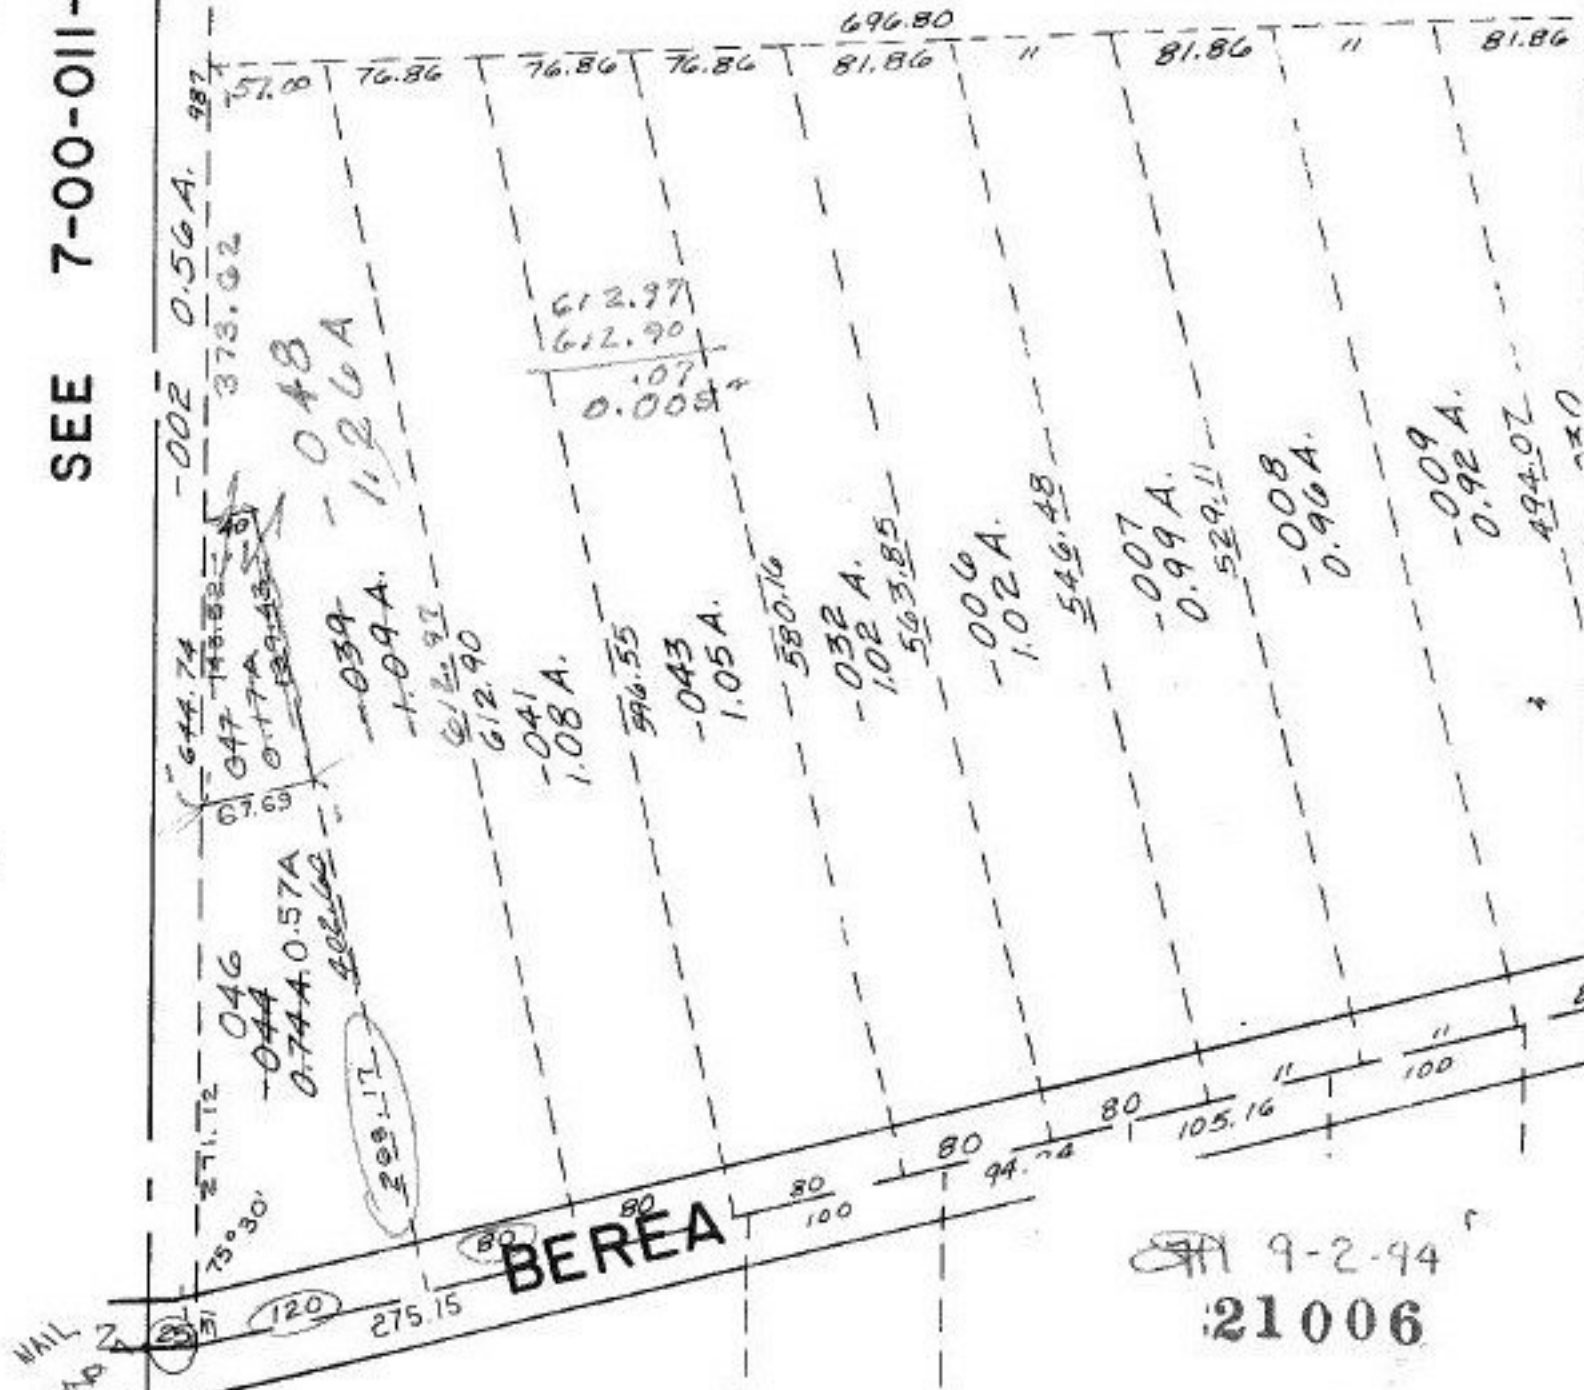

9-2-94  
21006

APPROVED LORAIN CO. MAP DEPT
DATE 8-16-97
PAGE 7-00-002A
BY CAROLYN FRANCLIS
# 21006