


(LAGR)

TOTAL OF
REAR DIMENSIONS
112-W DIMENSIONS
ARE SURVEY

224.66(134.71)

LAGRANGE RD.

VILLAGE
RES. 86-78
3-6-86

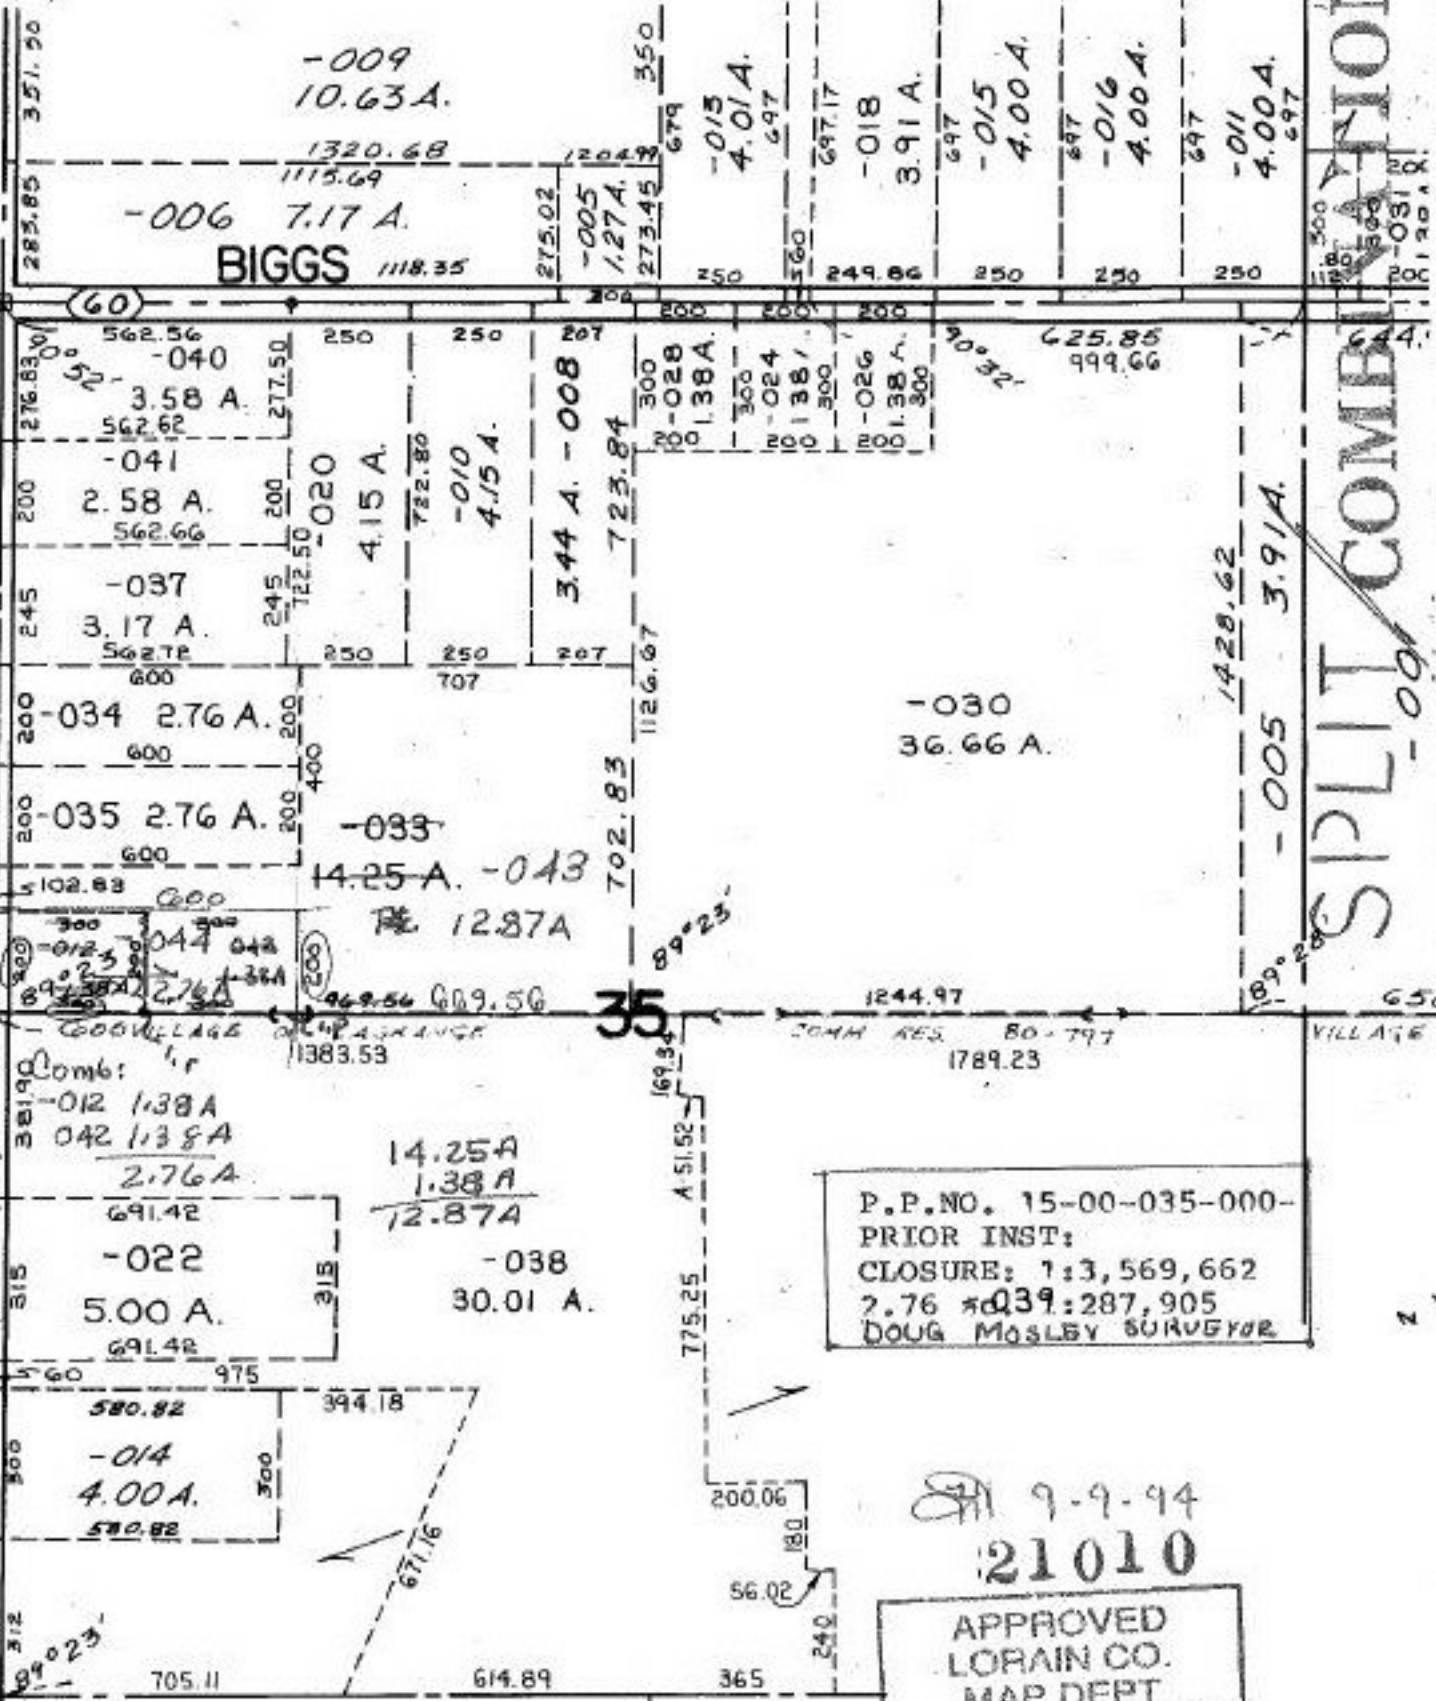

P.P. NO. 15-00-035-000-
 PRIOR INST:
 CLOSURE: 1:3,569,662
 2.76 *039:287,905
 DOUG MASLEY SURVEYOR

9-9-94
 21010
 APPROVED
 LORAIN CO.
 MAP DEPT
 DATE 8-18-94
 PAGE 15-C
 BY CAROLYN
 FRANCIS
 #21010

A