


21018

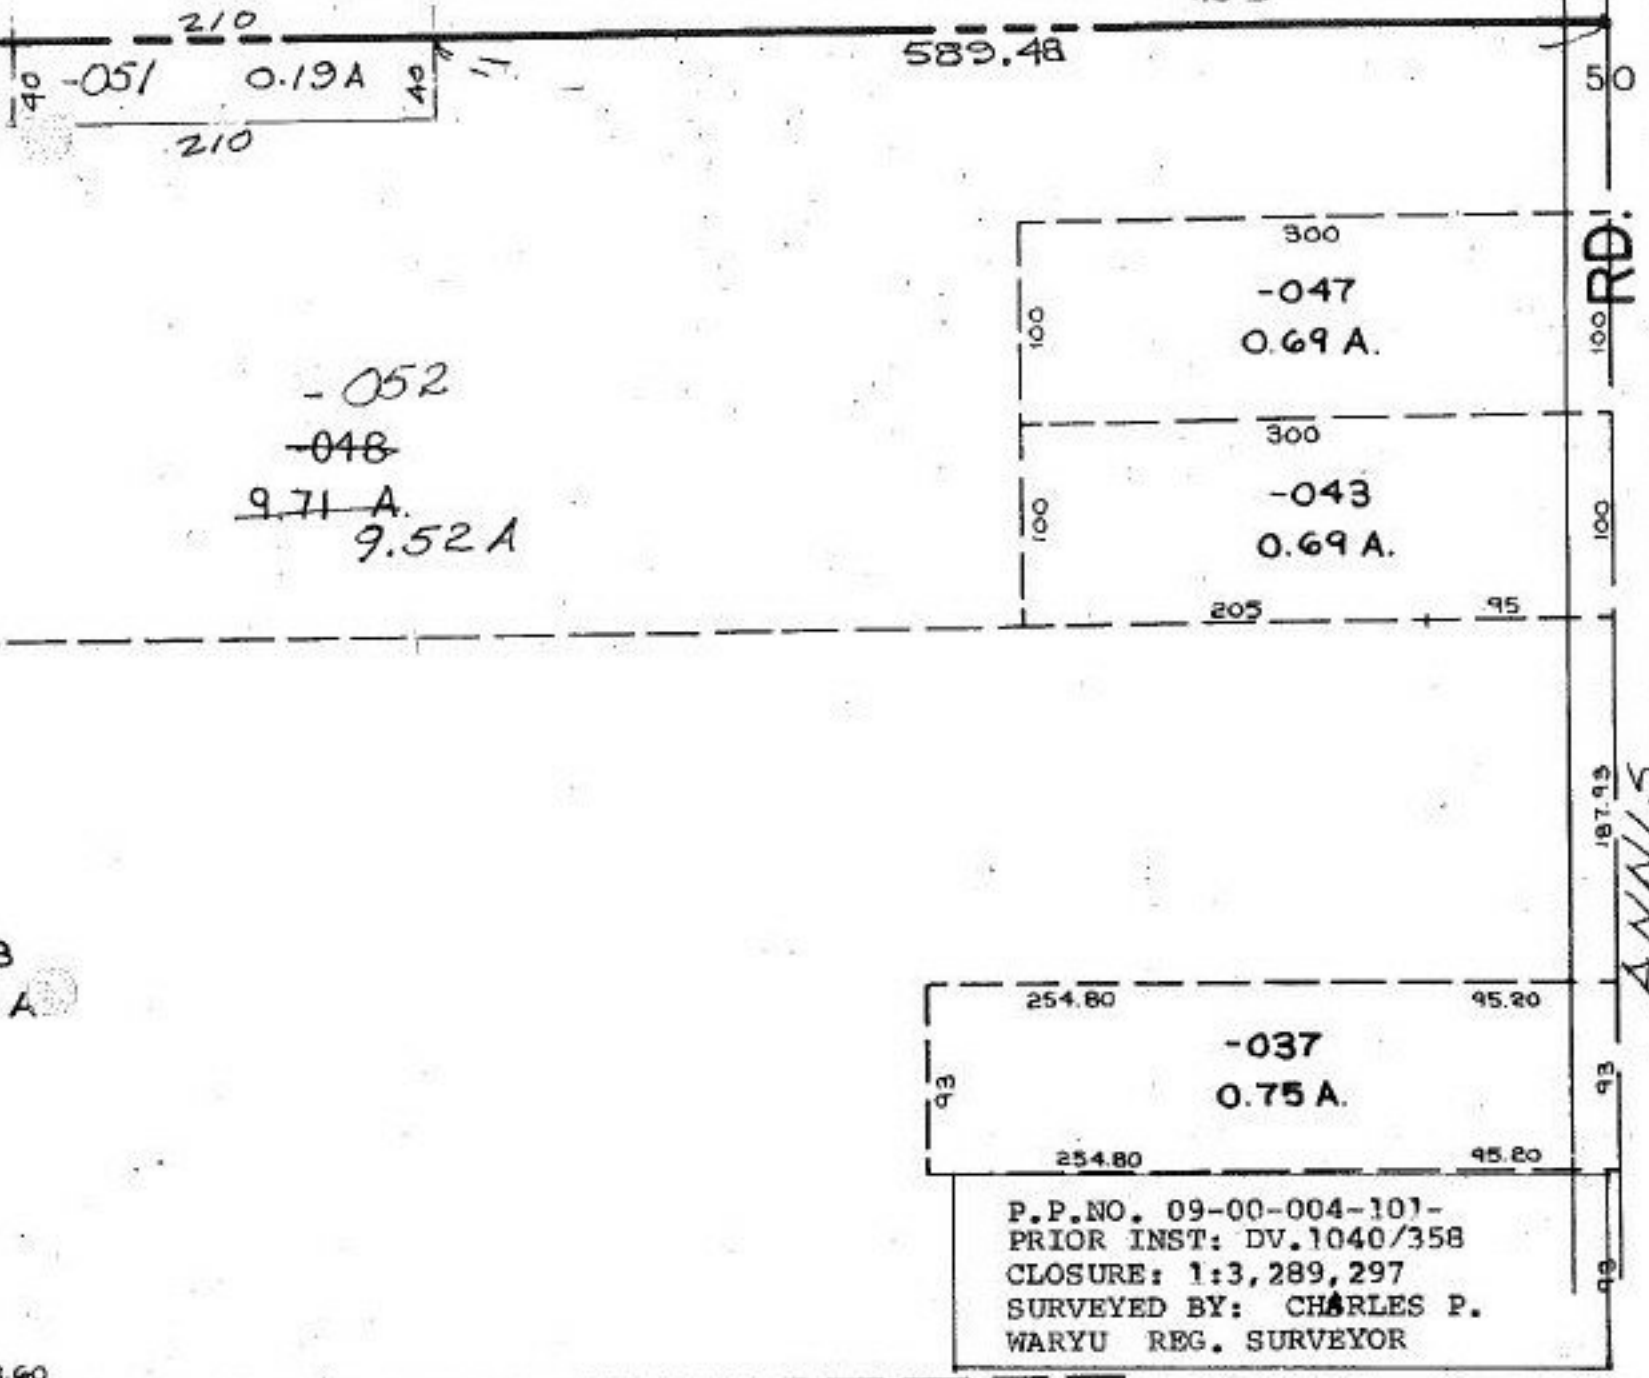

P.P. NO. 09-00-004-101-
 PRIOR INST: DV.1040/358
 CLOSURE: 1:3,289,297
 SURVEYED BY: CHARLES P.
 WARYU REG. SURVEYOR

21018

APPROVED LOCAL CO. MAINT DEPT
DATE 8-22-94
PAGE 9-00-004 A
BY CAROLYN FRANCIS
21018