


# GRISWOLD

ANNEXATION DATA  
COMM. RES. CITY ORD.  
66-466 66-174

50  
140  
36

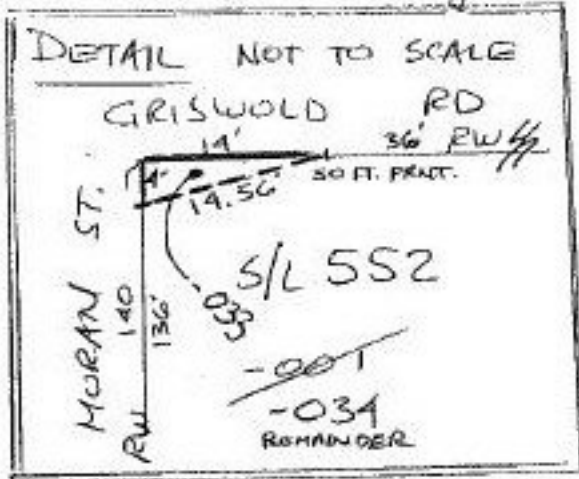

|     |           |           |           |           |           |           |           |           |           |           |
|-----|-----------|-----------|-----------|-----------|-----------|-----------|-----------|-----------|-----------|-----------|
| 50  | 583 - 013 | 552 - 001 | 553 - 002 | 554       | 555       | 556 - 005 | 557       | 558 - 006 | 559 - 007 | 560 - 008 |
| 140 | 140       | 140       | 140       | 280       | 280       | 100       | 100       | 100       | 100       | 100       |
| 50  | 582 - 014 | 581 - 032 | 580       | 579 - 017 | 578 - 018 | 577 - 019 | 576 - 020 | 575 - 021 | 574 - 022 | 573 - 023 |

HEIGHTS

|        |        |           |        |        |        |           |        |           |           |
|--------|--------|-----------|--------|--------|--------|-----------|--------|-----------|-----------|
| 50     | 584    | 585       | 586    | 587    | 588    | 589 - 043 | 590    | 591 - 008 | 592 - 009 |
| 140    | 140    | 140       | 140    | 140    | 140    | 140       | 140    | 140       | 140       |
| 50     | 615    | 614 - 037 | 613    | 612    | 611    | 610       | 609    | 608 - 021 | 607 - 022 |
| 146.86 | 147.51 | 148.19    | 148.85 | 149.52 | 150.18 | 150.84    | 151.51 | 152.18    | 152.84    |

49th

LEONA

MORAN

MIDWAY TWP. TR. 9/13/65  
CITY ORD. 67-37

31

P.P.NO. 06-24-031-105-  
PRIOR INST. 835/131

21025 (PT.-00  
APPROVED LORAIN CO. MAP DEPT  
DATE 8-26-94  
PAGE 6-47  
BY CAROLYN FAARLIS  
21025