


VOID
21036

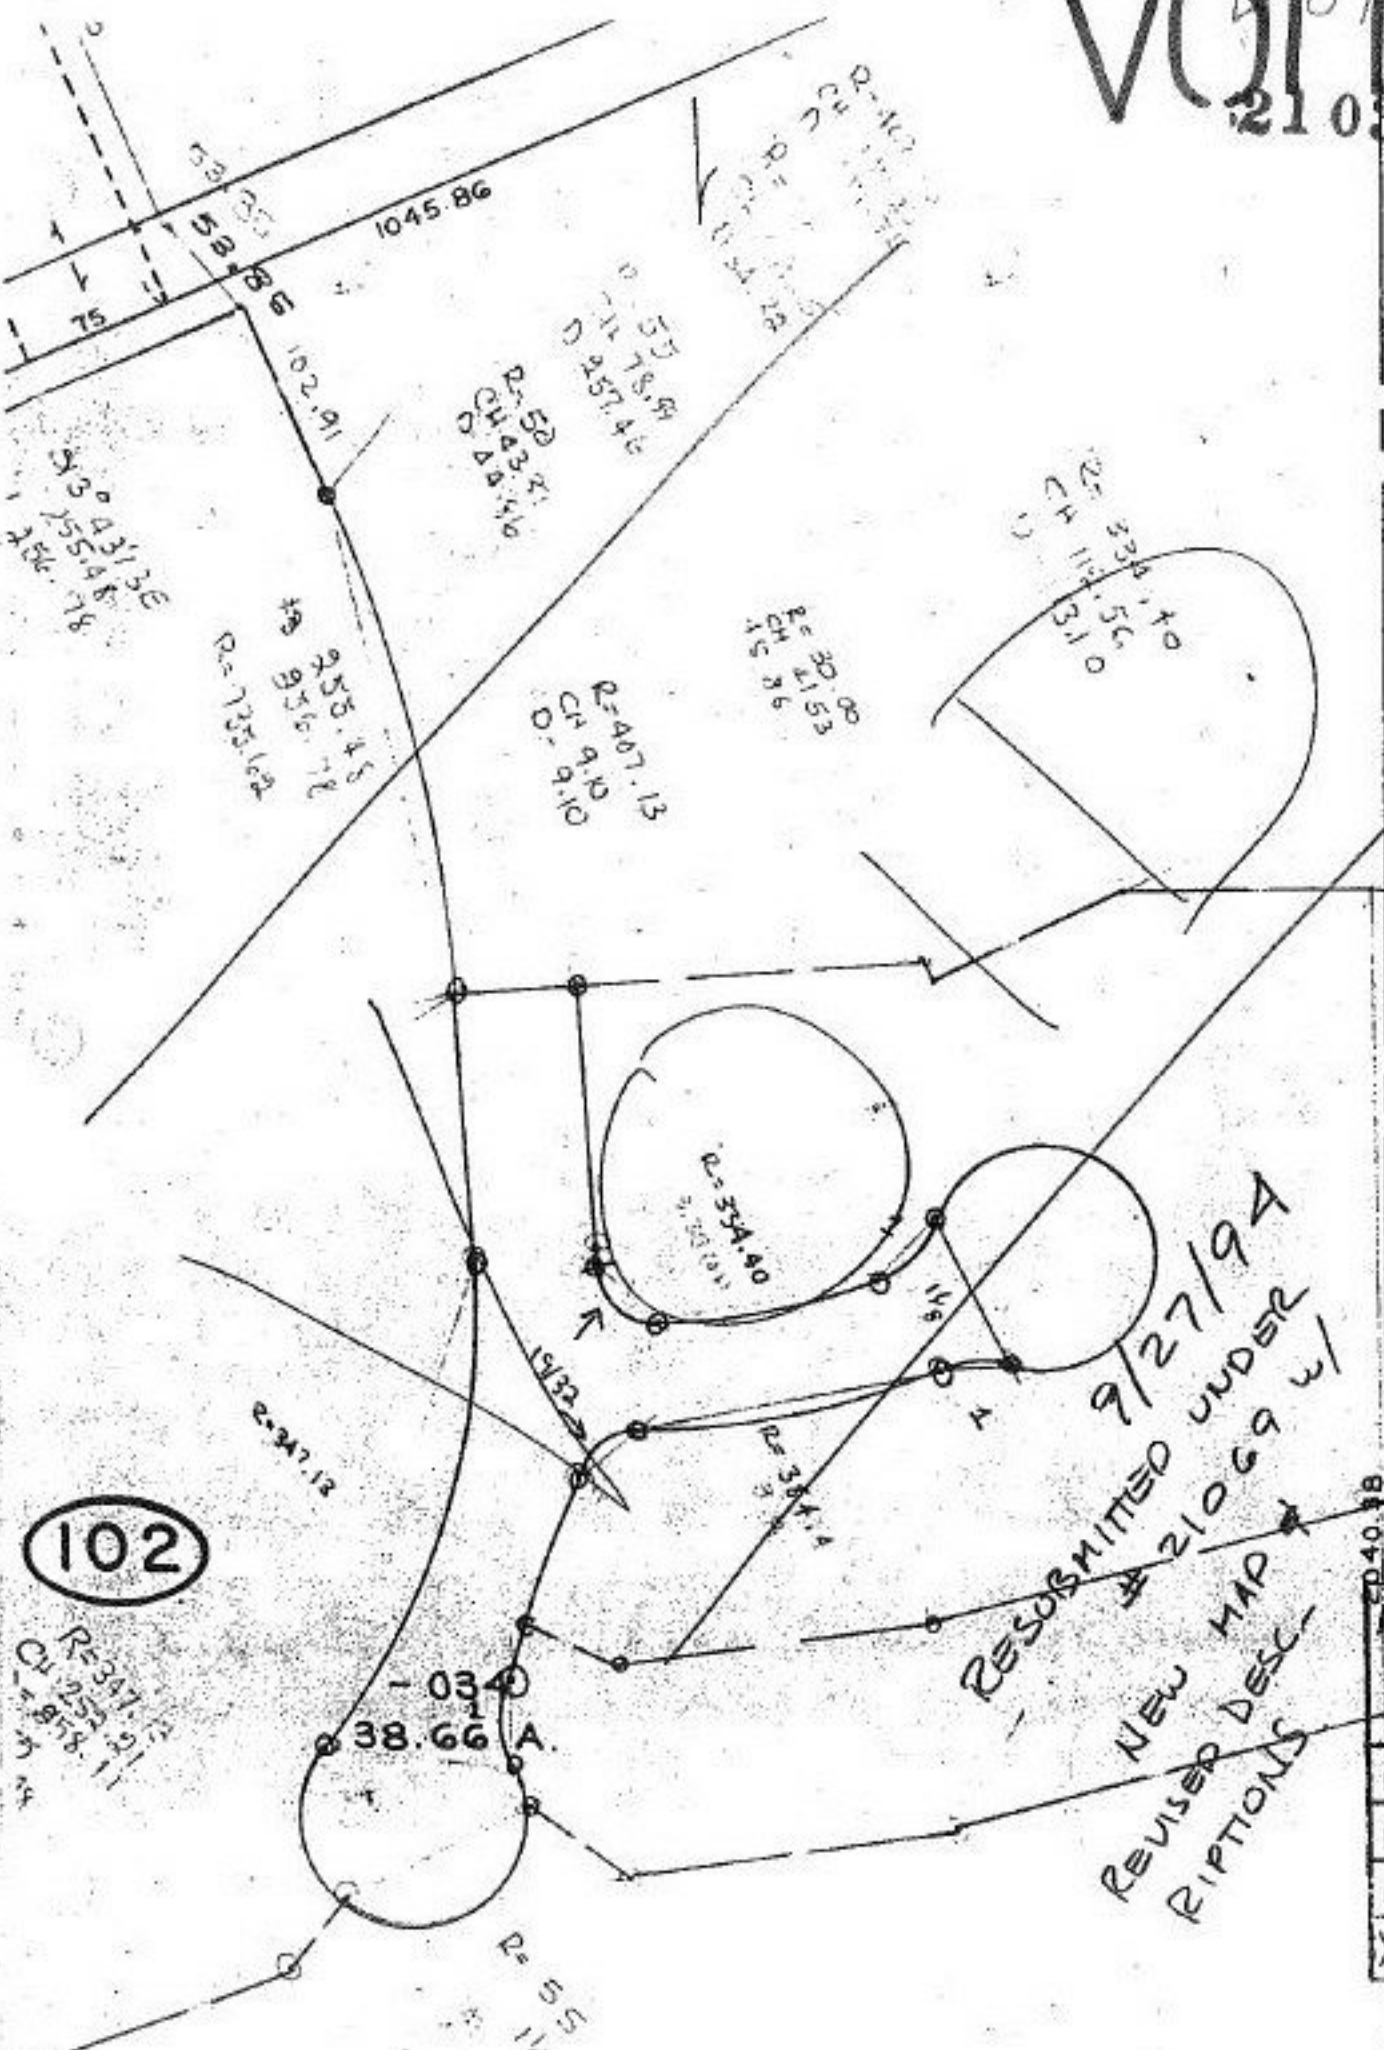

SEE 3-00-044

#21036

APPROVED LORAIN CO. MAP DEPT.	
DATE 9-27-94	
PAGE 3-00-045	
BY T. McMain	
VOID AFTER	21036