


676

21038X

RISWOLD RD

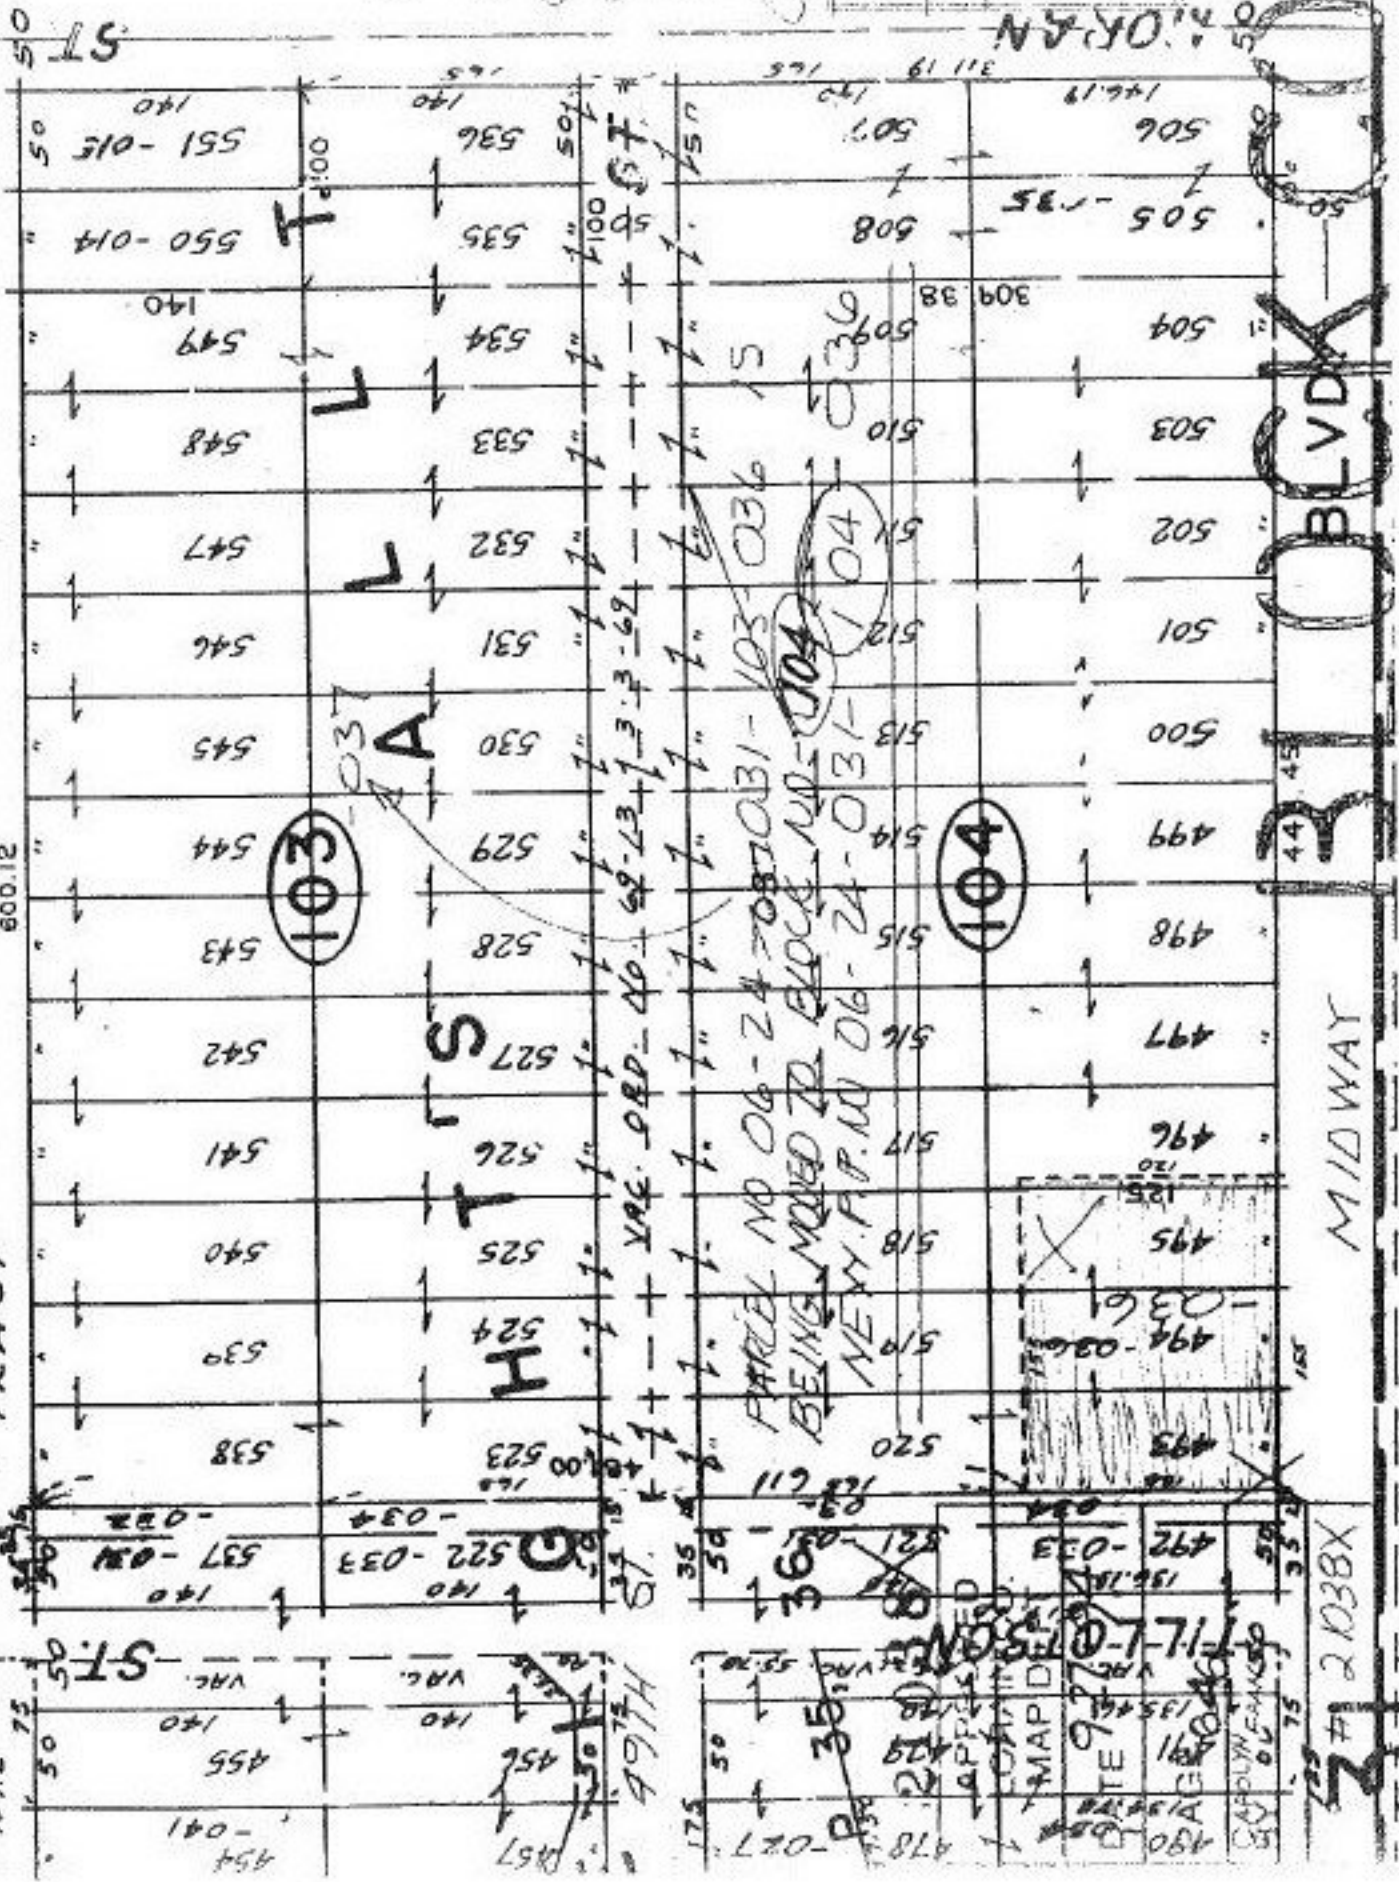

PARCEL NO.
CORRECTION
CHANGE OF
E.A. MO.)

CORRECTION

21038X
9-27-94
6-46
CAROLYN FRANKS
21038X

21038X

O'BRIEN BLVD

MIDWAY

21038X

PARCEL NO 06-24-031-103-036 15
BEING MOVED TO BLOCK NO. 104
NEW P.P. NO 06-24-031-036

103

104

H T S

