

PARSONS 2533.49

(60)

200

120


-001  
40.00 A.

1326.25  
-005 6.09A.  
1325.87

~~-008~~  
~~32.91A.~~  
-010  
31.91A.

436.60  
-009 1.00A.  
435.60  
-007 1.00A.  
435.60

4<sup>200</sup>

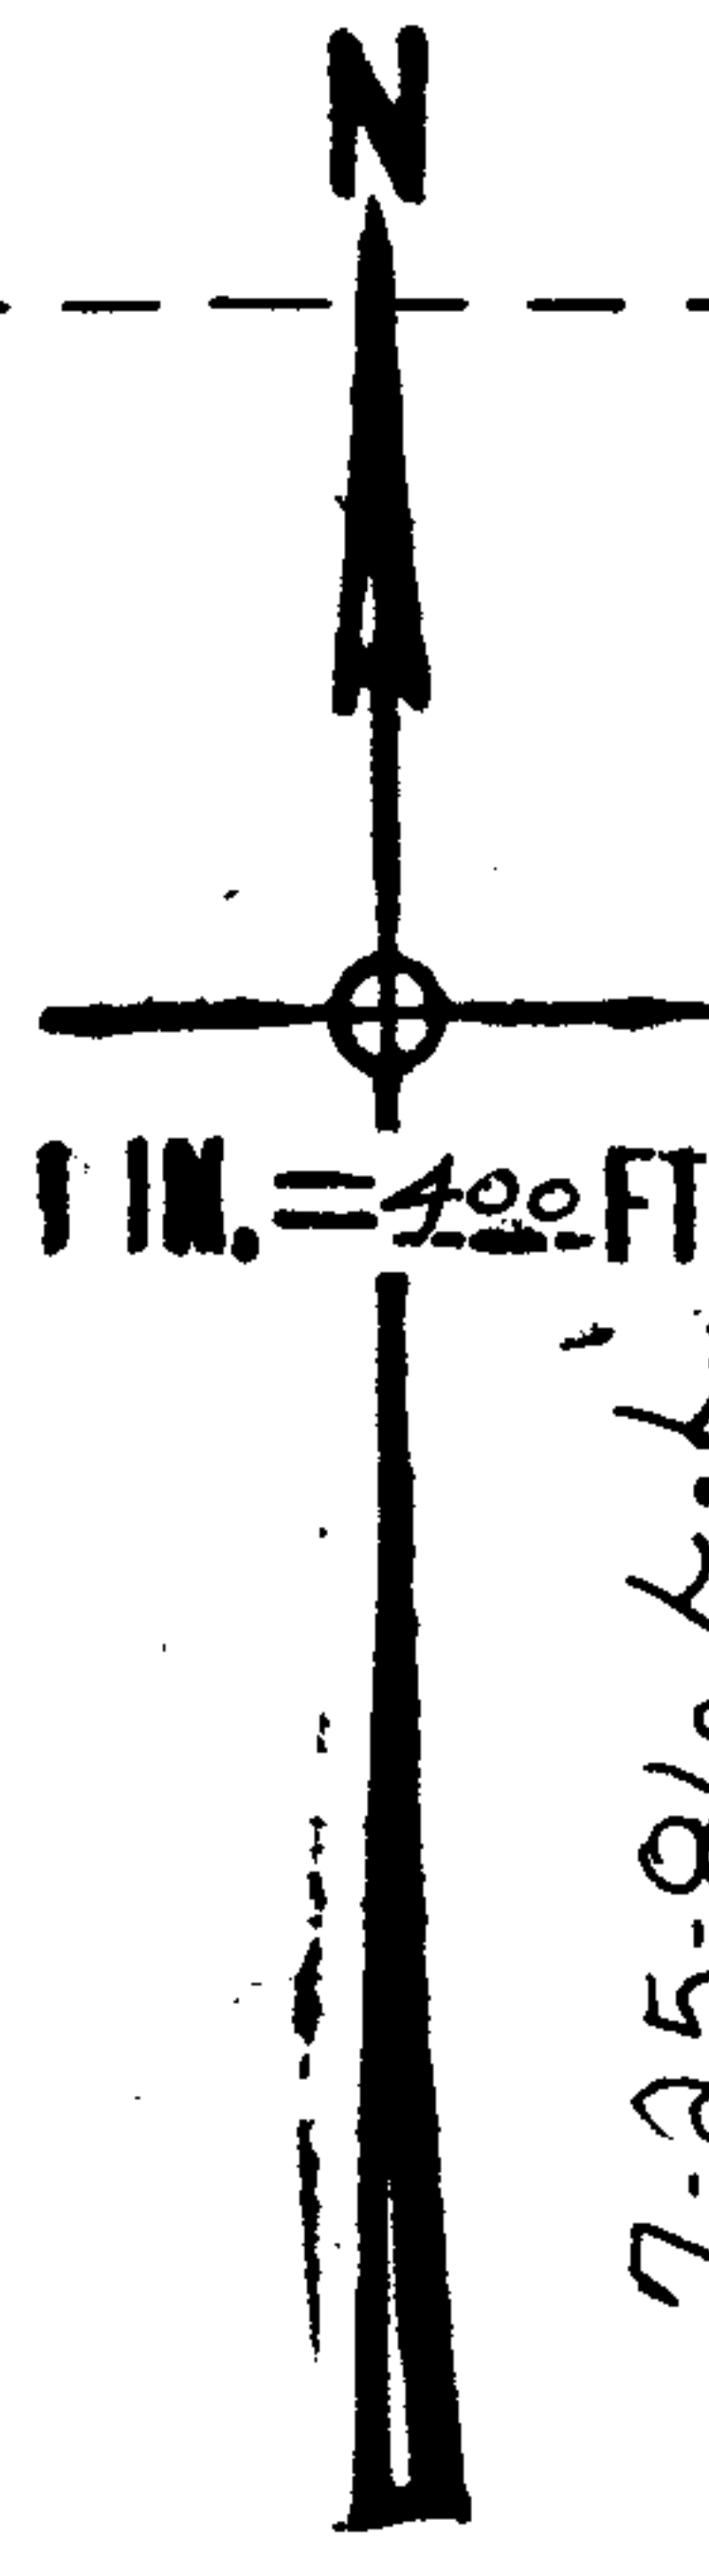

2104

-003  
77.00 A.

*(Handwritten signature)*

7-25-86 L.L.  
**APPROVED**  
**LORAIN CO.**  
**MAP DEPT.**  
DATE 9-17-68  
15-B  
BY *(Signature)*  
R.K.

-004  
5.00A.  
577.2

377.15

-001  
30.00A.

-006  
51.70A.

241.80

250  
-005  
80 A.  
250

17