


#21040 X

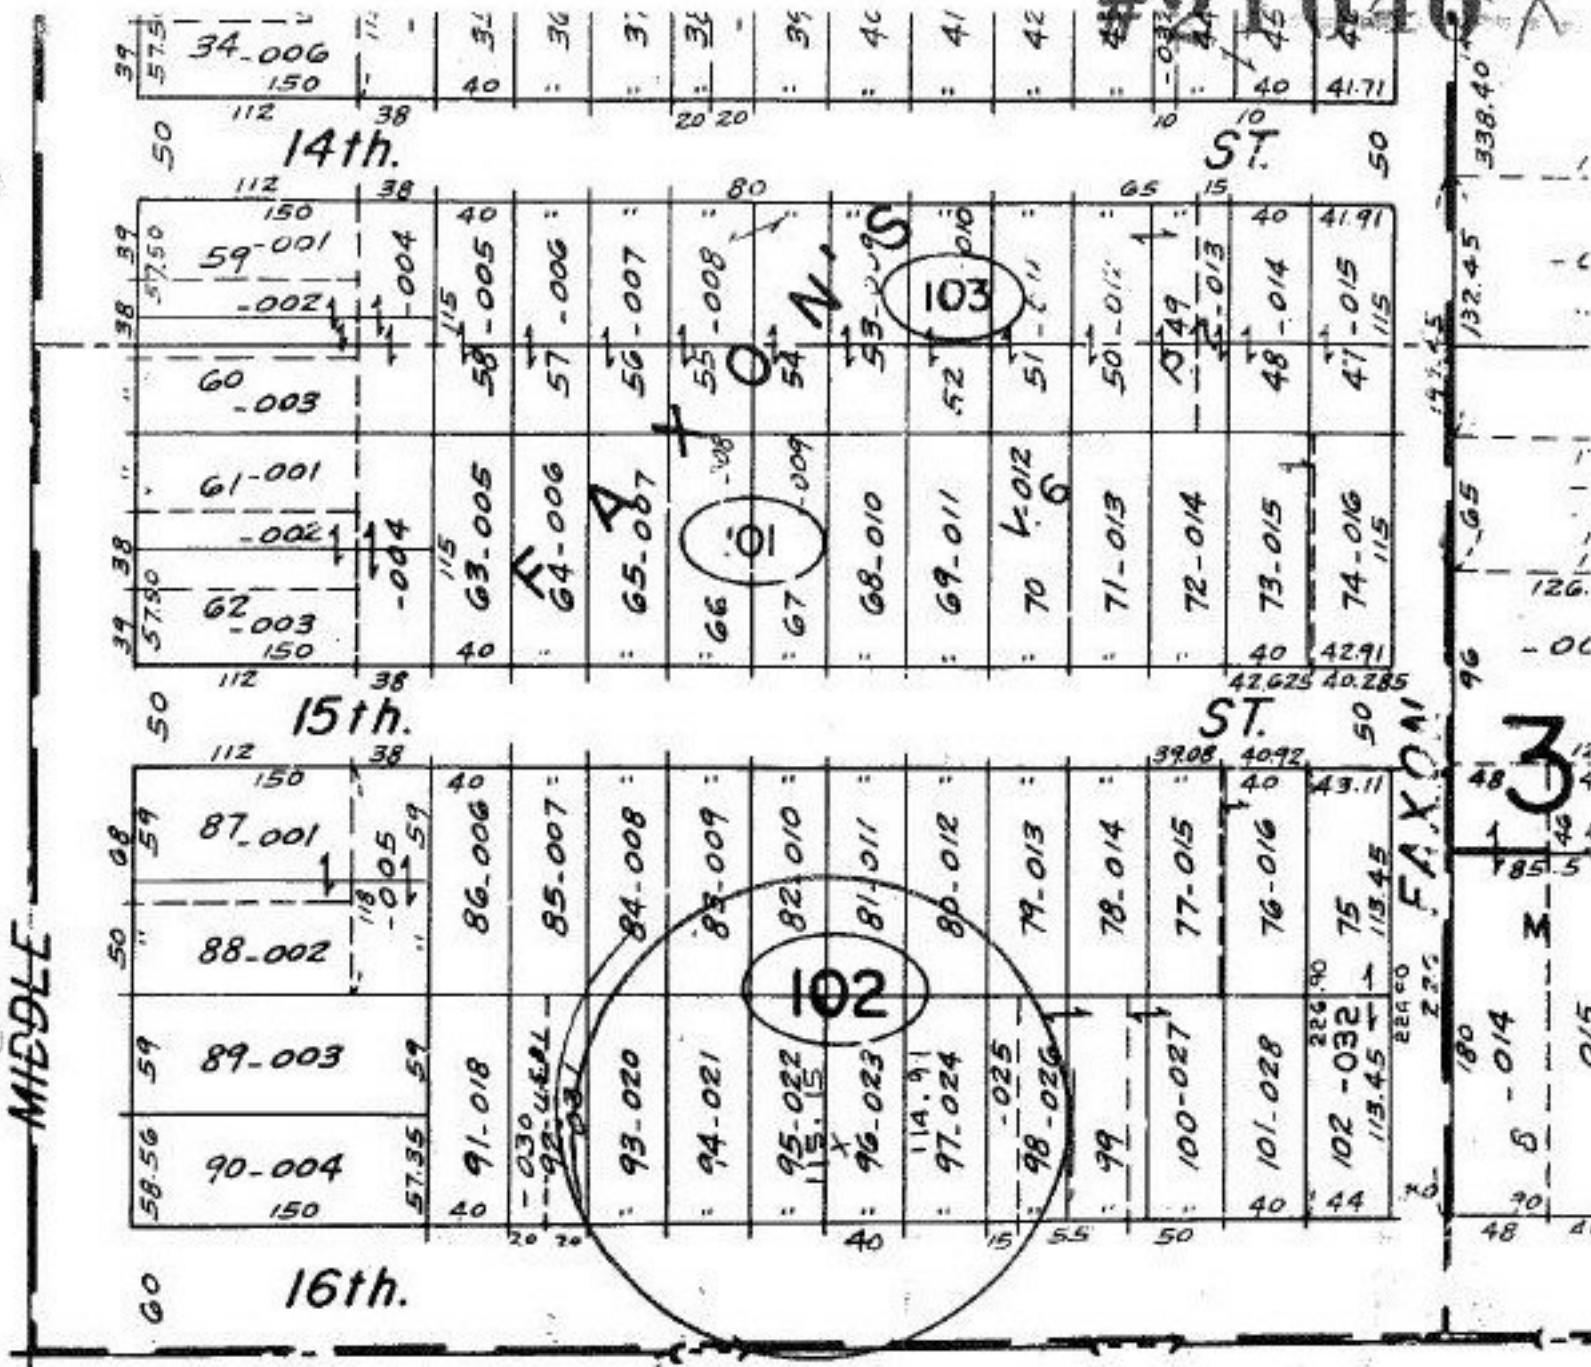

# MAP CORR

AND

## DEPTH CORR.

06-26-003-102-023

DEED FILED 9-13-94

O.R.V. 975/258

#21040 X

APPROVED LORAIN CO. MAP DEPT
DATE 12-20-94
PAGE 6-138
BY CAROLYN FRANCIS
21040X