


#21041-X

CENTER ST. 301

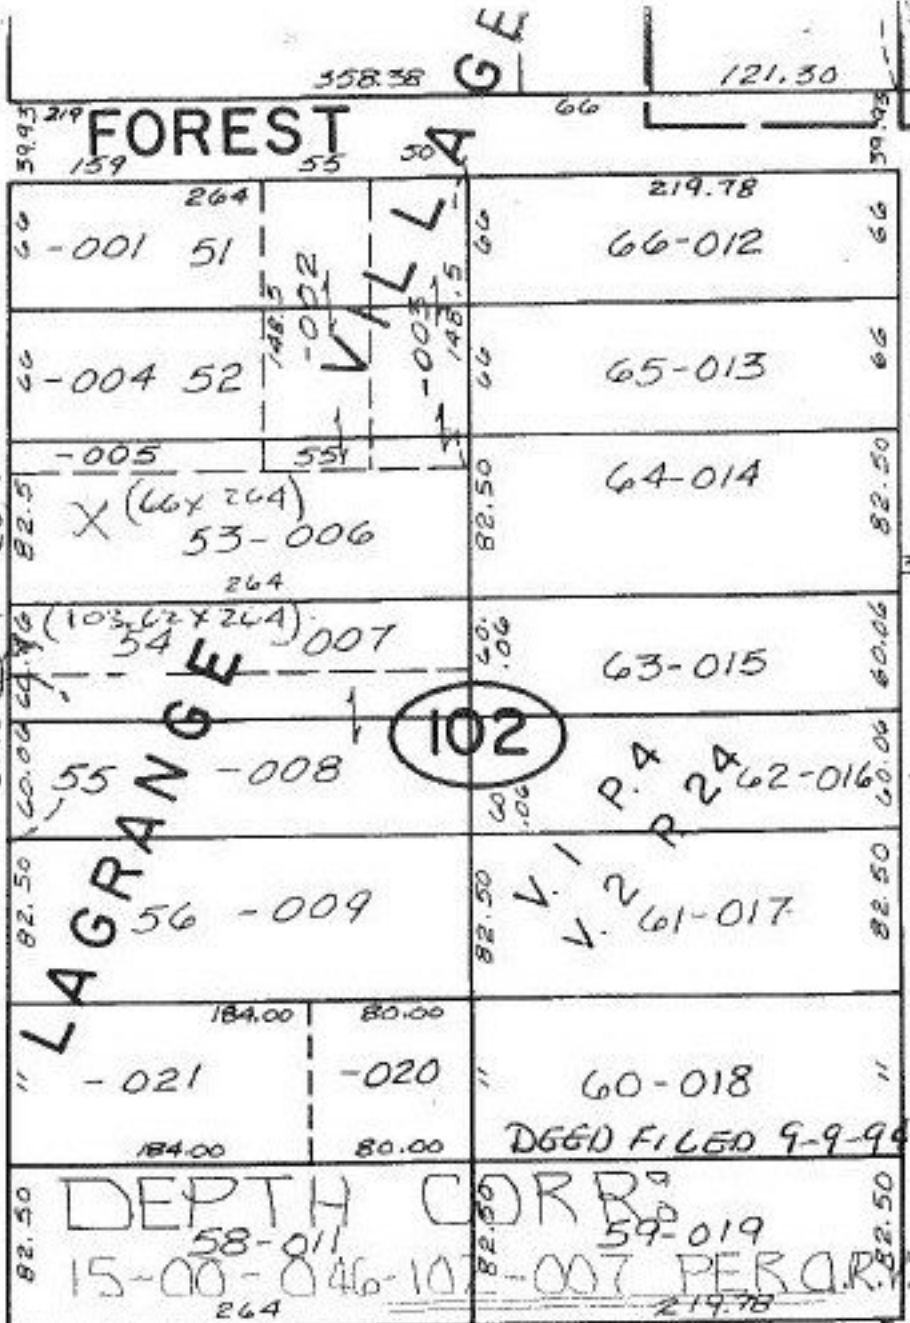

TOTAL FRUITAGE

301

PROSPECT ST.

#21041-X

APPROVED  
LORAIN CO.  
MAP DEPT

DATE 12-20-94

PAGE 15-00-046-A

BY CAROLYN  
FRANCIS

21041-X