


#21042-D

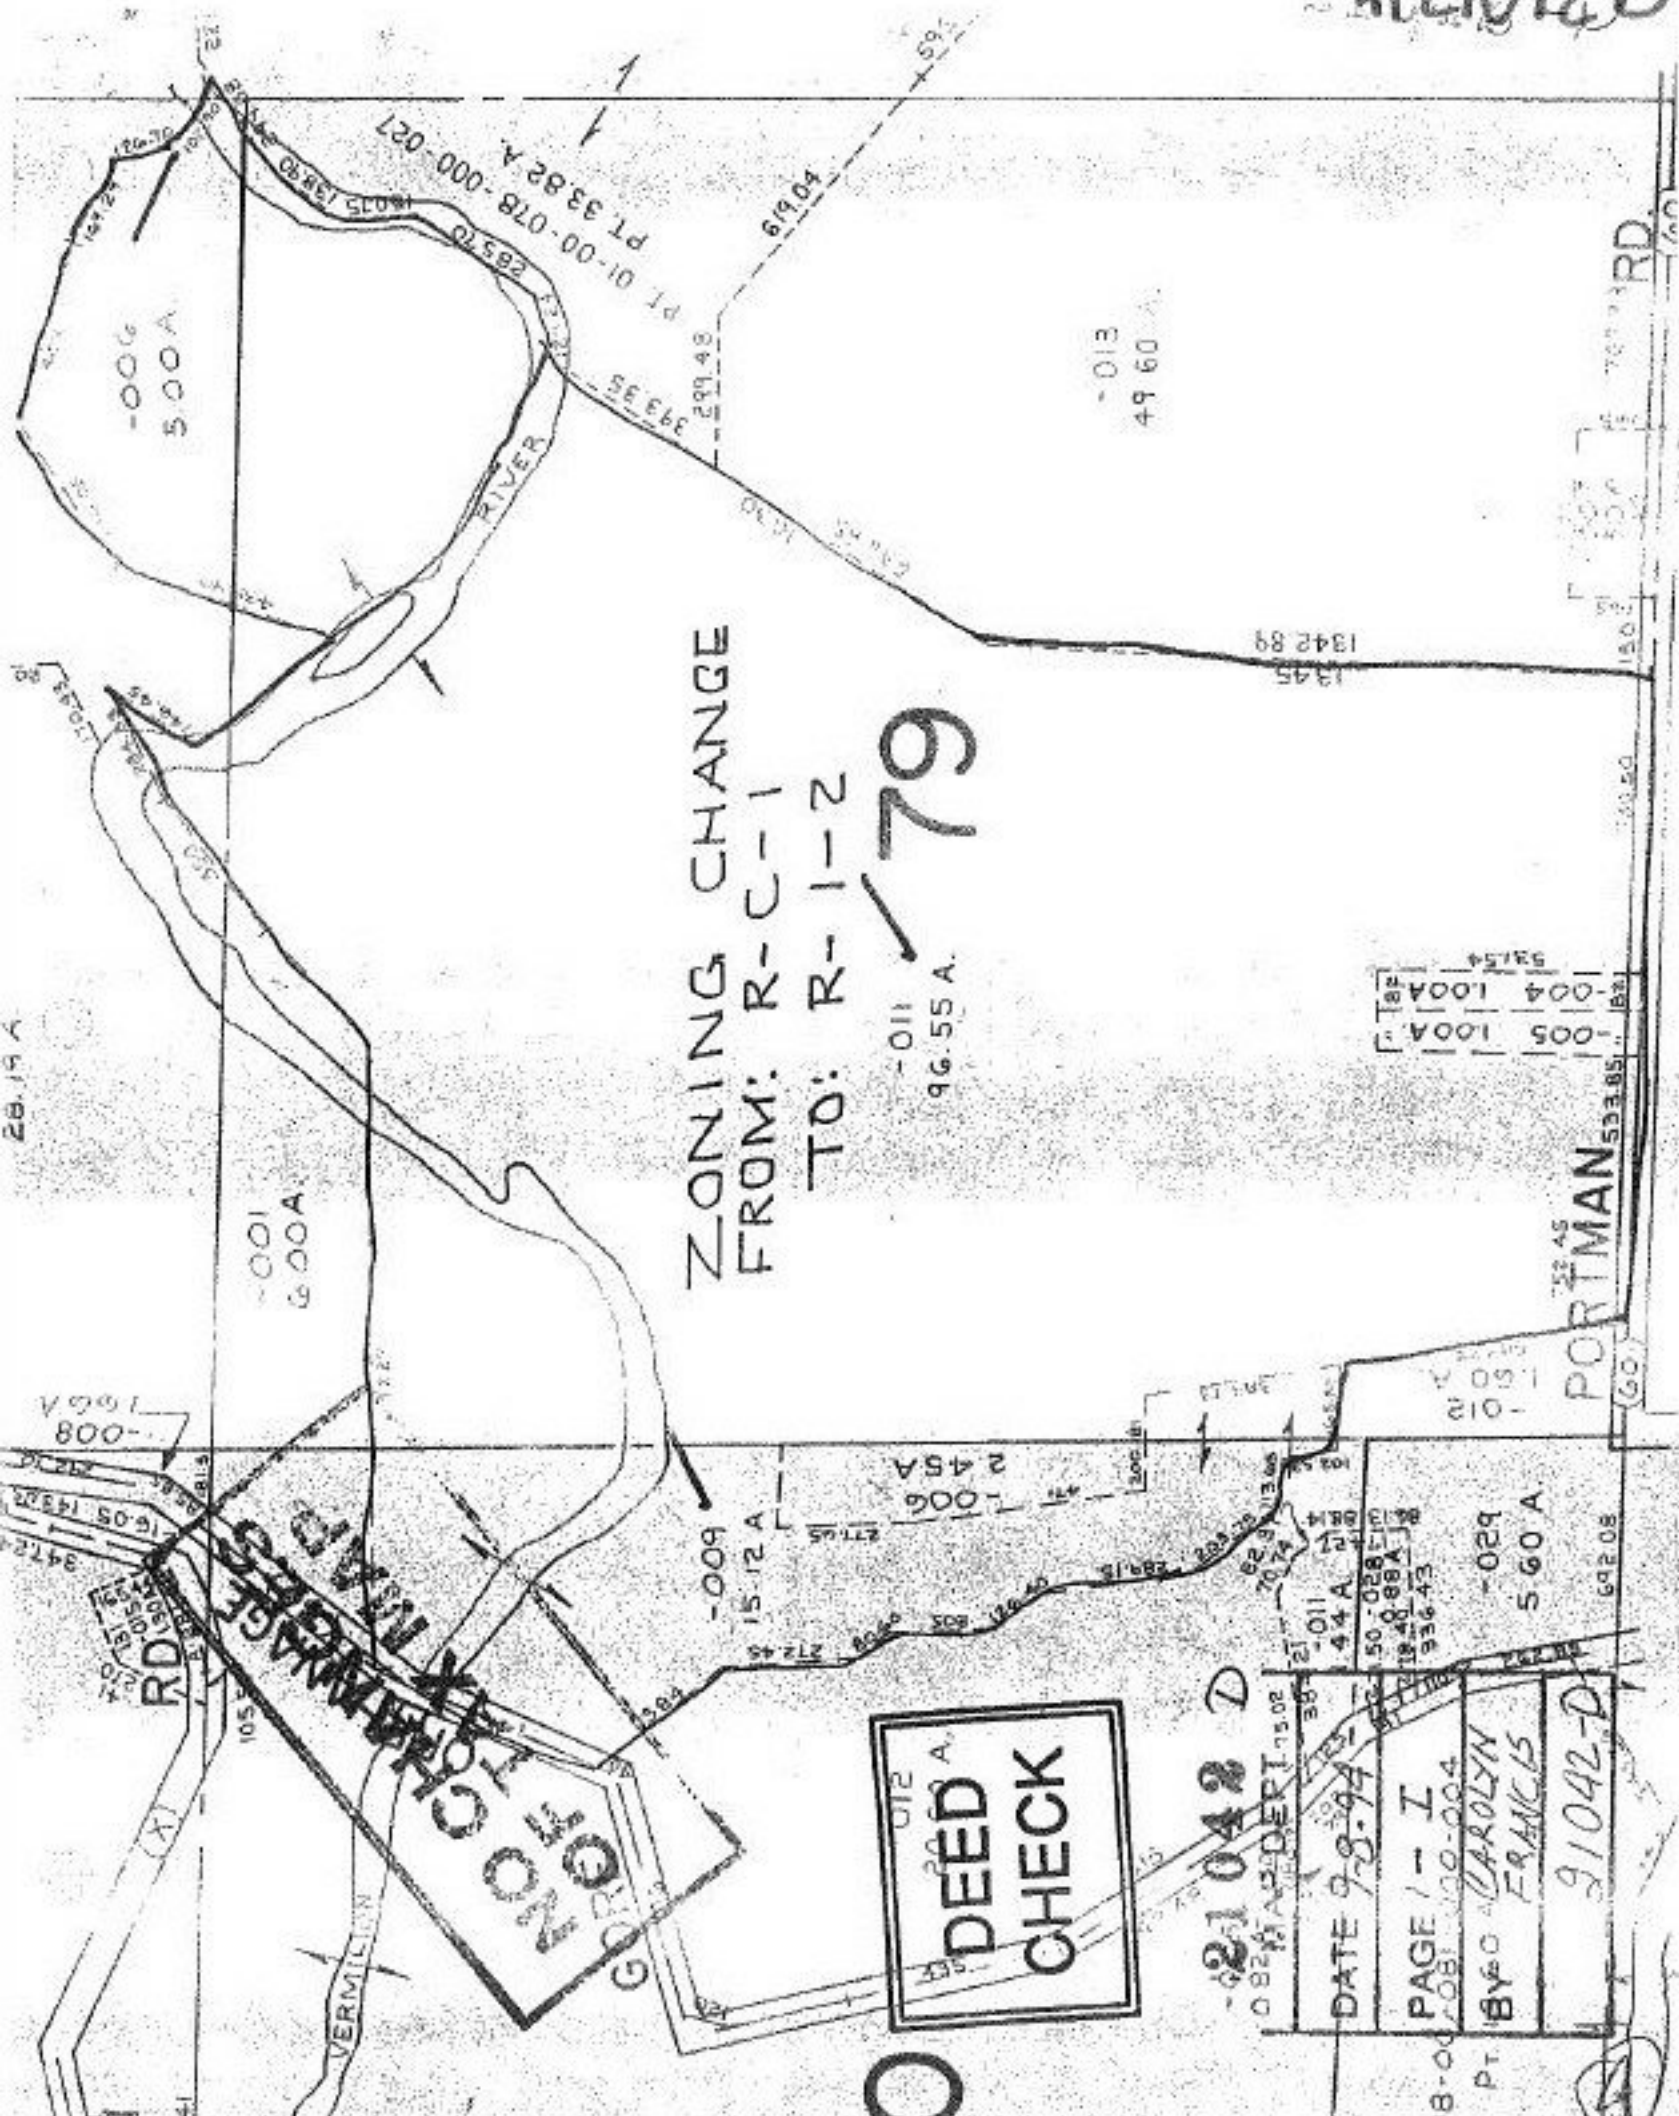

ZONING CHANGE
 FROM: R-C-1
 TO: R-1-2

-011
 96.55 A.

79

DEED CHECK

21042 D

DATE 9-8-94

PAGE 1 - I

BY CAROLYN FRANKS

21042-D

-005 100A
 -004 100A
 Tax 53154

PORTMAN RD

-013
 49.60 A.

-001
 6.00 A.

-009
 15.12 A

-006
 2.45 A

-029
 5.60 A

69208

1342.89
 1345

RD