



21043 U

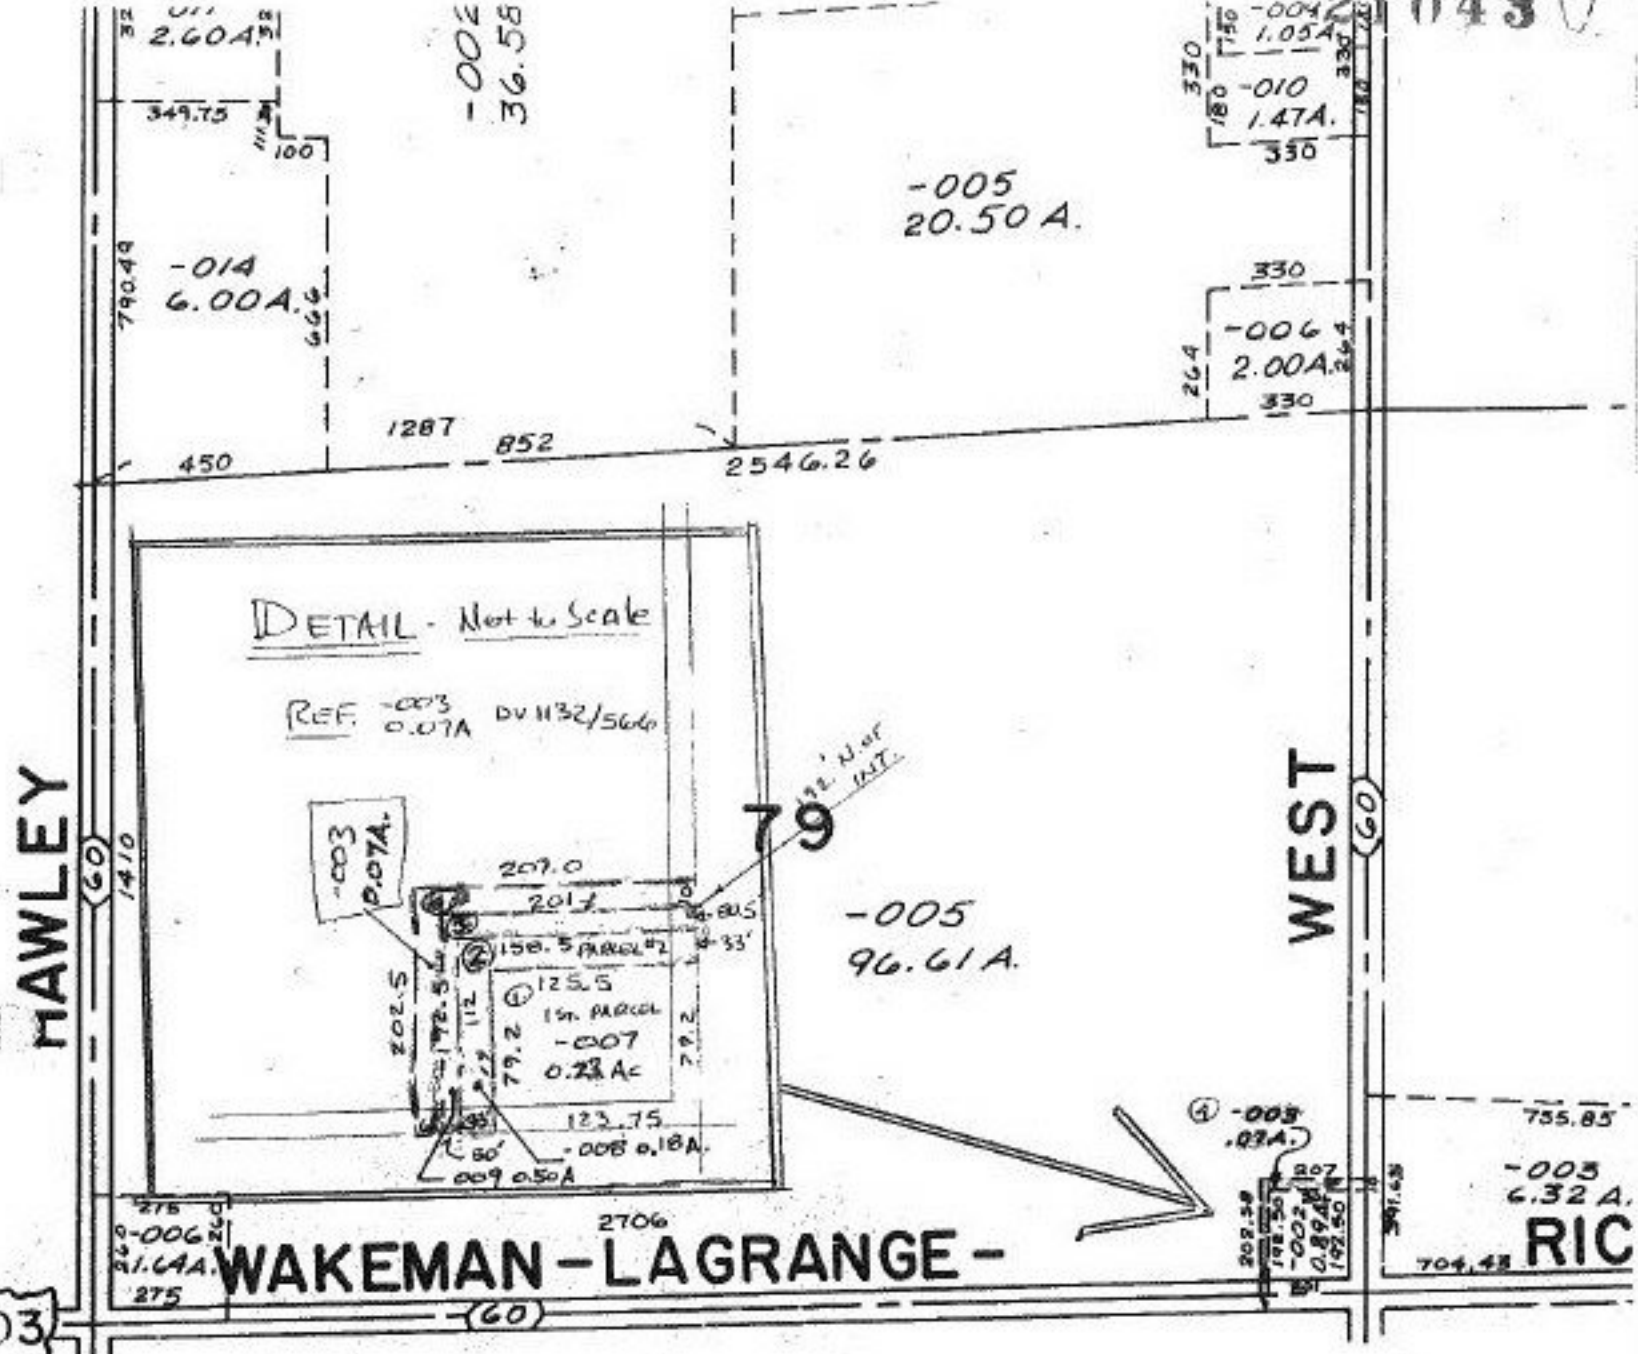

PITTSFIELD TWP.

SCALE: 1" = 400'

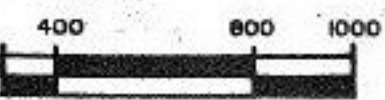

3 NEW PARCELS CREATED FROM -002 TO
 REFLECT DV 1132/568-570 & CE. APPROVED
 SURVEY, ~~THE~~ SEPT. 1975
 -003 0.07A. IS UNCHANGED

#21043-U

UNCOMBINATION

APPROVED
LORAIN CO.
MAP DEPT.
DATE 9-16-94
PAGE 14-D
DY T. McMain
21043-U