


21047

31.50 A.

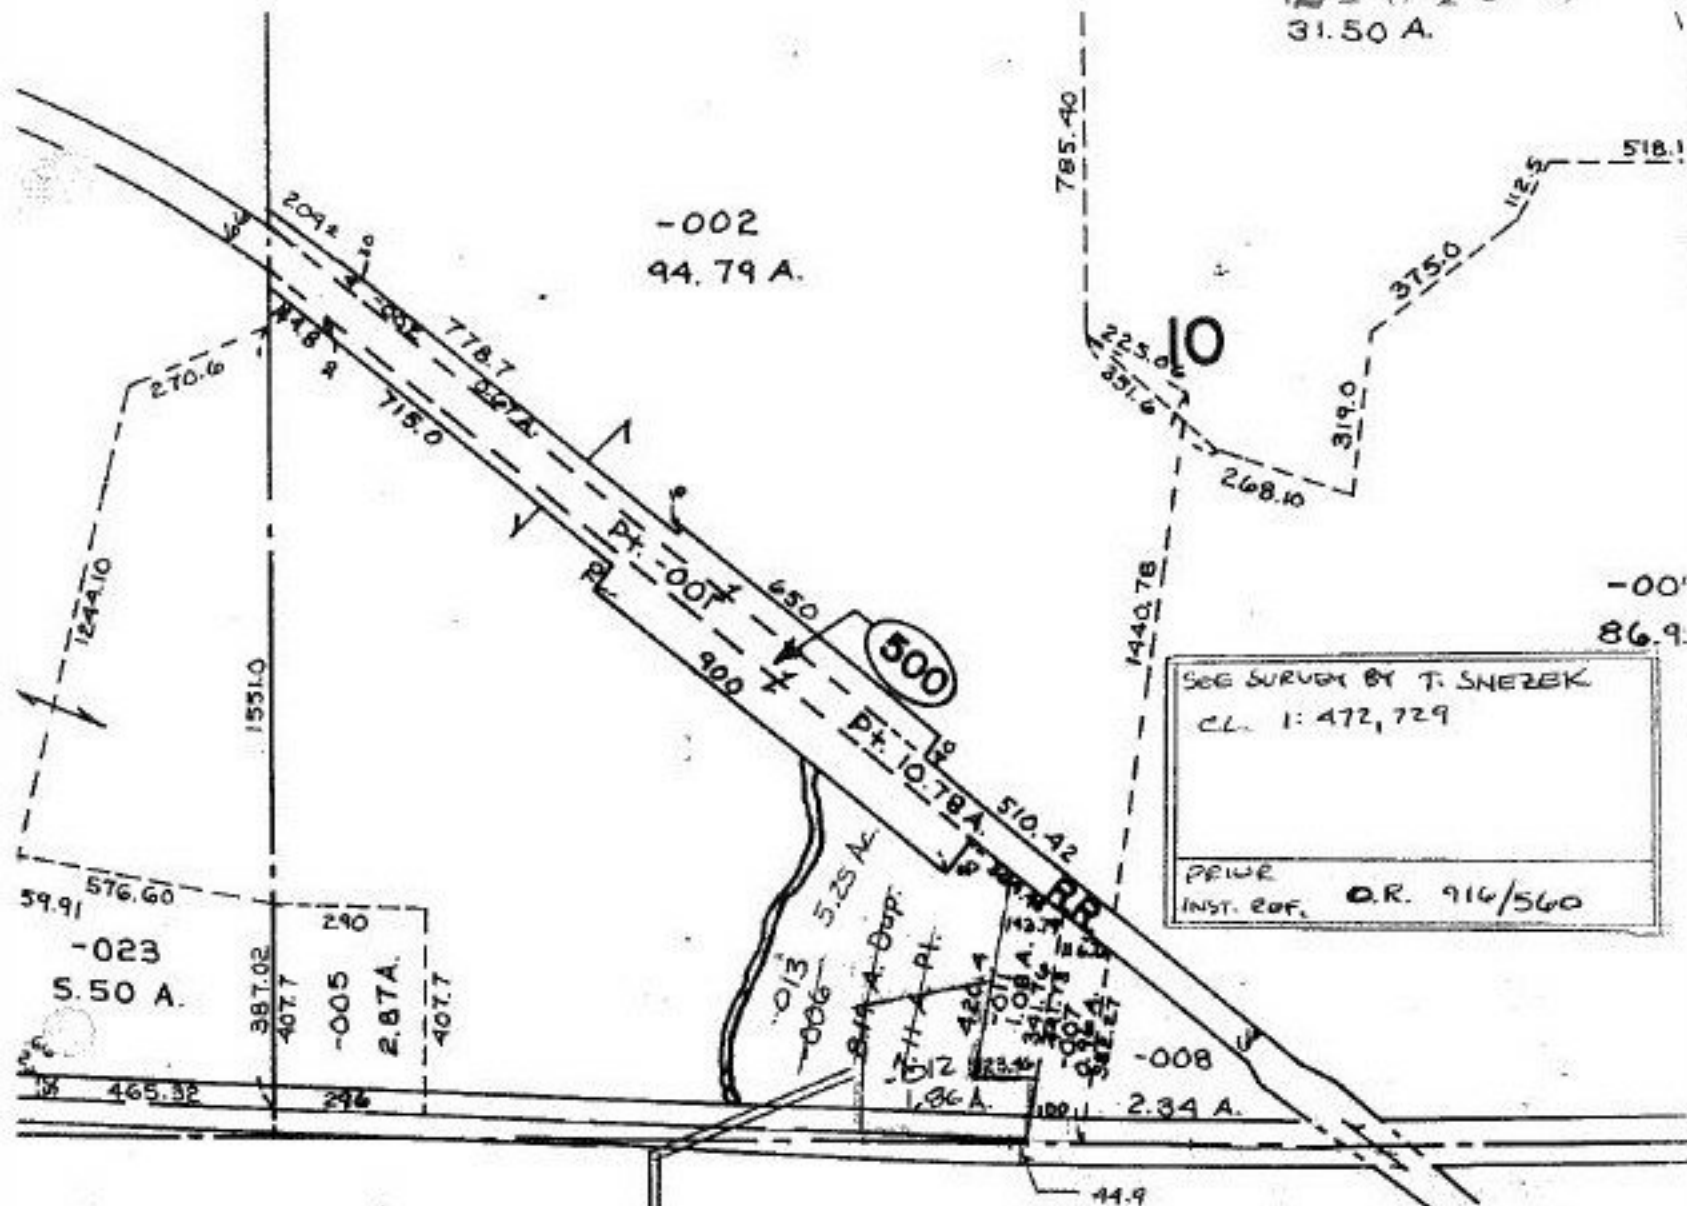


SEE SURVEY BY T. SNEZBK
 CL. 1: 472, 729

PRICE
 INST. REF. O.R. 916/560

USE DETAIL TO SHOW DIMENSIONS

DETAIL - NOT TO SCALE

REM. -013
5.25 A.

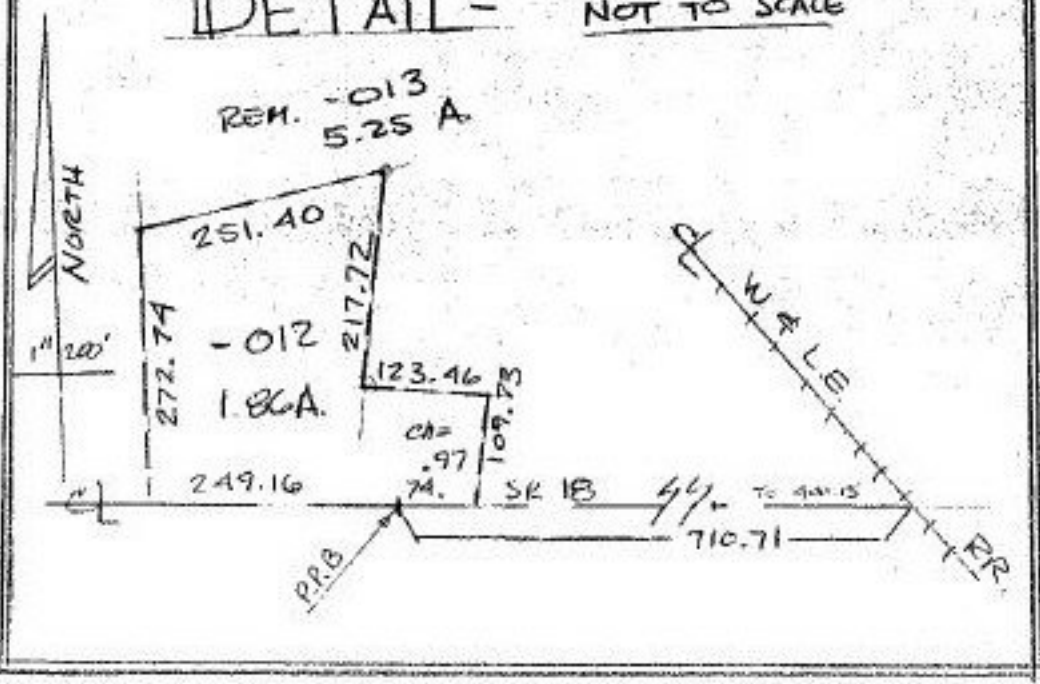

#21047

APPROVED
 LORAIN CO.
 MAP DEPT.

DATE 11-2-94

PAGE 17-D

BY T. McMain

NO. AFTER 21047