


#21053-X

JEE C-UL-0250

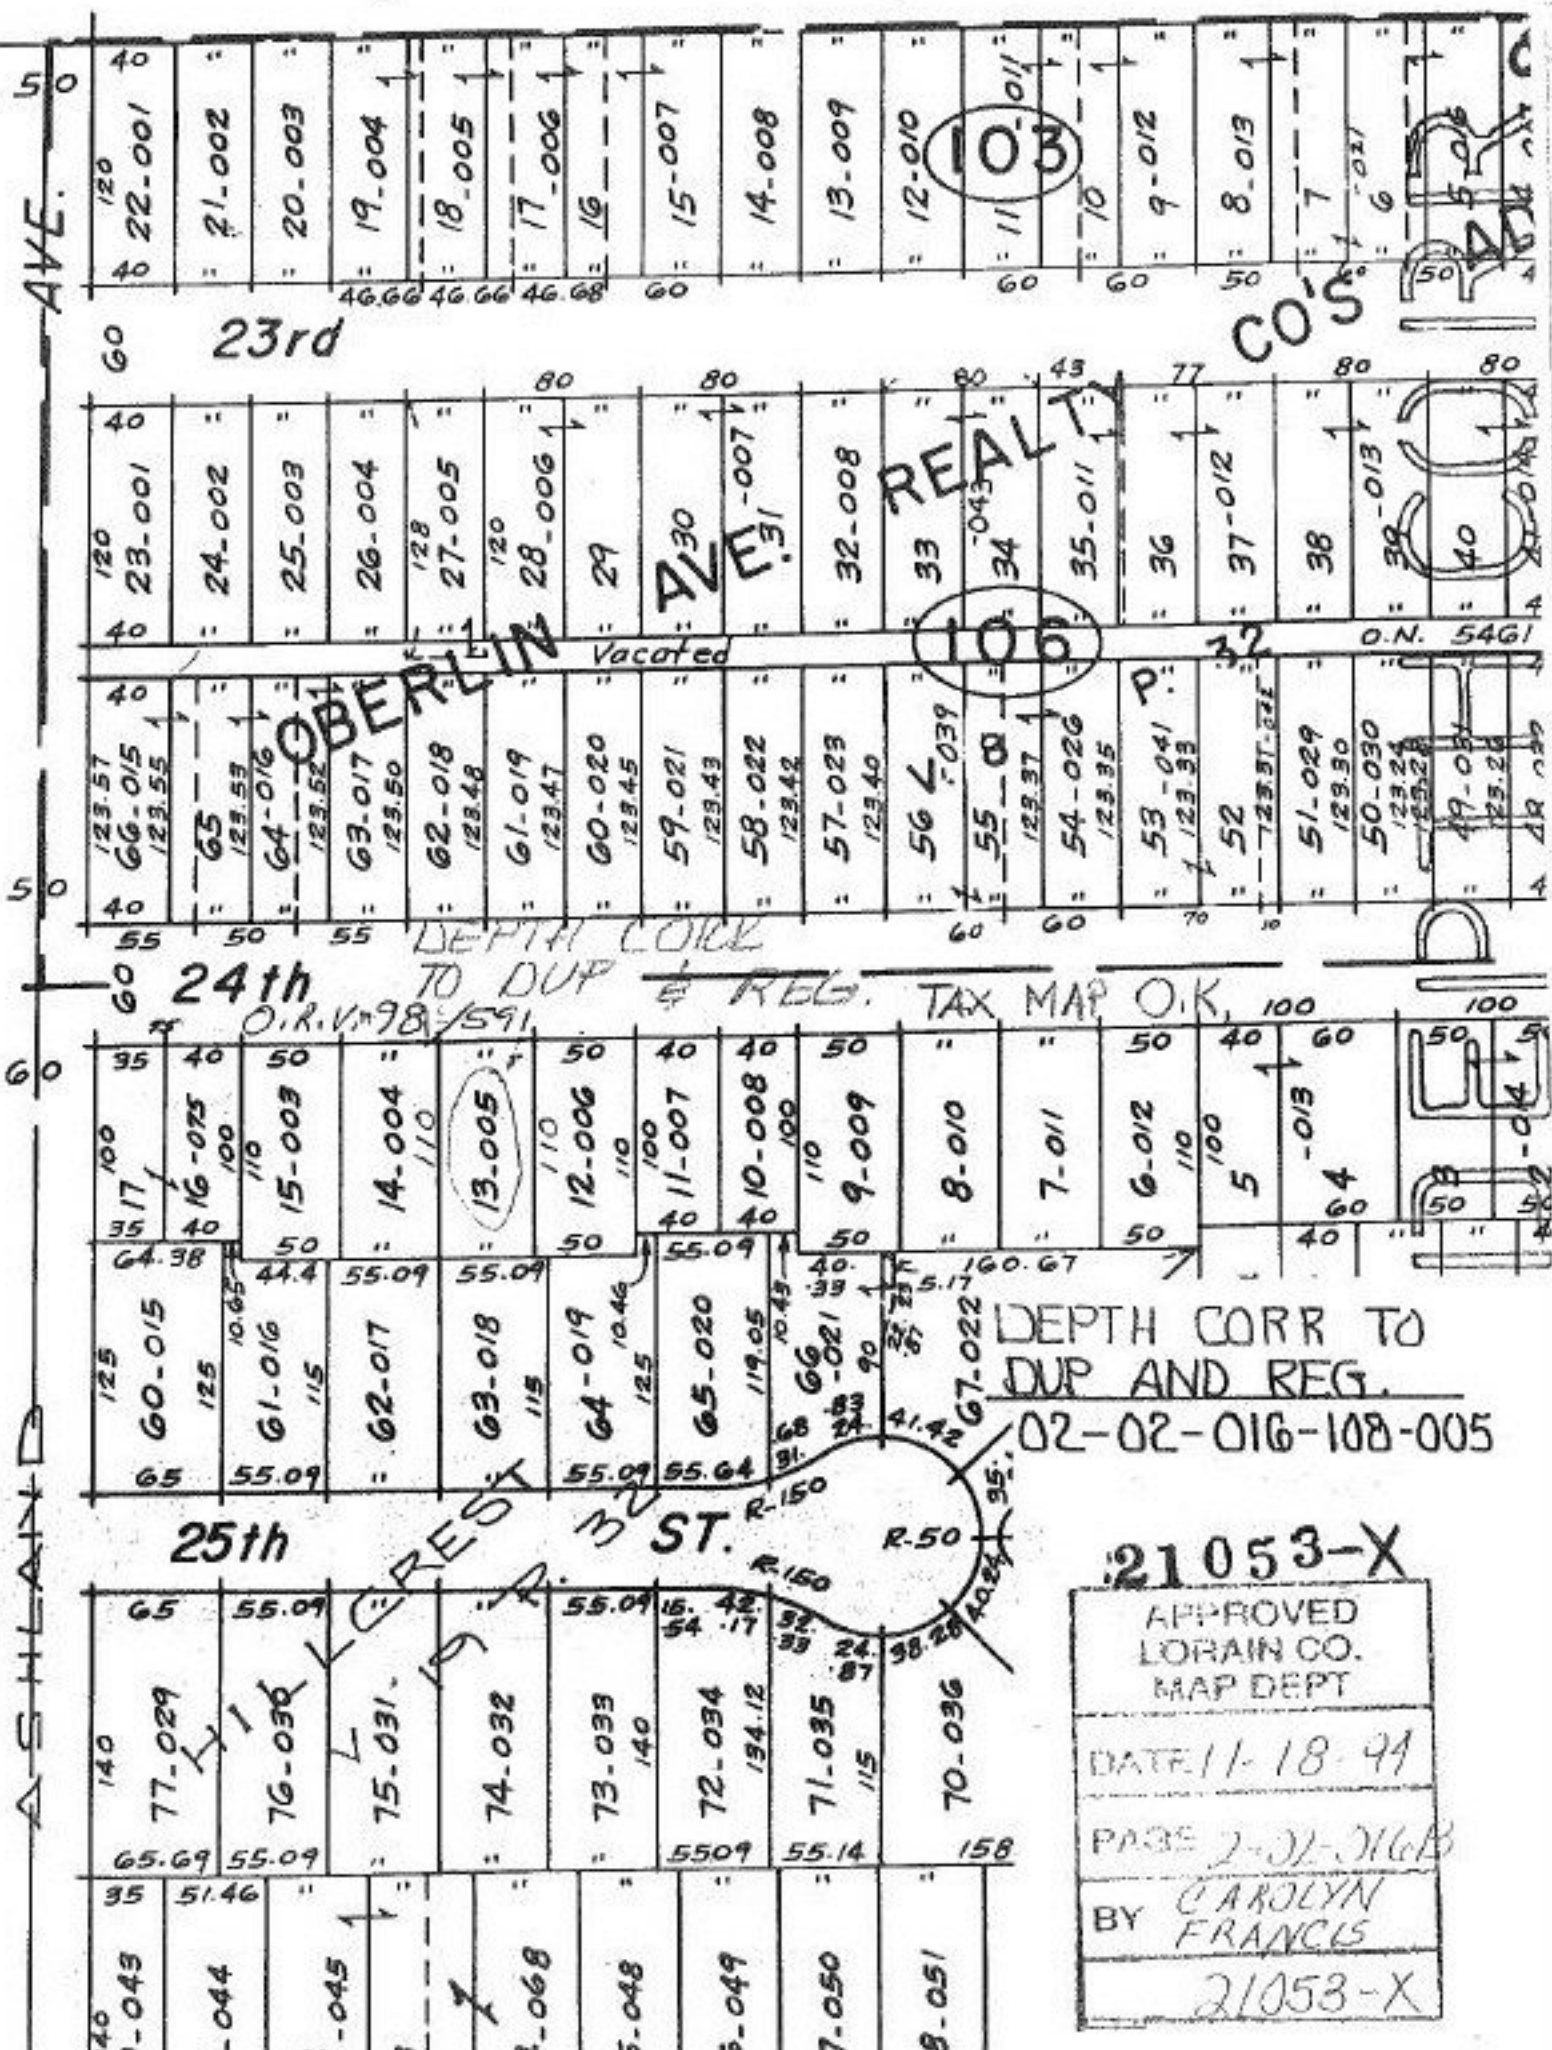

23rd

24th

25th

DEPTH CORR TO DUP & REG. TAX MAP O.K.

DEPTH CORR TO DUP AND REG.

02-02-016-108-005

21053-X

APPROVED LORAIN CO. MAP DEPT
DATE 11-18-94
PAGE 2-31-11613
BY CAROLYN FRANCIS
21053-X