


#21055

PARCEL (2)

21-05-040-000-005
ADD DISTANCES TO T.M.D.

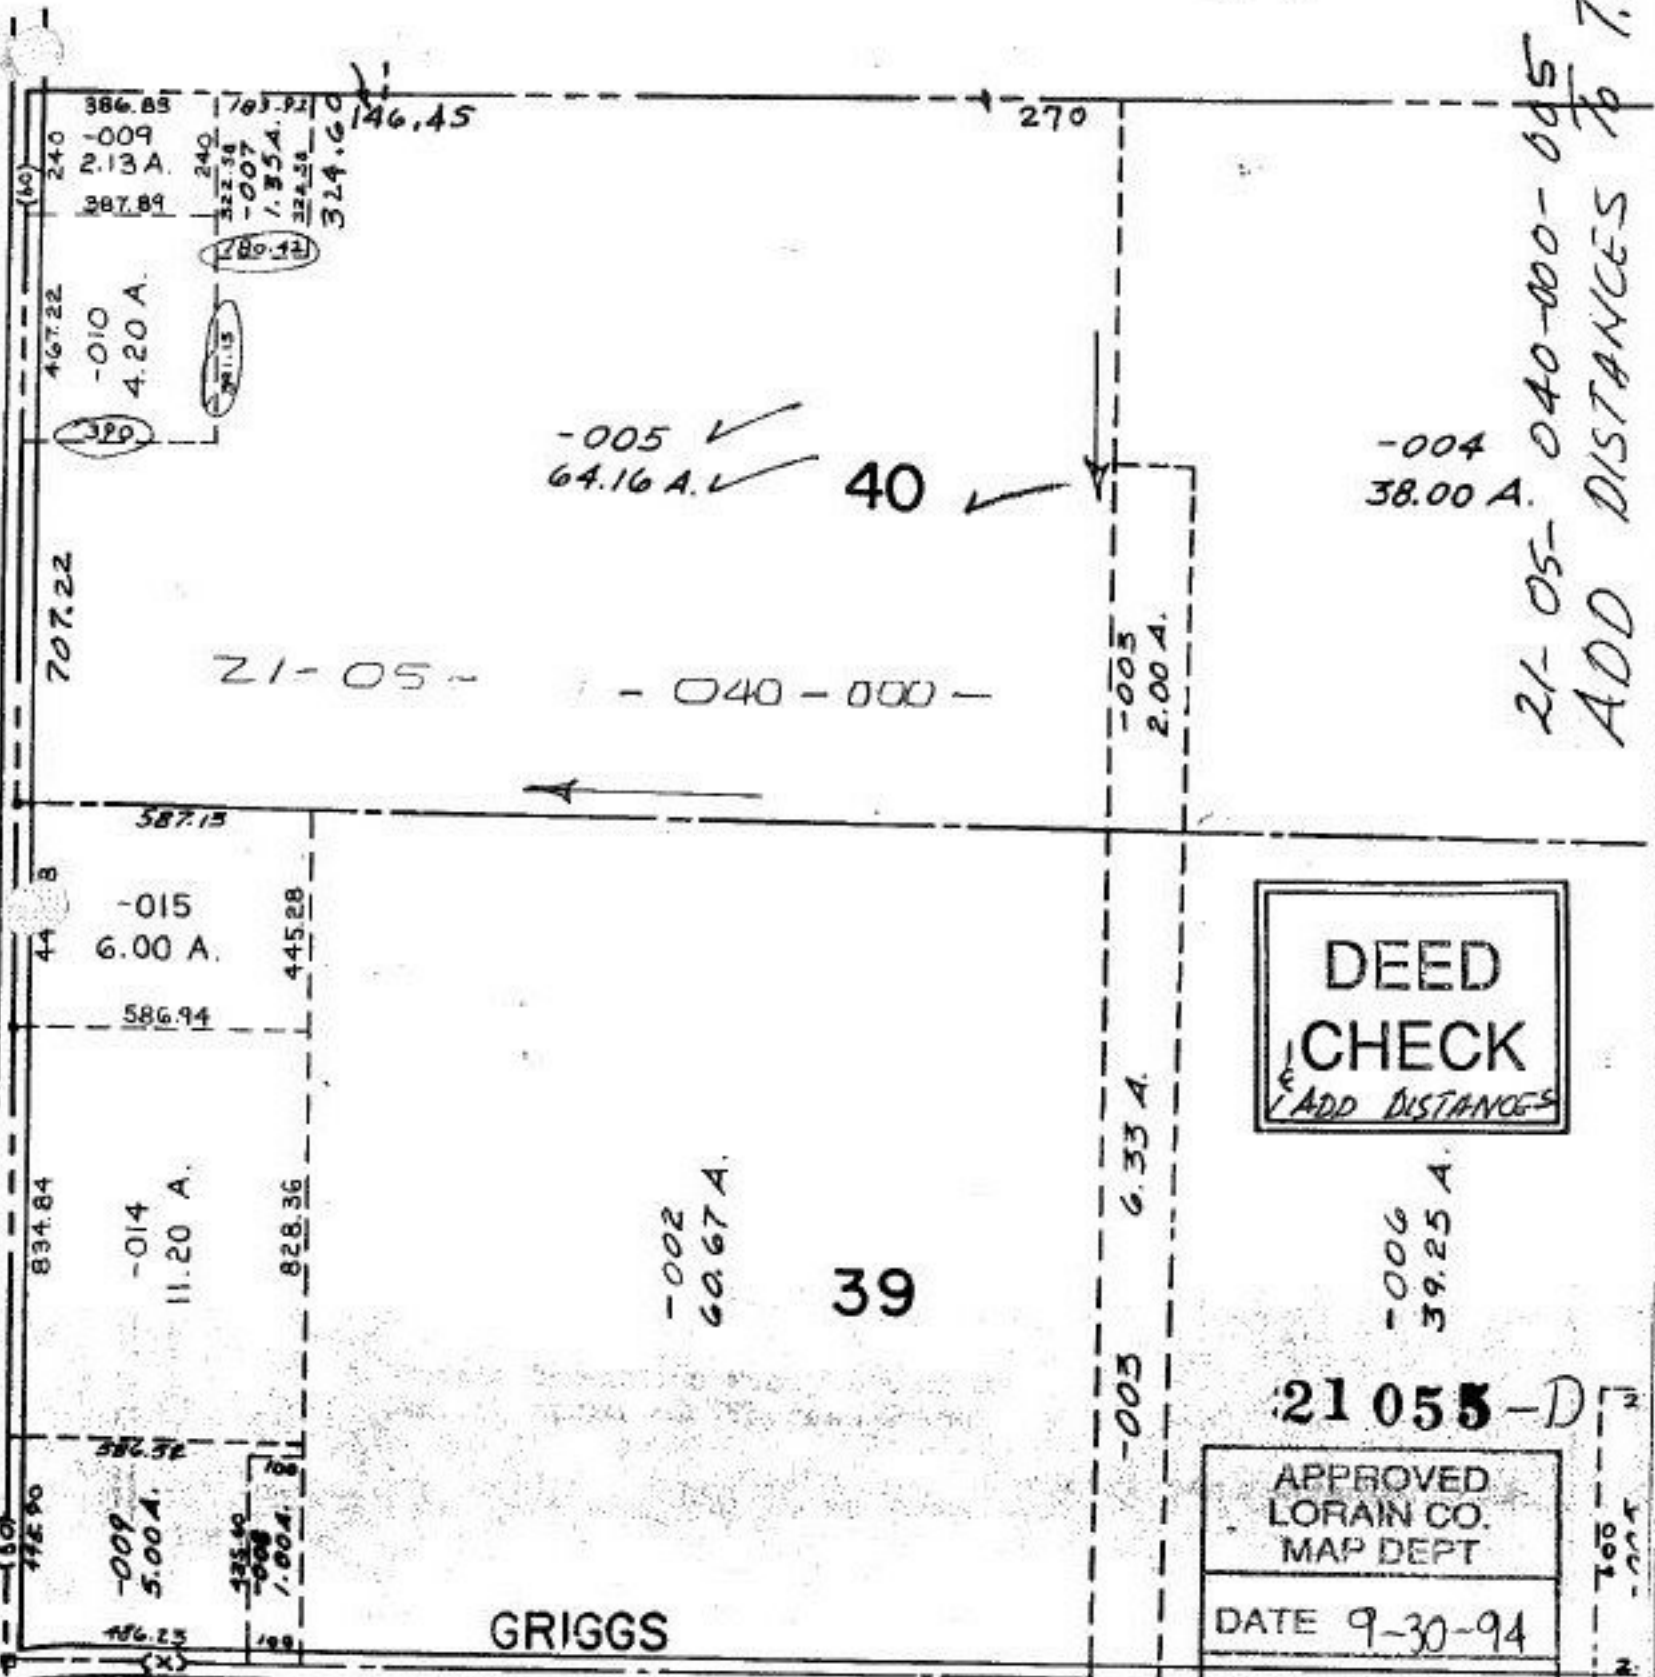

DEED CHECK
ADD DISTANCES

21055-D

APPROVED
LORAIN CO.
MAP DEPT

DATE 9-30-94

FRANCIS
21-A 702.50
1.29 A. 6.00 A. 002
702.50
21055-D

DEED (2) (12)

DEED CK
21-05-040-000-005

21-A