


#21064-X

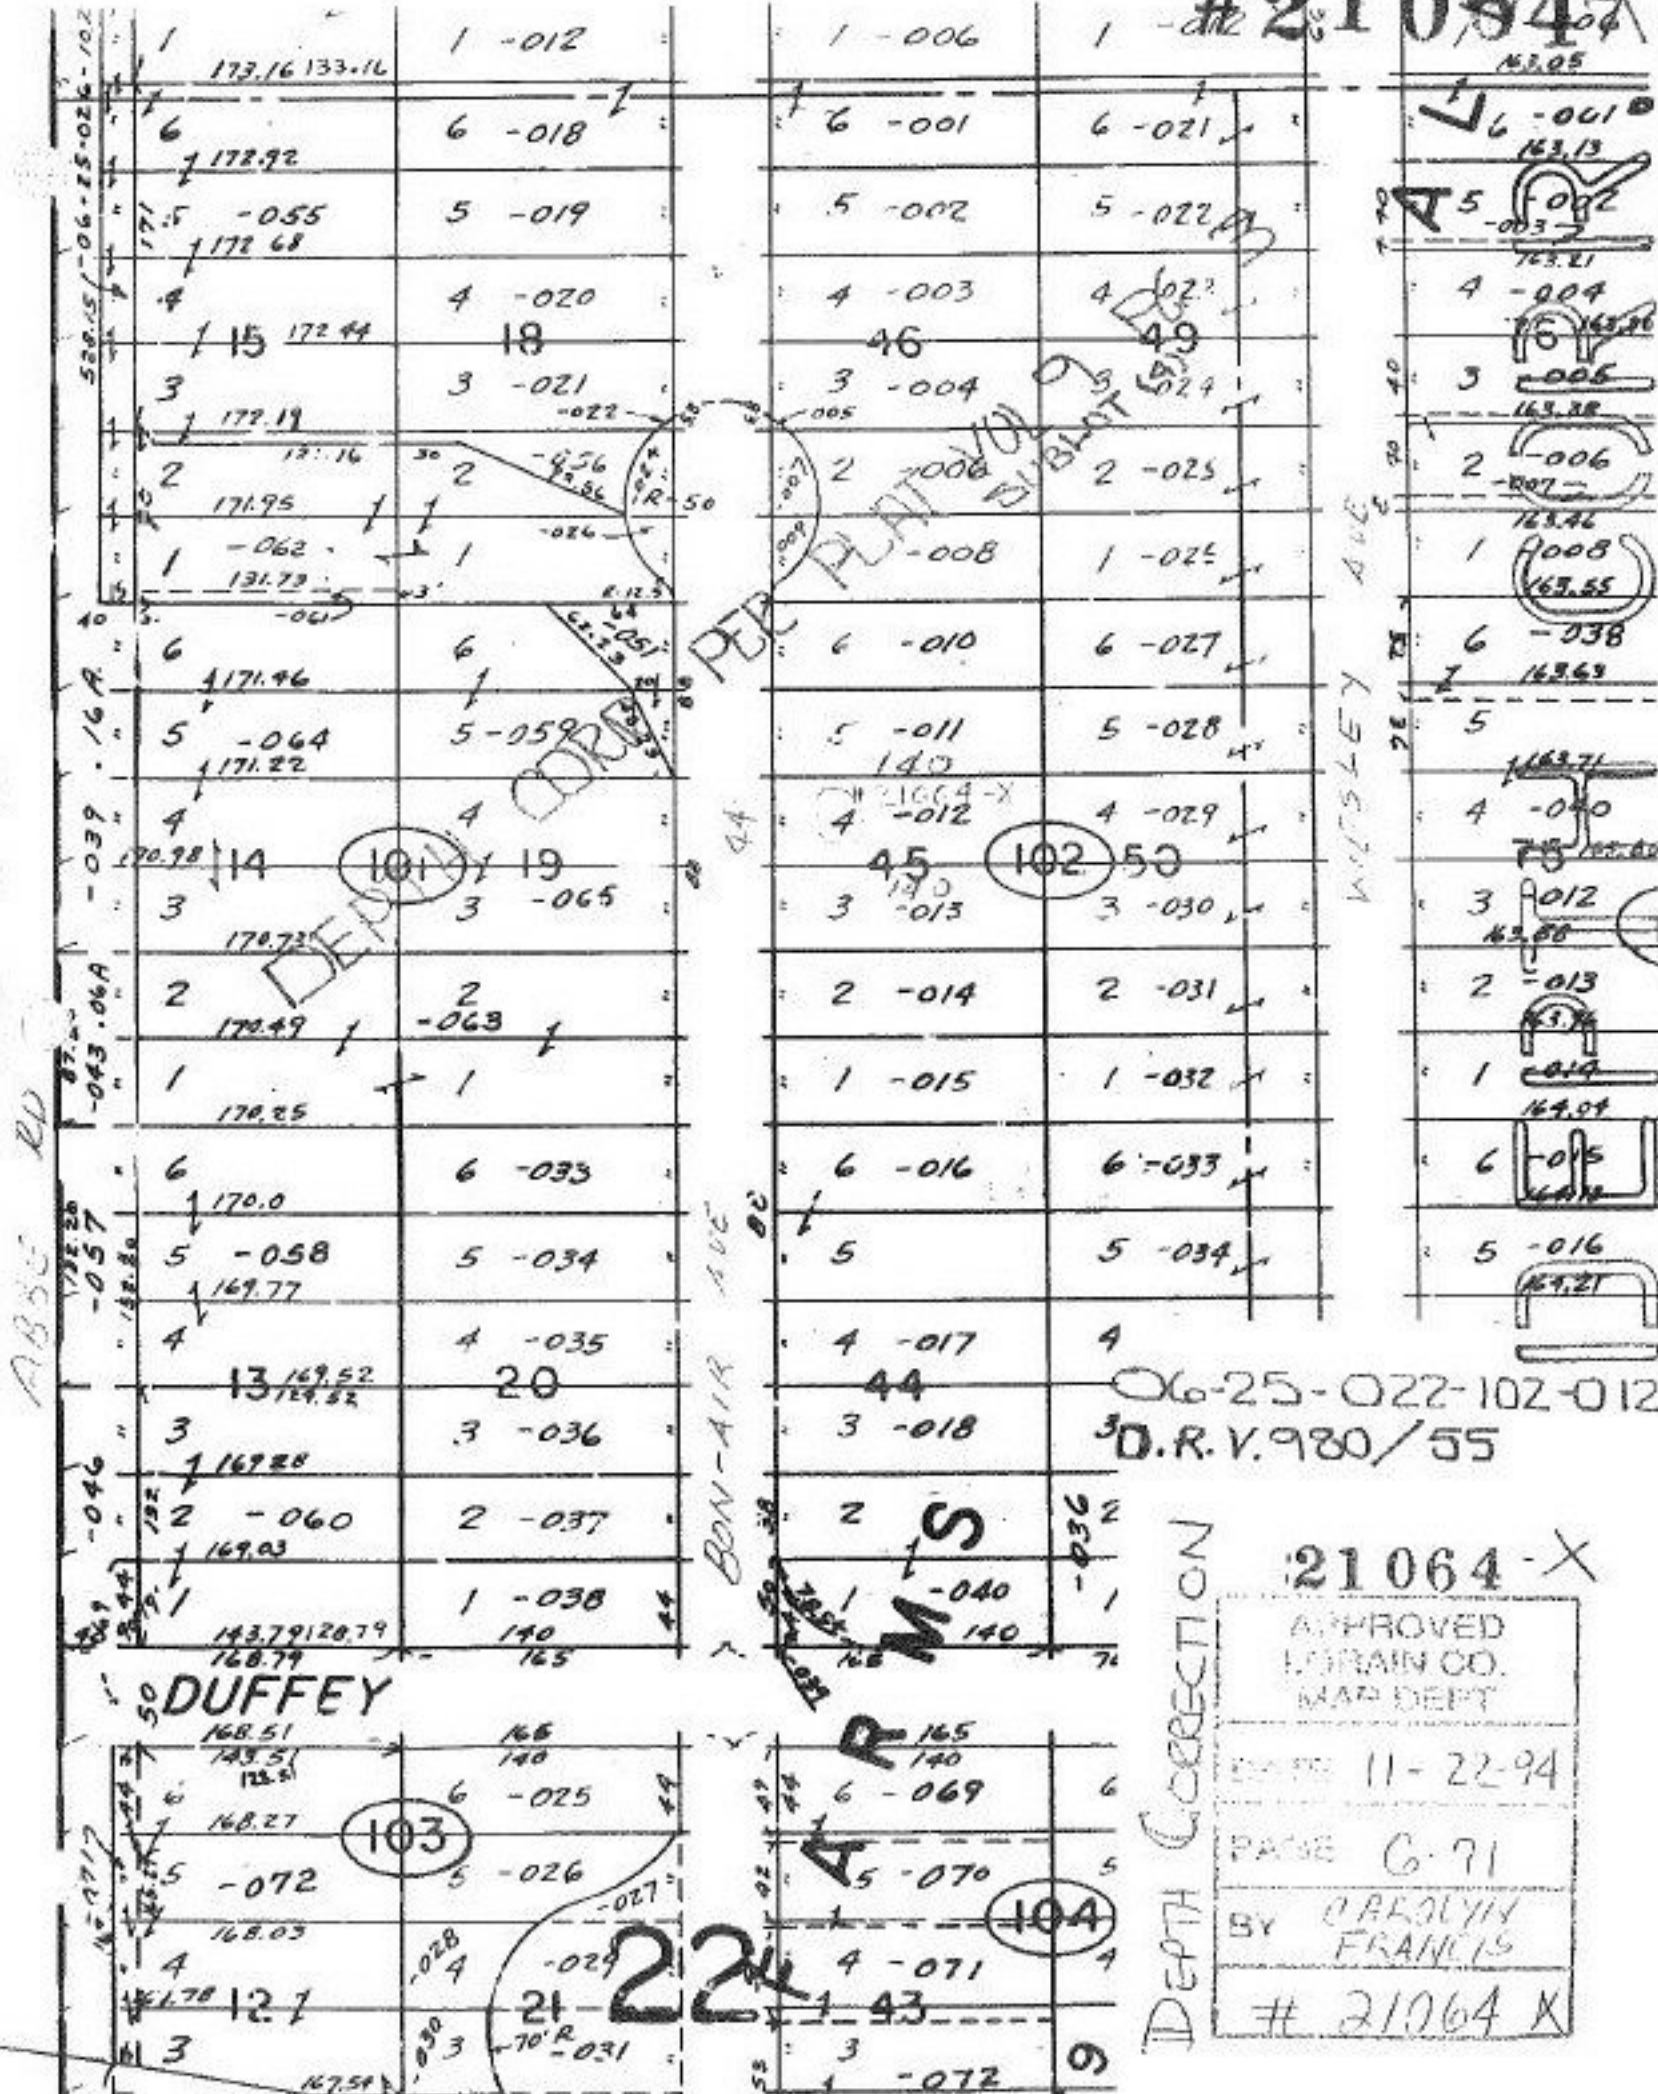

06-25-022-102-012
D.R.V. 980/55

21064-X

APPROVED
 LORAIN CO.
 MAP DEPT
 DATE 11-22-94
 PAGE 6-71
 BY CAROLYN
 FRANCIS
 # 21064 X

NOTICE OF CORRECTION

DUFFEY

22