

HUGHES

1836.84  
2336.84

RD.

DUAZY RD  
414.48

806.87


350

598.43

250

156  
280  
159.0  
280

39.53

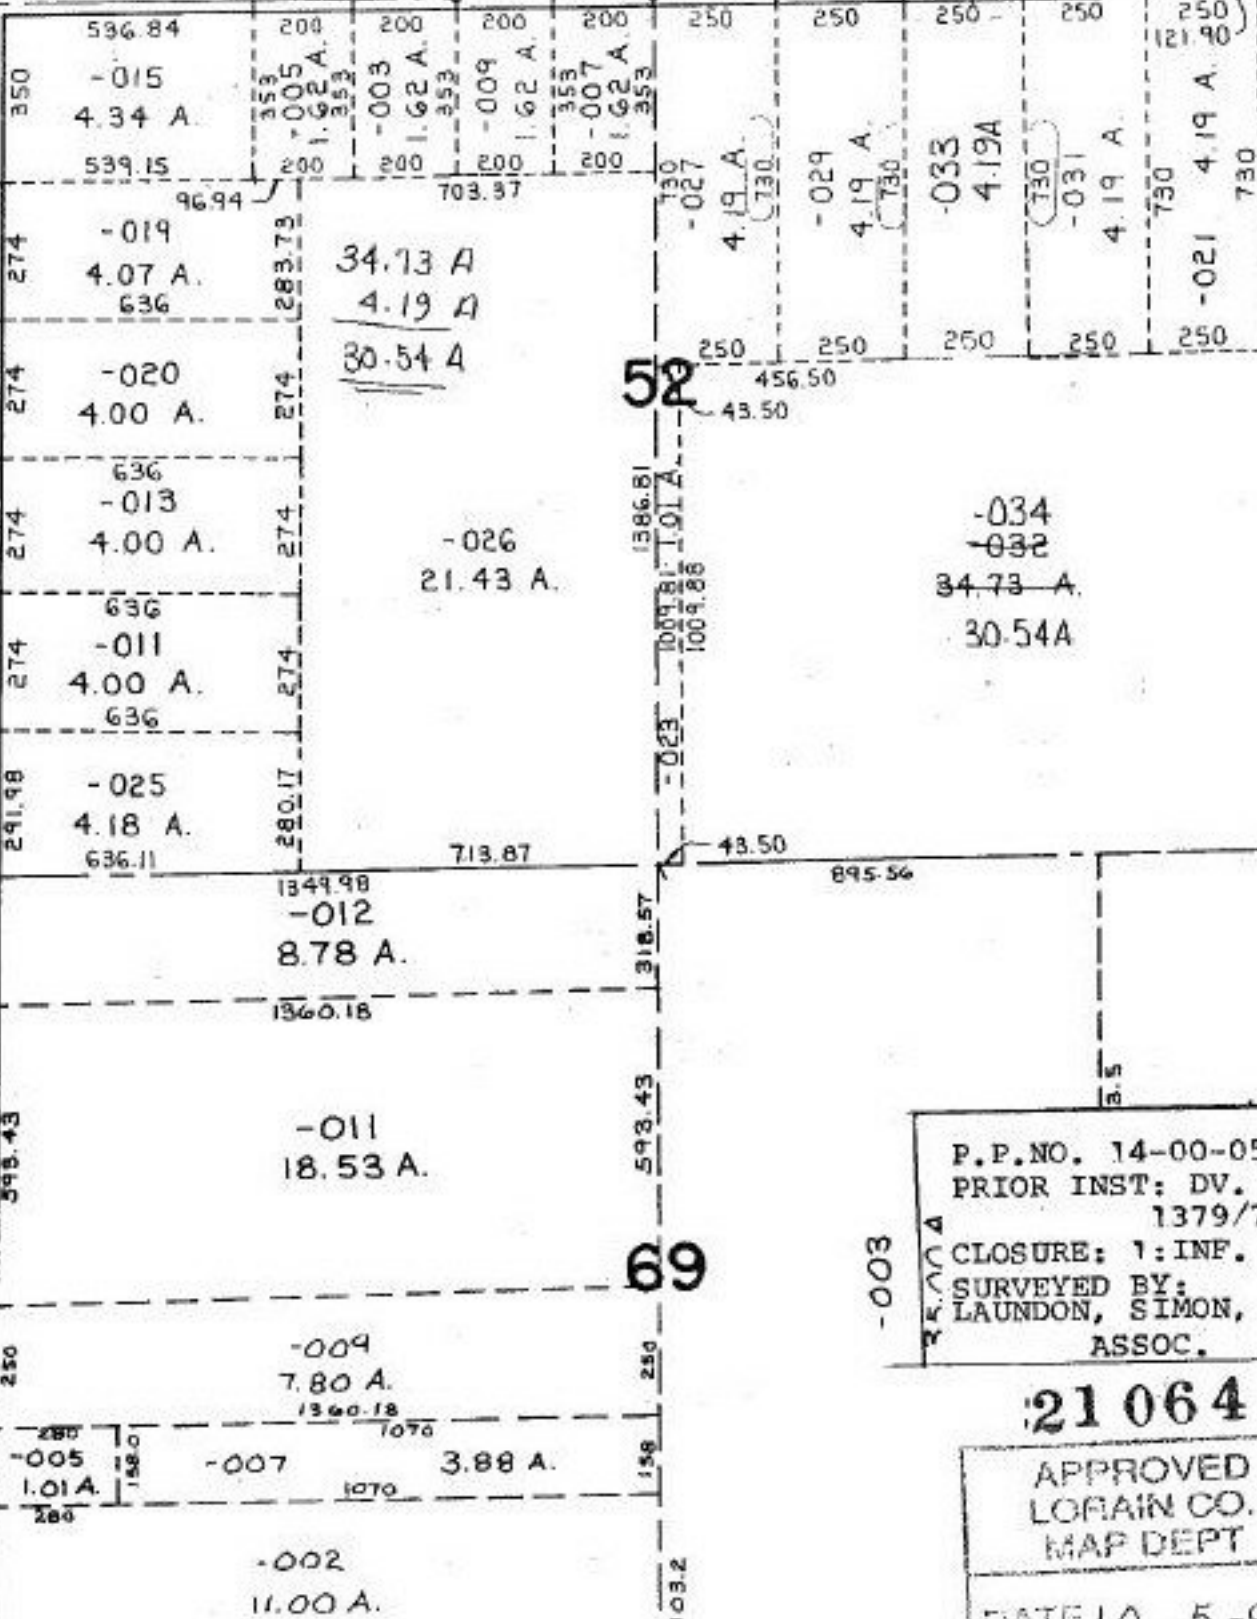

P.P.NO. 14-00-052-000  
 PRIOR INST: DV.  
 1379/748  
 CLOSURE: 1: INF.  
 SURVEYED BY:  
 LAUNDON, SIMON, CAHL &  
 ASSOC.

-003

21064

APPROVED  
 LORAIN CO.  
 MAP DEPT

DATE 10-5-94

PAGE 14-A

BY CAROLYN  
 FRANCIS

#21064