

2107



SEE 2-02-005-A




APPROVED	
LORAIN CO.	
MAP DEPT.	
DATE	9-18-68
BY	R.K.

BLVD.

SEVEN

SETT

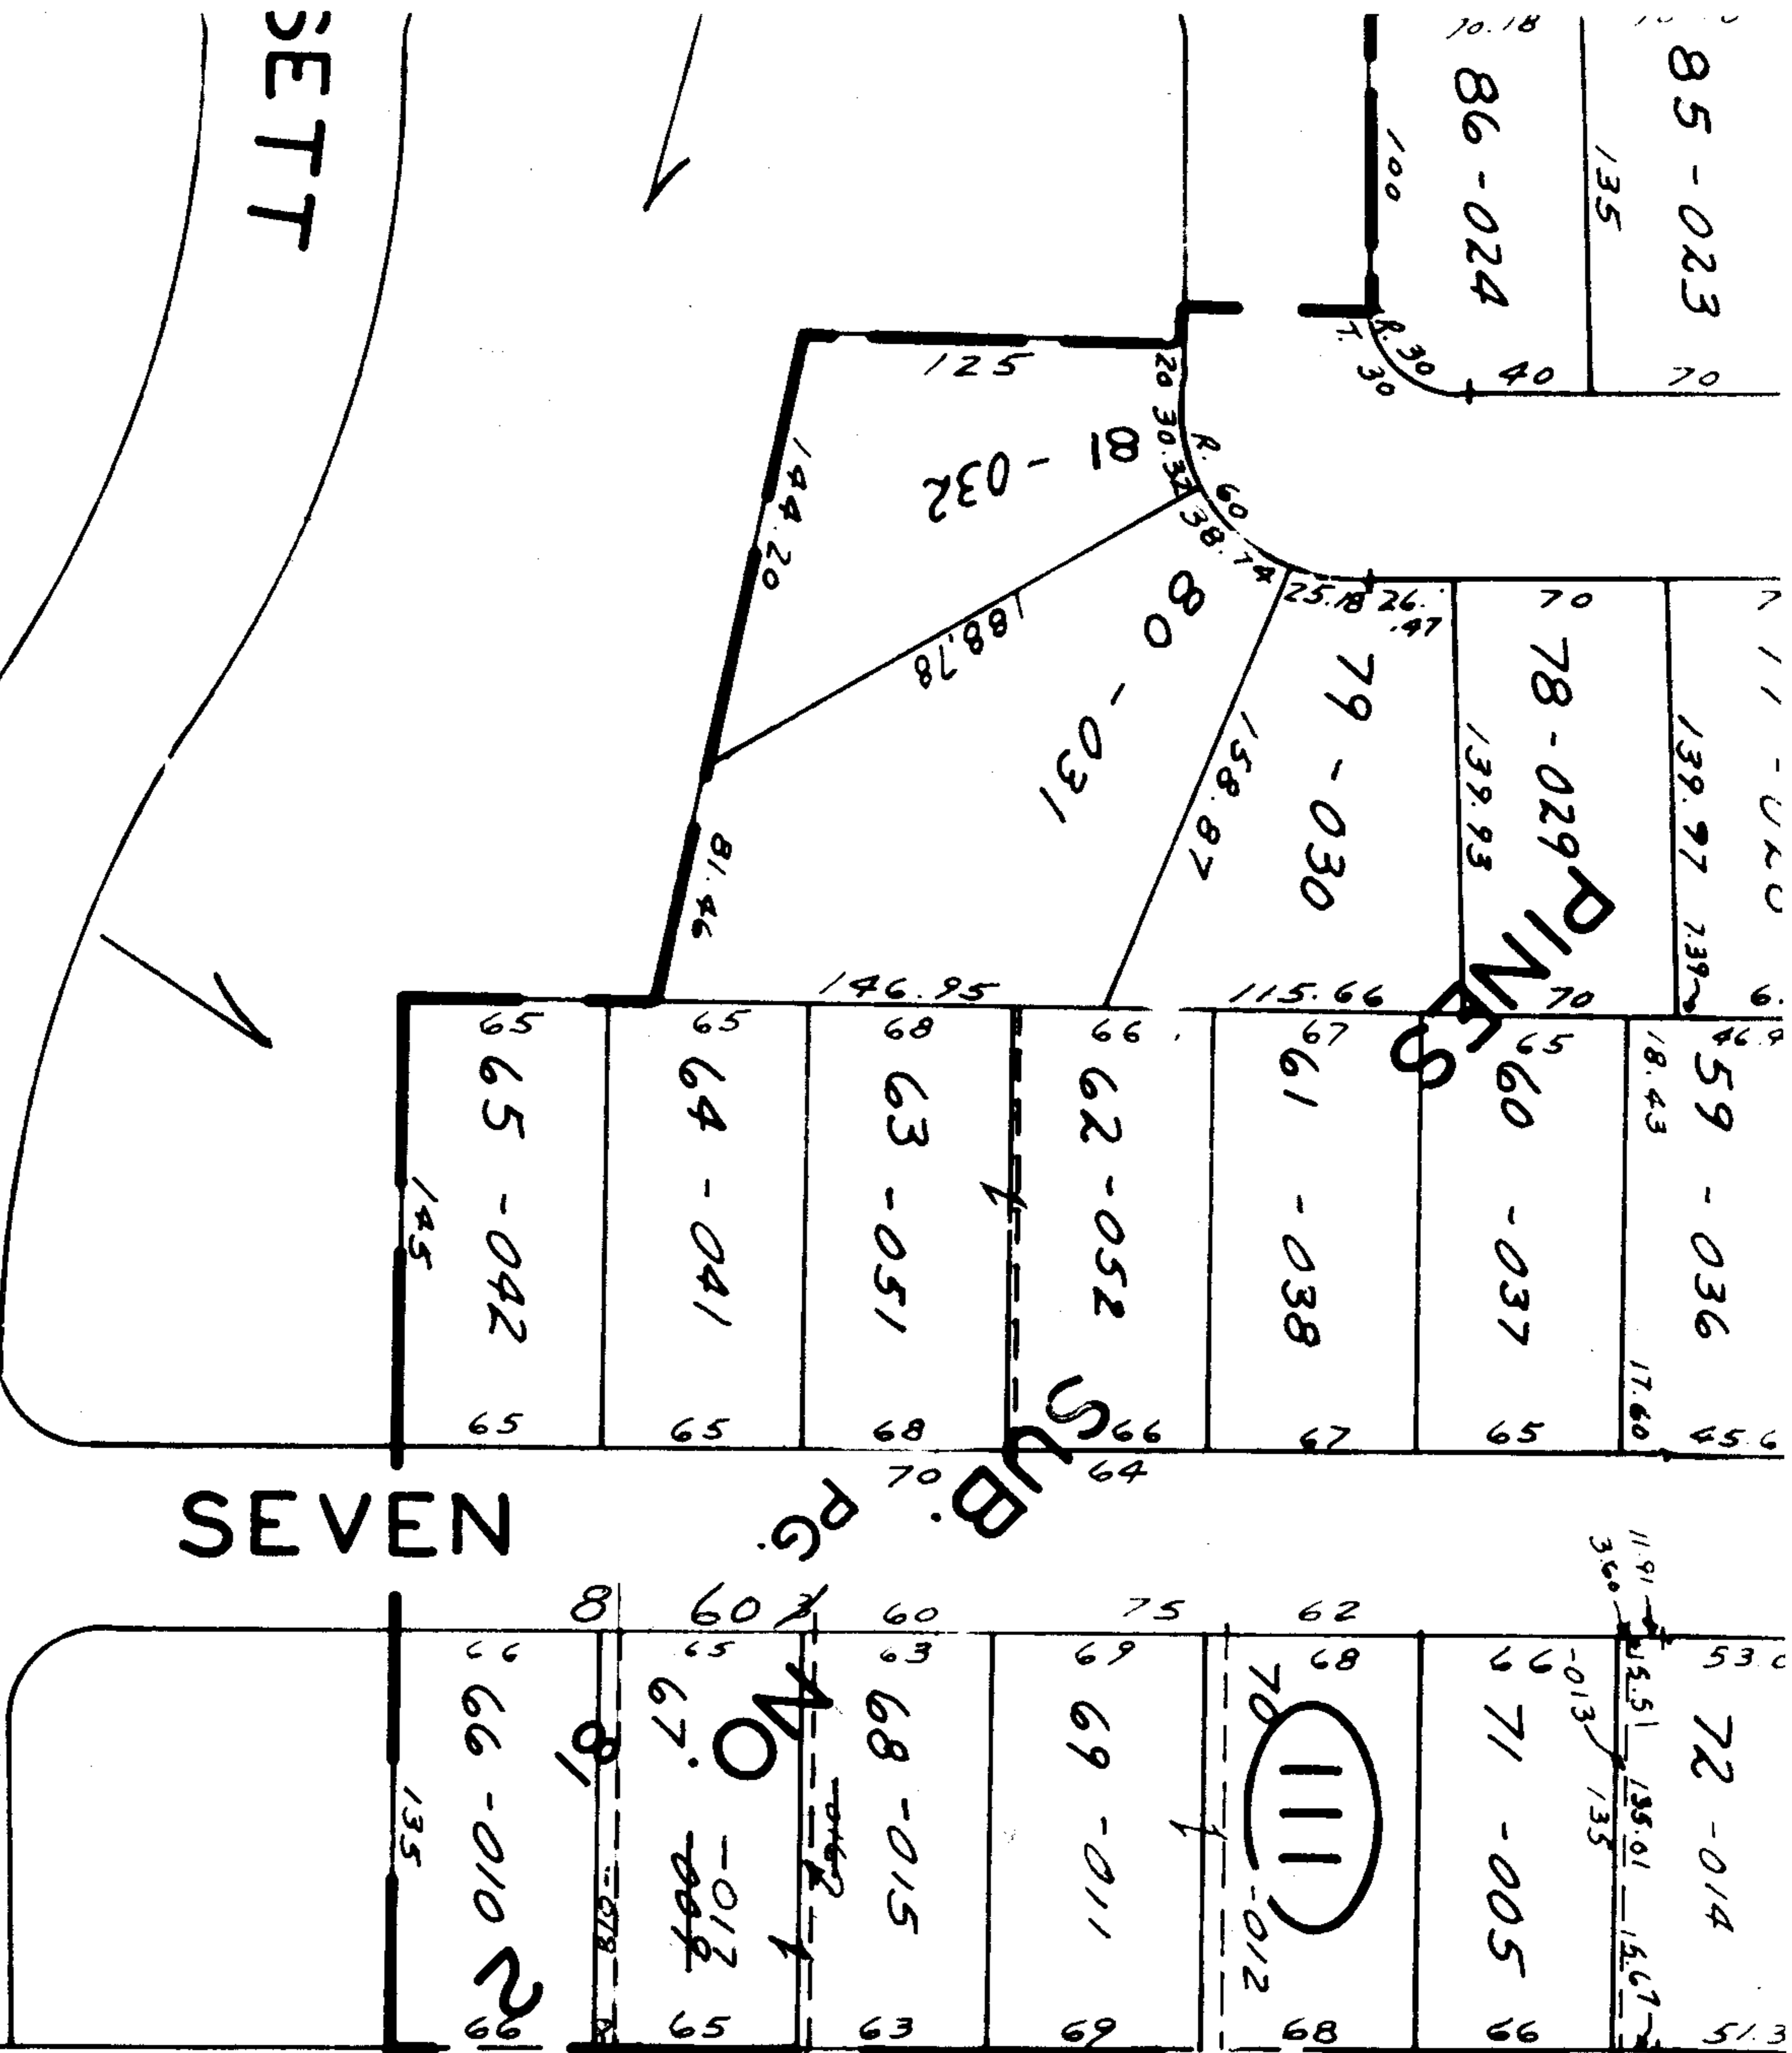

*Done*

*R.K.*

7-31-86