


RONALD
DALE
ROBISON

SEE 7-F

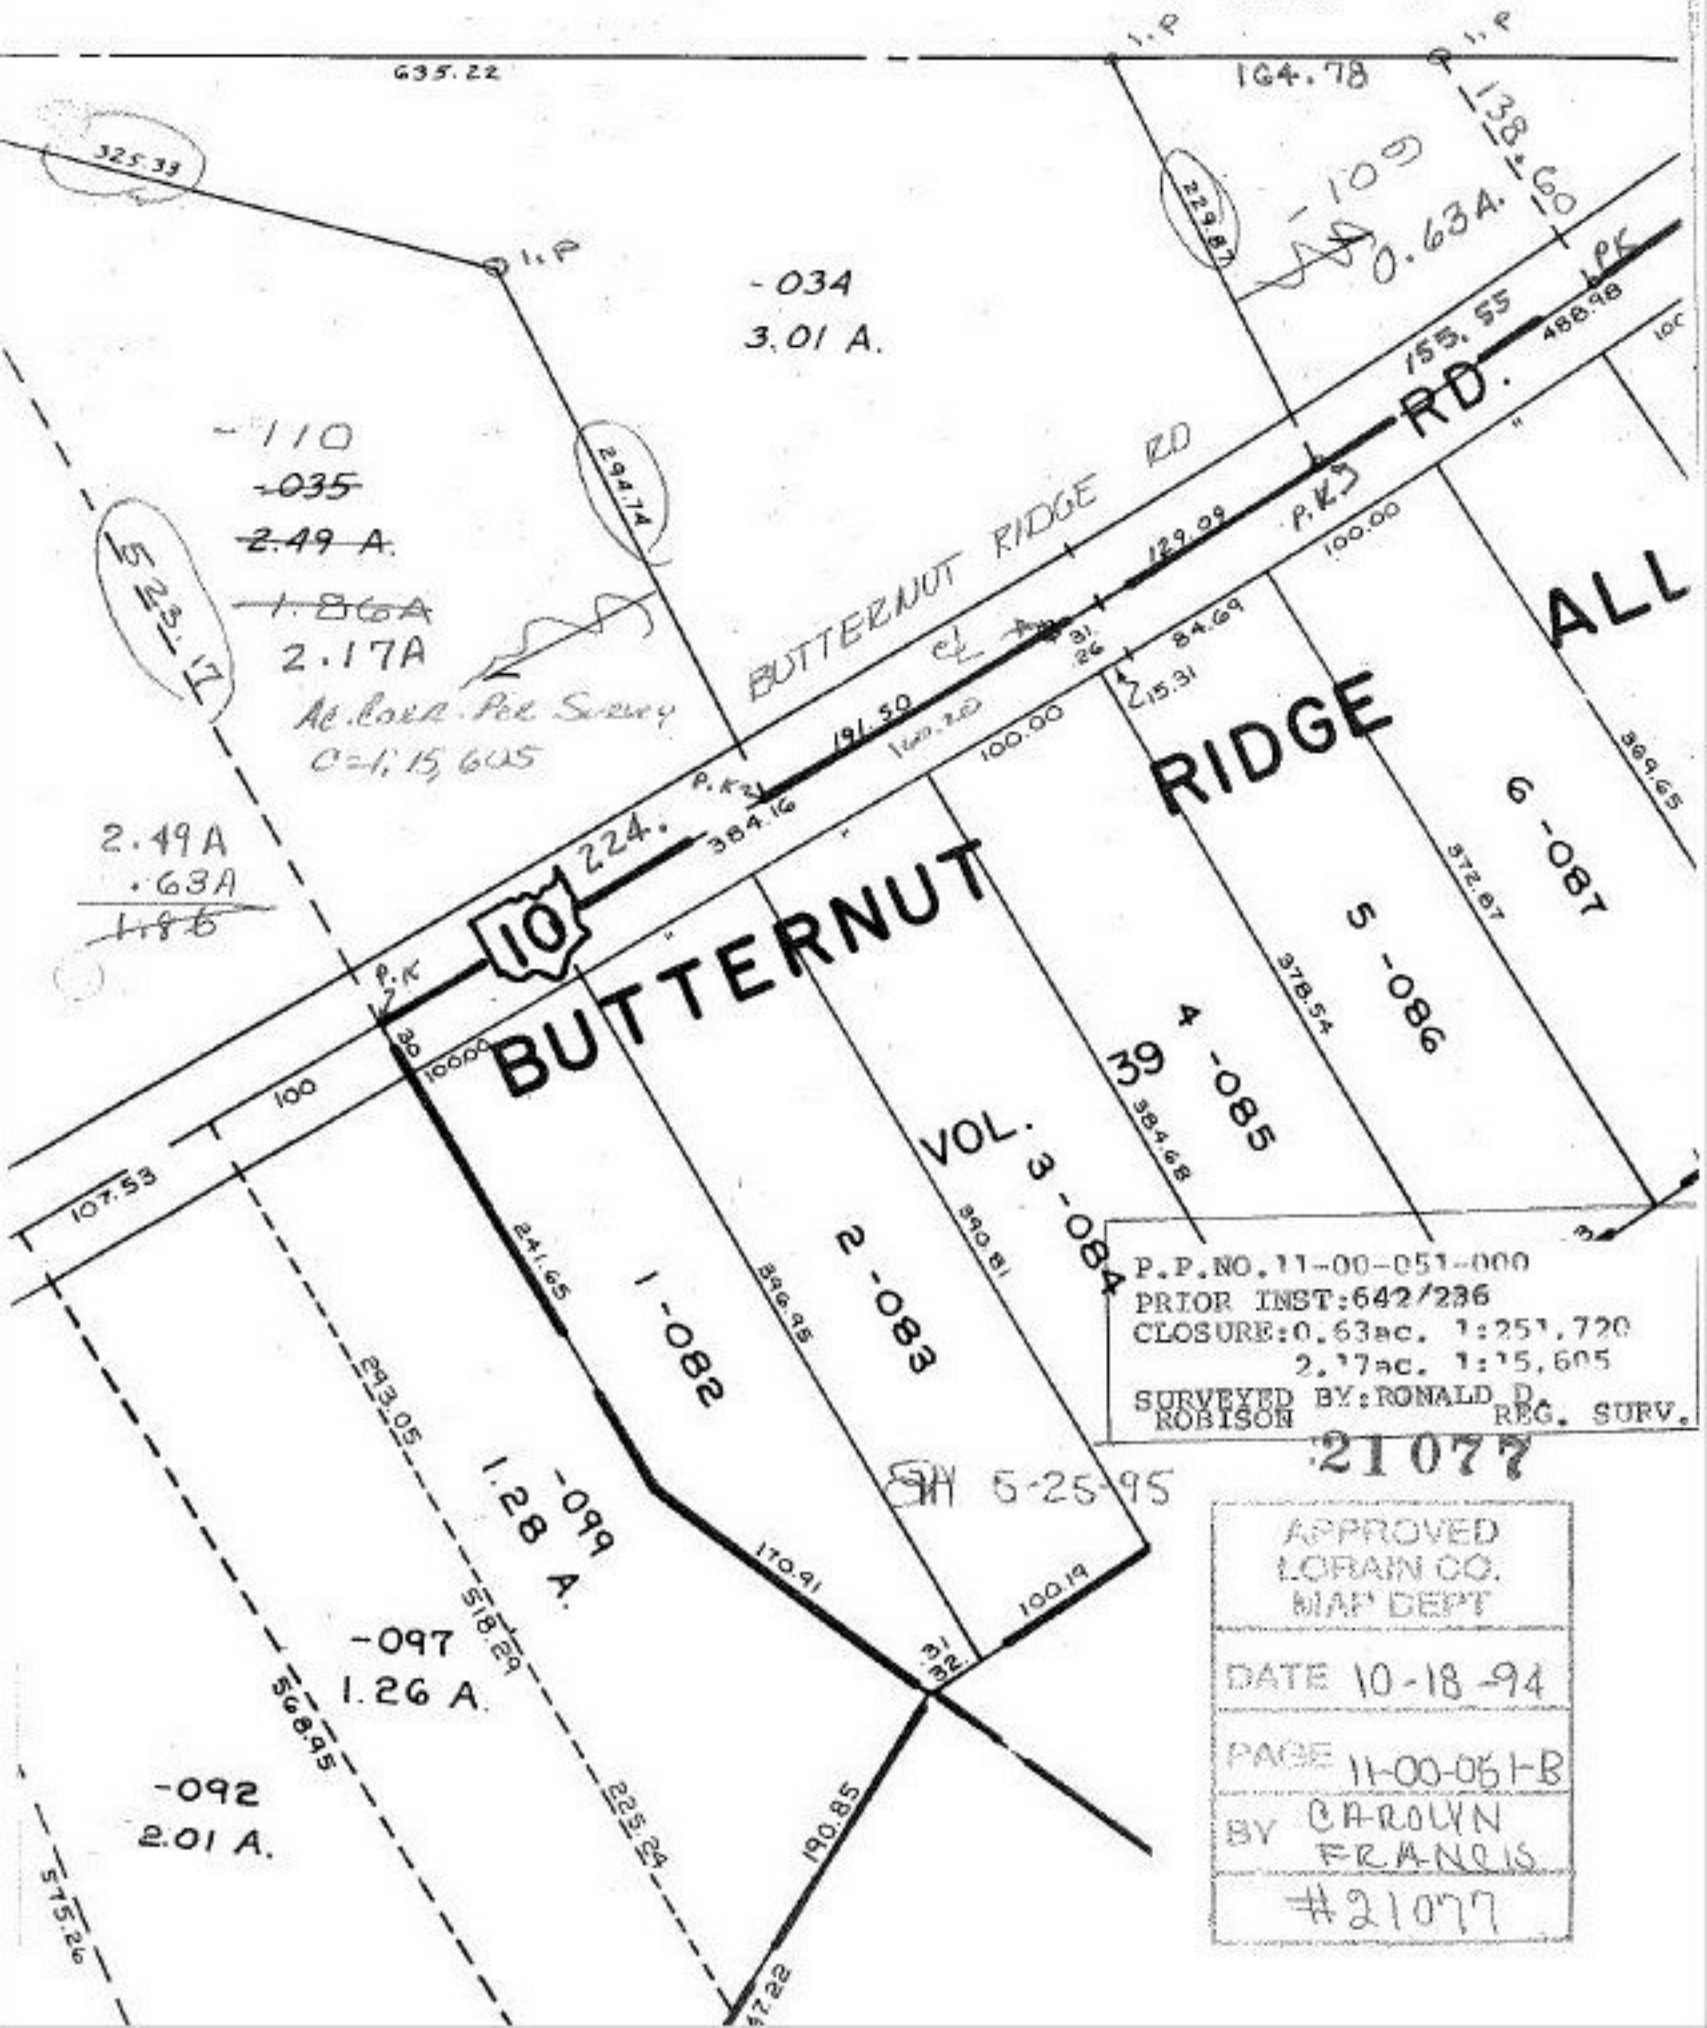

-034
3.01 A.

-110
-035
2.49 A.

1.86A
2.17A
Ac. Cont. Per Survey
C=1, 15, 605

2.49A
.63A
1.86



BUTTERNUT
RIDGE

RIDGE
ALL

P.P. NO. 11-00-051-000
 PRIOR INST: 642/236
 CLOSURE: 0.63 ac. 1:251,720
 2.17 ac. 1:15,605
 SURVEYED BY: RONALD D. ROBISON
 REG. SURV.

21077

APPROVED
 LORAIN CO.
 MAP DEPT

DATE 10-18-94

PAGE 11-00-061-B

BY CAROLYN
 FRANCIS

#21077

5-25-95

515.20

-092
2.01 A.

-097
1.26 A.

-099
1.28 A.

1-082

2-083

VOL. 9-084

39-085

5-086

6-087

635.22

164.78

325.33

229.87

109
0.63A.

138.60

153.55
488.98

294.74

BUTTERNUT RIDGE RD

P.K. 3
100.00

RD

129.09

84.69

215.31

191.50

160.20

100.00

224.

384.16

100

100.00

107.53

241.65

386.95

390.81

384.68

243.05

518.29

568.95

170.91

100.19

190.85

17.22

100

369.65

372.87

378.54