


11-00-100-A

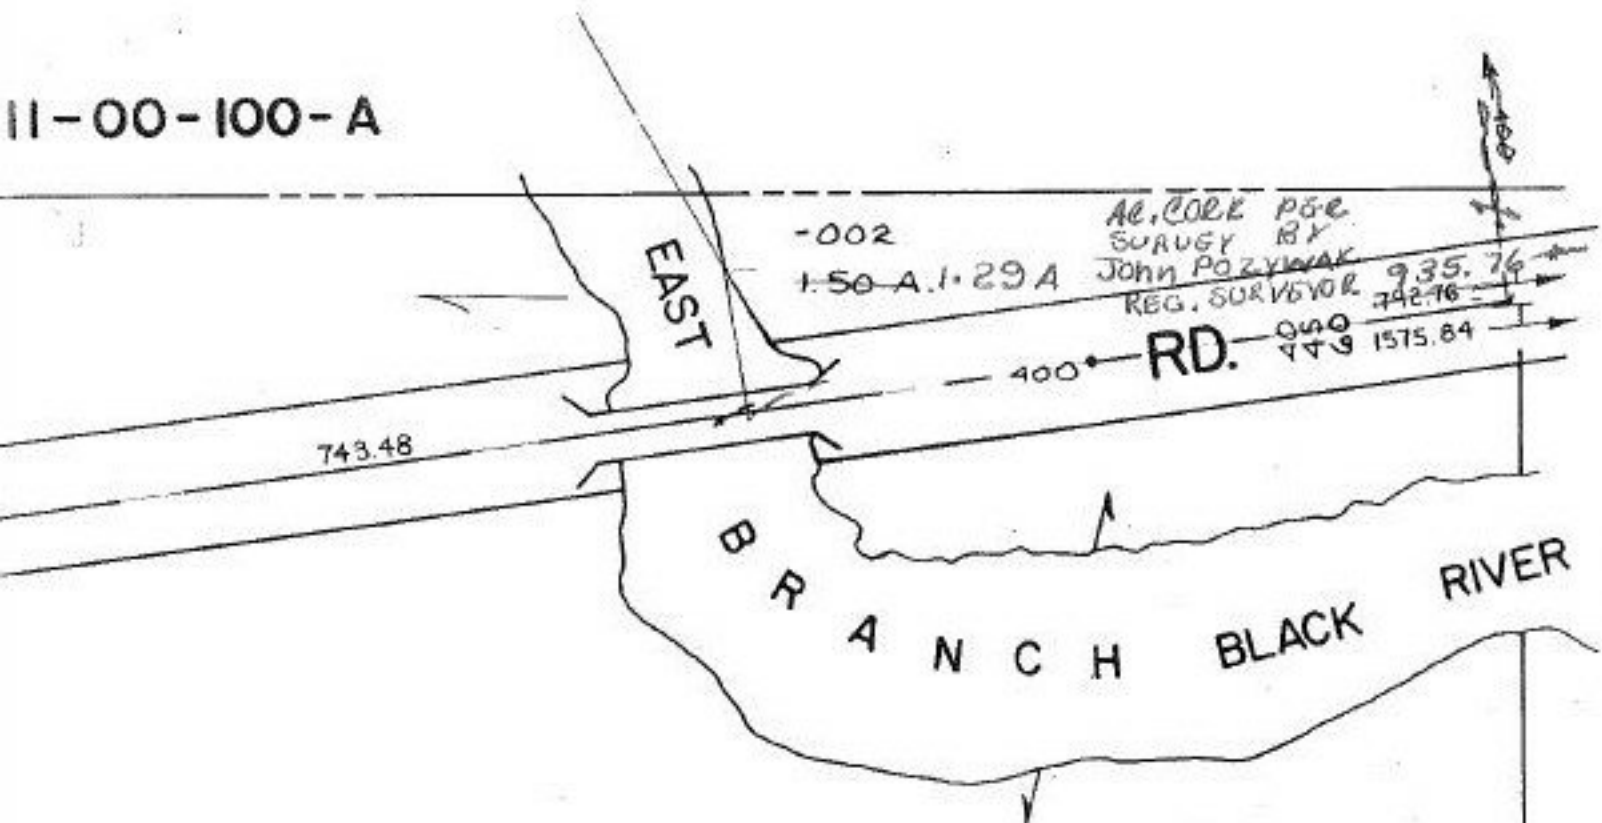

5-26-95

P.P. NO. 16-00-001-101-

PRIOR INST: DV 306/474

CLOSURE: 66,869

SURVEYED BY: JOHN POZYWAK
REG. SURVEY

21089

Acre. Collection

APPROVED
LOPAIN CO.
MAP DEPT

DATE 10-25-94

PAGE 16-00-001A

BY CAROLYN
FRANCIS

21089

19
4 A.

