


-001
54.00 A.

4.61A
5.48A
10.09

342.89
342.54
.35
392.50
391.91
.59

-002
27.75 A.
94

**NO CHANGES
OF TAX MAP**

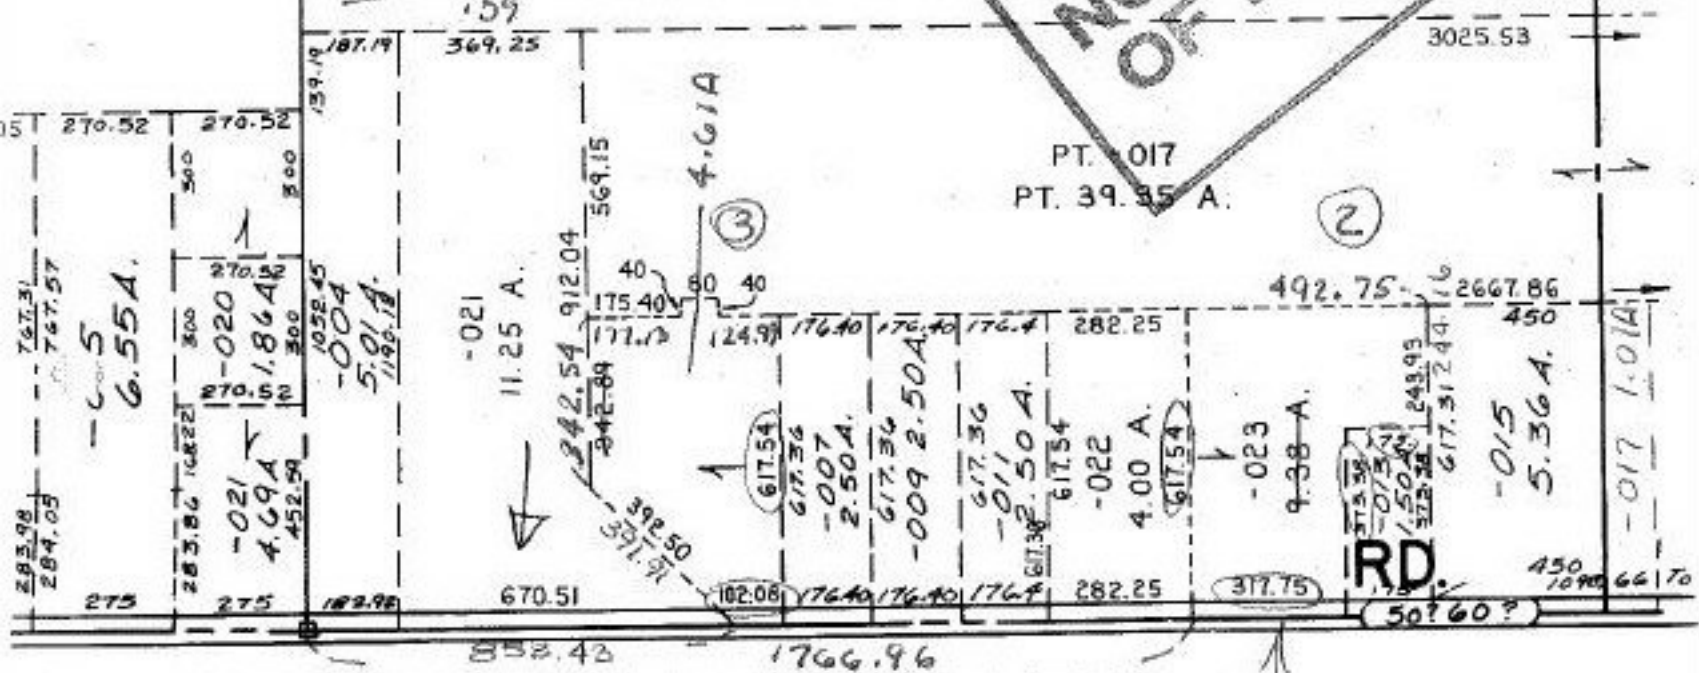

LAGRANGE TWF

SCALE 1" = 400'

DEED (1) #21091A AC. CORR. CAN NOT BE DONE UNLESS
PARCELS 15-00-093-000-004 1.50 ac.
-019 9.39 ac.
-10.89 ac. perpose
10.19 ac. ac. correction

DEED (2) NO AC. CORR. CAN BE DONE UNLESS
LEGAL BE WRITTEN AS ONE PARCEL.
LEGAL BE DONE AS A SPLIT. MUST GO THROUGH SPLIT
EASEMENT PROCEDURE:
15-00-094-000-023

SEE # 21115 FOR COMB/AC.
CORR.

6/7/95
21091A

APPROVED LORAIN CO. MAP DEPT
DATE 10-28-94
PAGE 15-3
BY CAROLYN FRANCIS
21091A