

CRESS 17

(102) P. 28 1.16A.


5-012 1.16A.

2110

6-013 1.16A.

7-014 1.24A. 842.5


APPROVED
LORAIN CO.

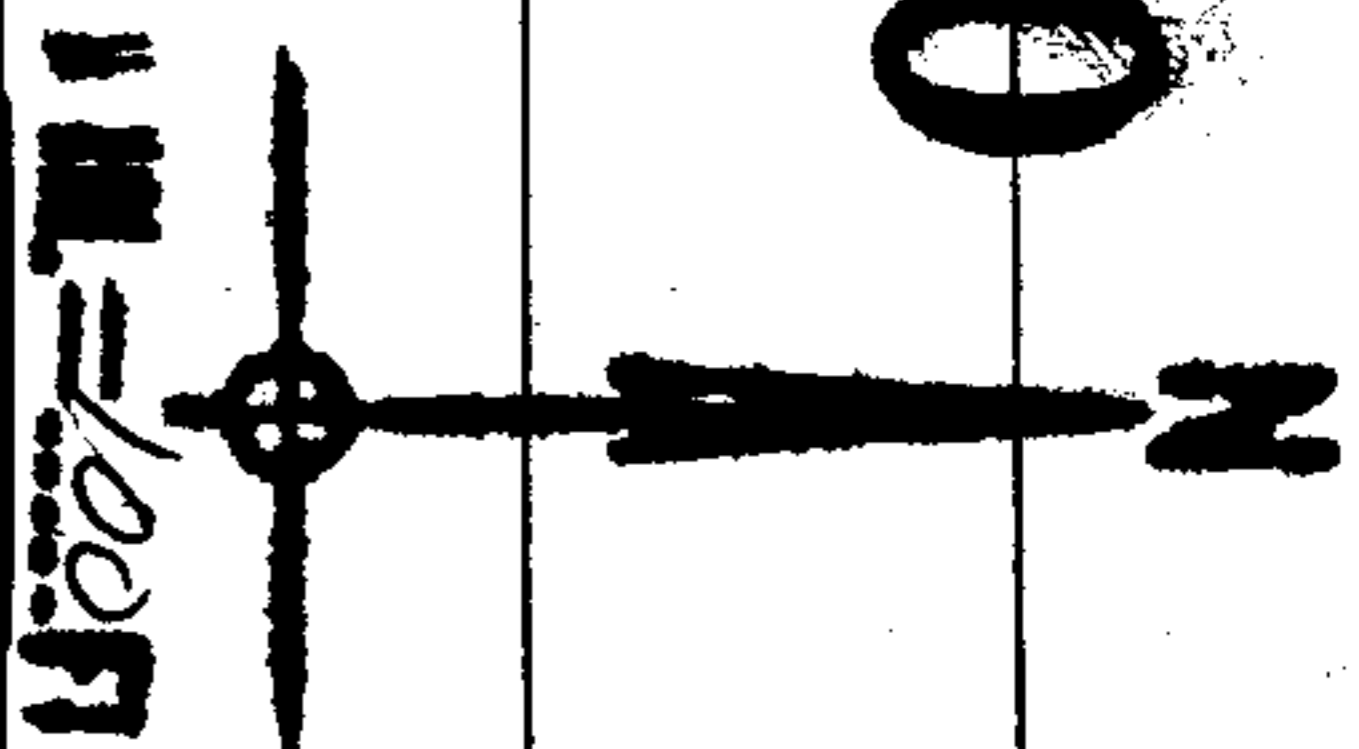

MAP DEPT.
DATE 6-18-68
BY [Signature]

301 381.92

GULF

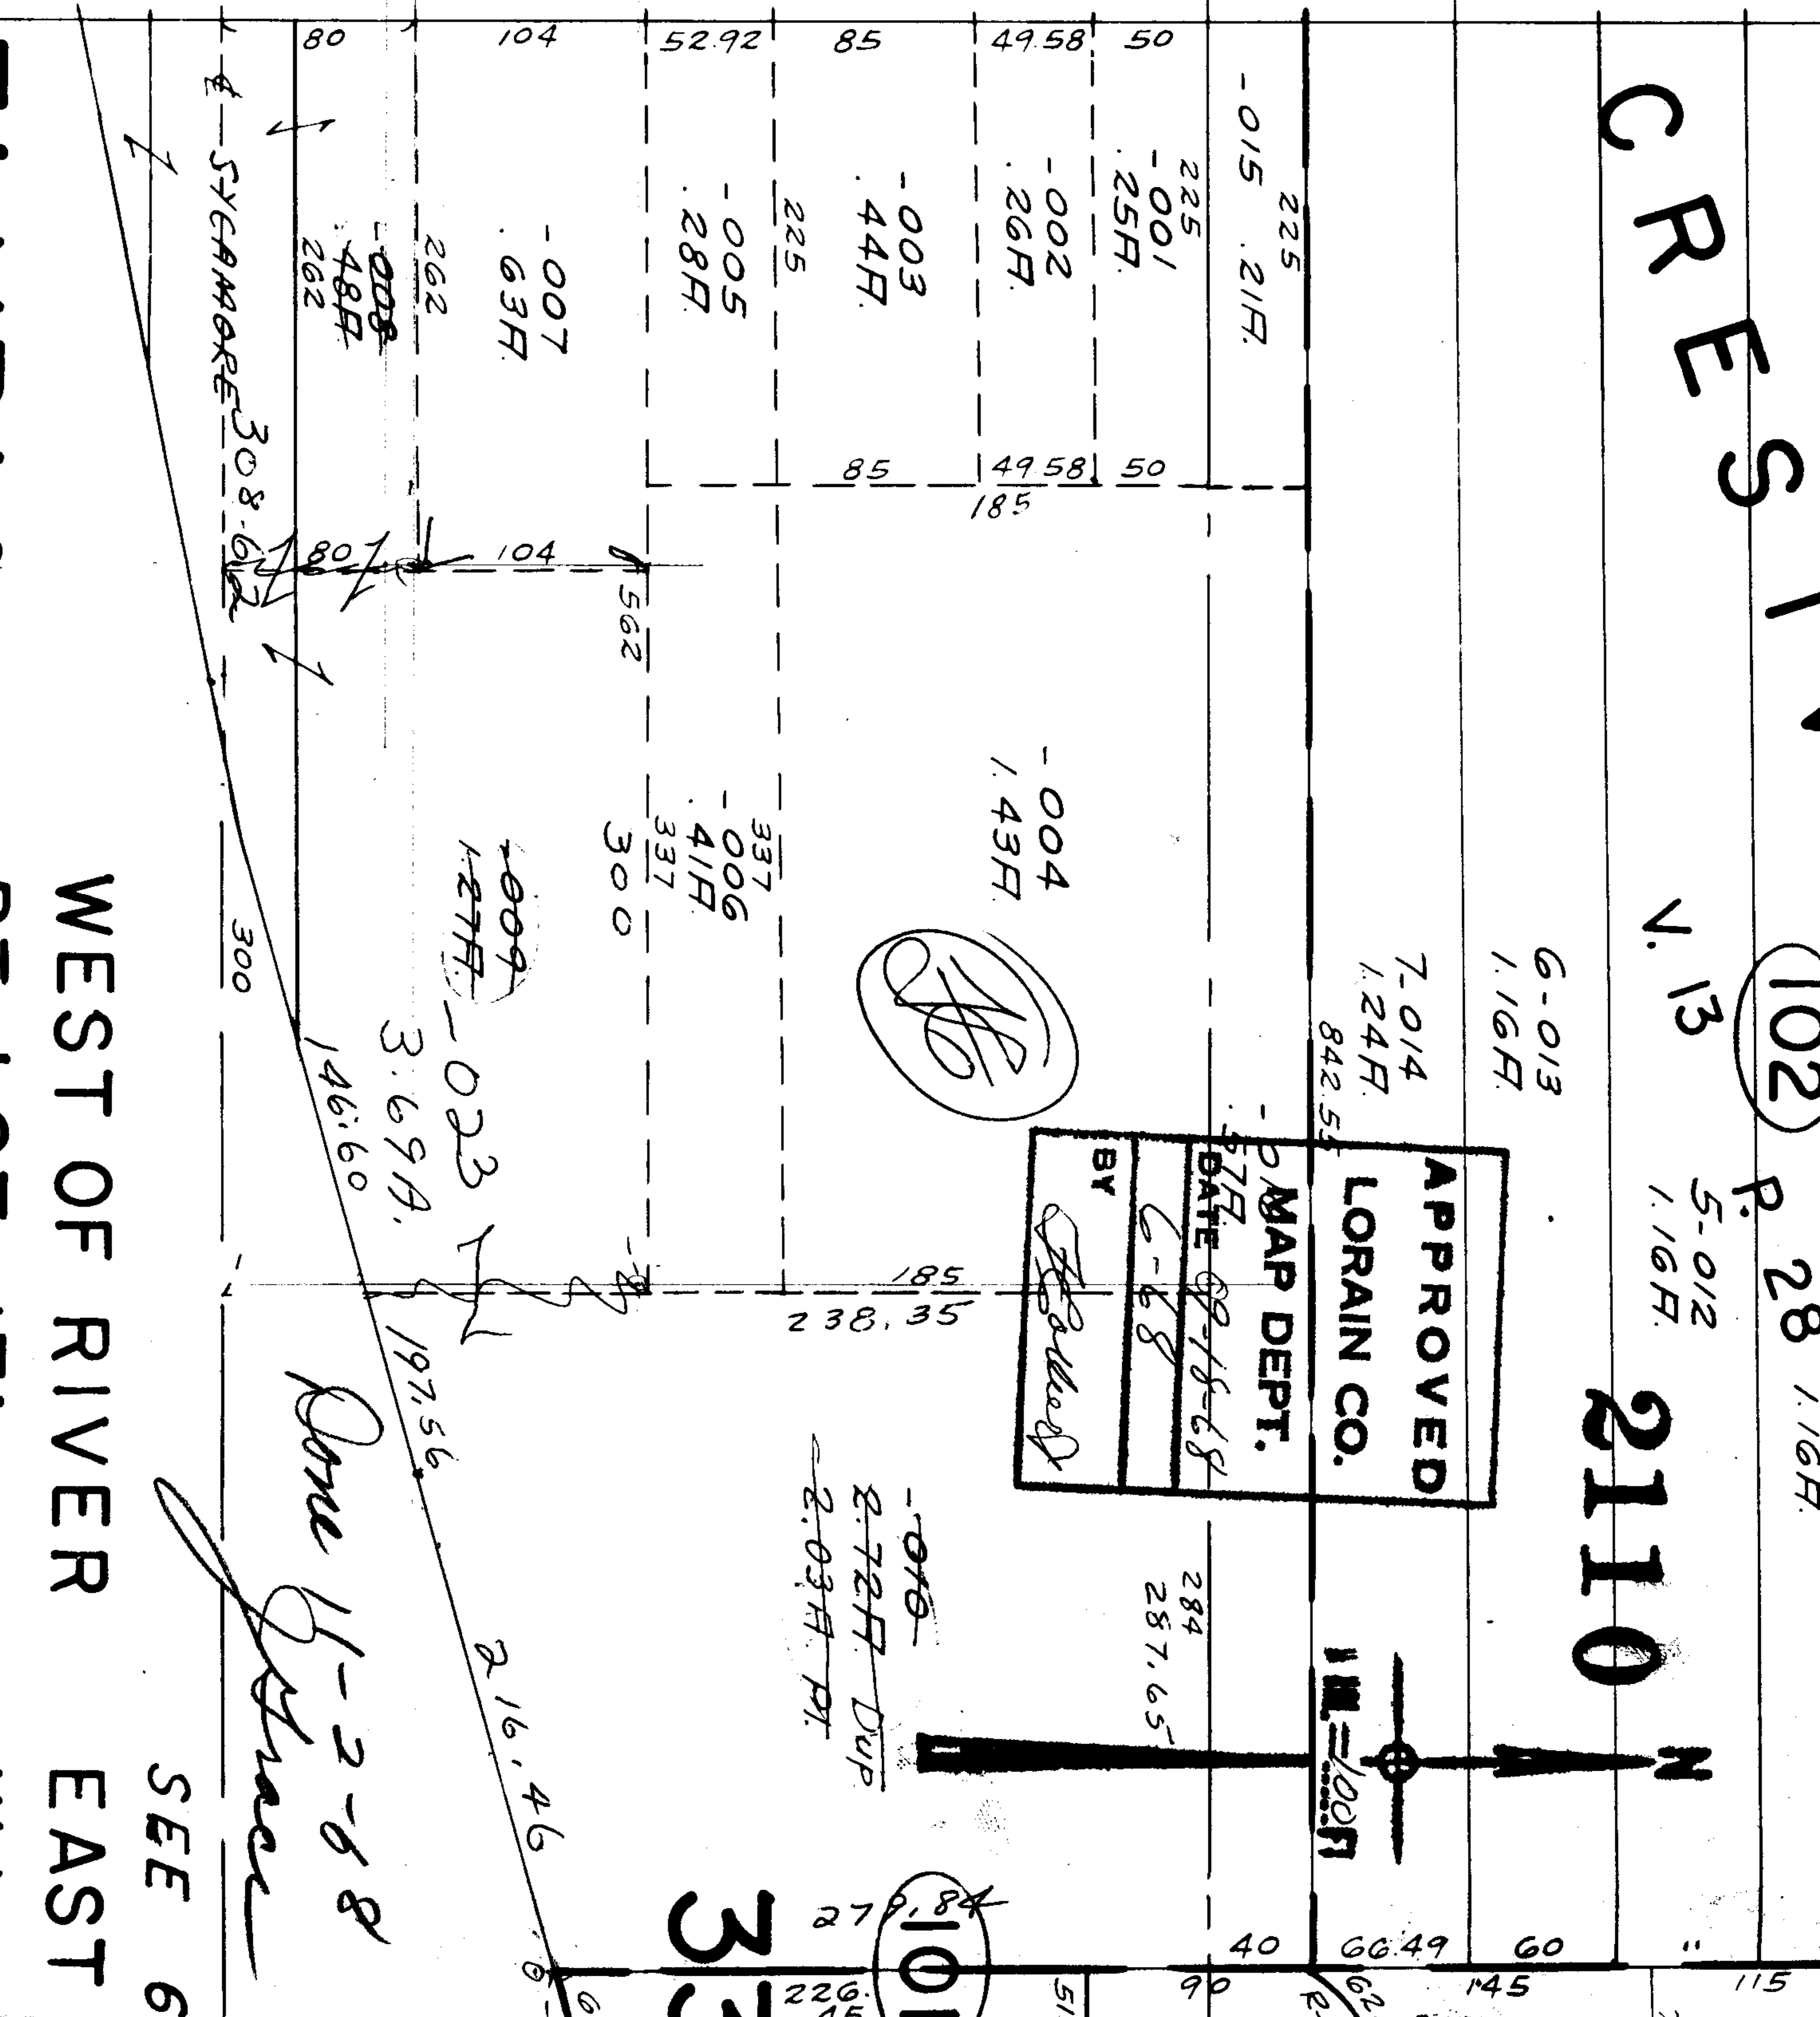

ELYRIA

SCALE: 1" = 100'

WEST OF RIVER EAST

PT. LOT 171

SEE 6

W 171

E 171

S 171

N 171