


#21100-A

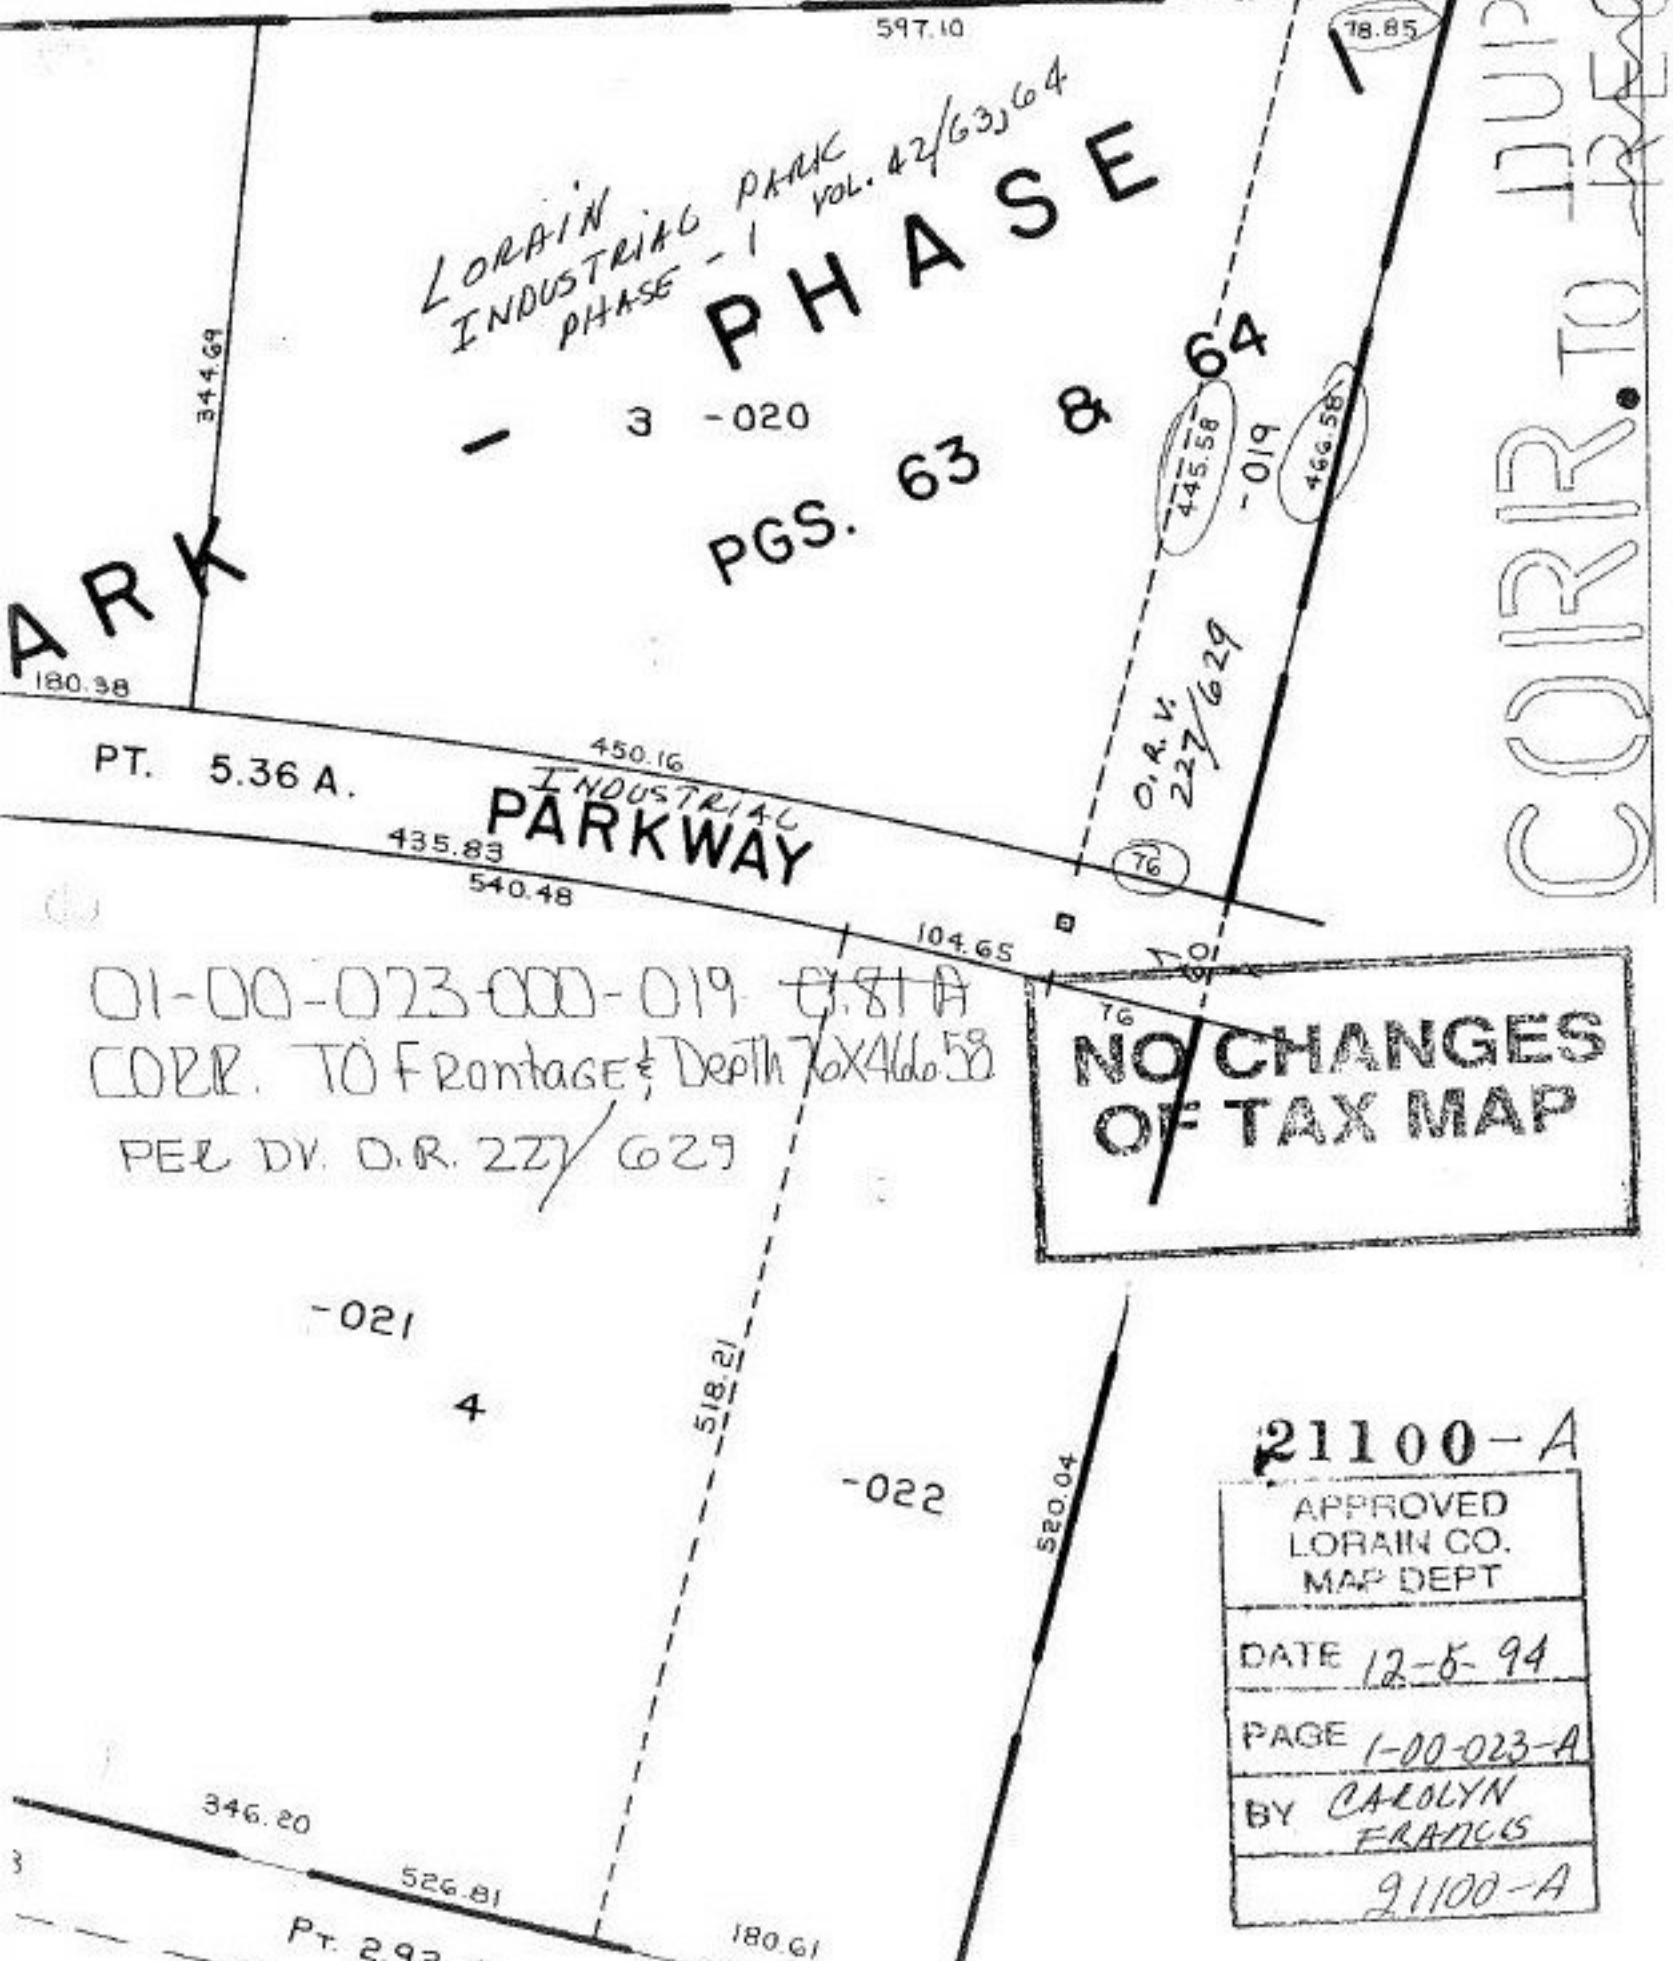

LORAIN INDUSTRIAL PHASE - 1  
 PHASE  
 VOL. 42/63/64

PHASE

3 - 020

PGS. 63 & 64

ARK  
 180.38

PT. 5.36 A.

INDUSTRIAL PARKWAY

01-00-023-000-019 EX. 81A  
 CORR. TO FRONTAGE & DEPTH 76X466.58  
 PER DV. O.R. 227/629

**NO CHANGES OF TAX MAP**

-021

4

-022

21100-A

APPROVED LORAIN CO. MAP DEPT
DATE 12-5-94
PAGE 1-00-023-A
BY CAROLYN FRANCIS
21100-A

PT. 2.93 A

CORR. TO RES.