


SEE 3-00-C-A  
 1623.77  
 AD. - 1393.9  
 HARRIS

21108

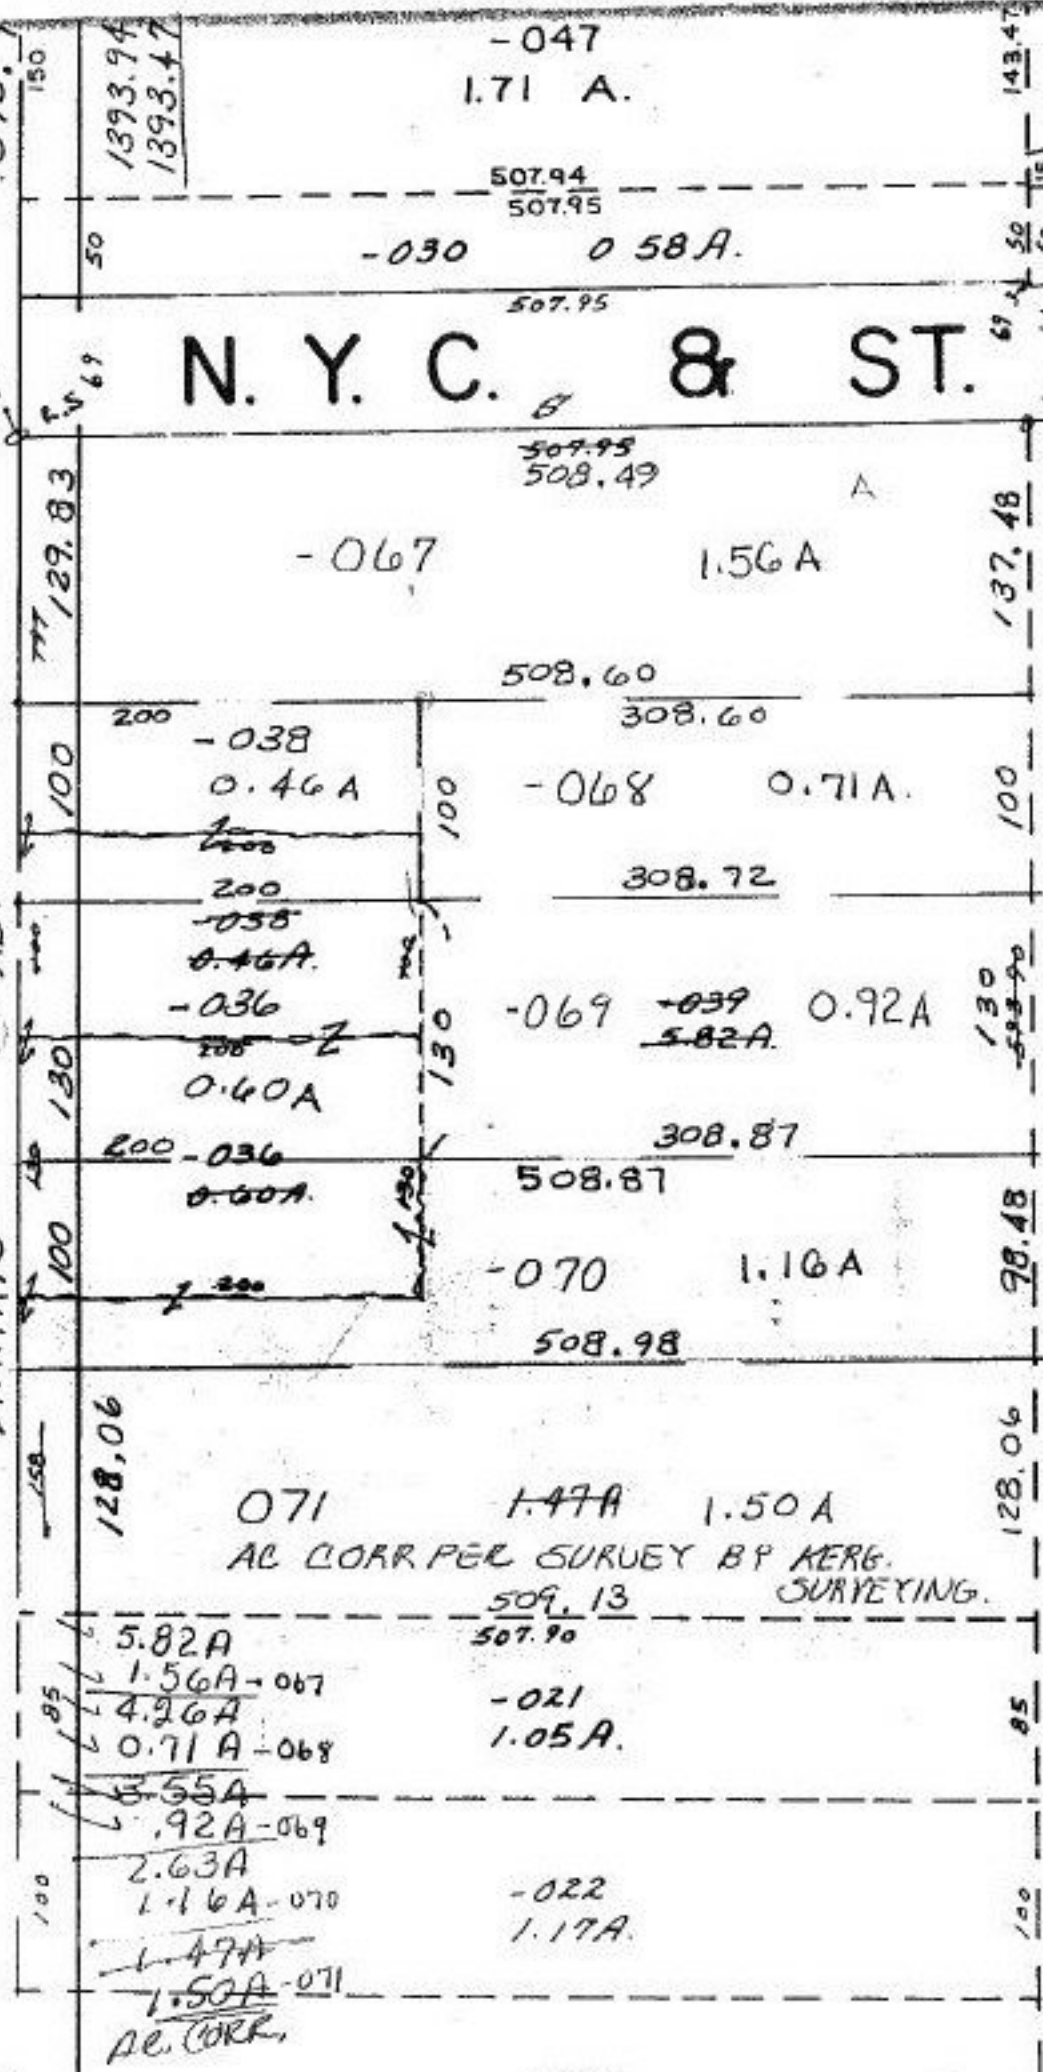

N. Y. C. & ST. L. Pt. -001  
 Pt. 7.752 A.

PP. NO. 03-00-024-000  
 PRIOR INST:  
 CLOSURE: 1.56 ac.  
 1:152,326 0.71 ac.  
 1:176,997 0.92 ac.  
 1:3917,957 1.16 ac.  
 1:269,670 1.50 ac.  
 1:566,789  
 SURVEYED BY: CHARLES  
 A. KERG. REG. SURVEYOR

21108

APPROVED  
 LORAIN CO.  
 MAP DEPT  
 DATE 11-7-94  
 PAGE 3-00-024A  
 BY CAROLYN  
 FRANCIS  
 #21108