


WAKEMAN - LAGRANGE - RICHFIELD

303

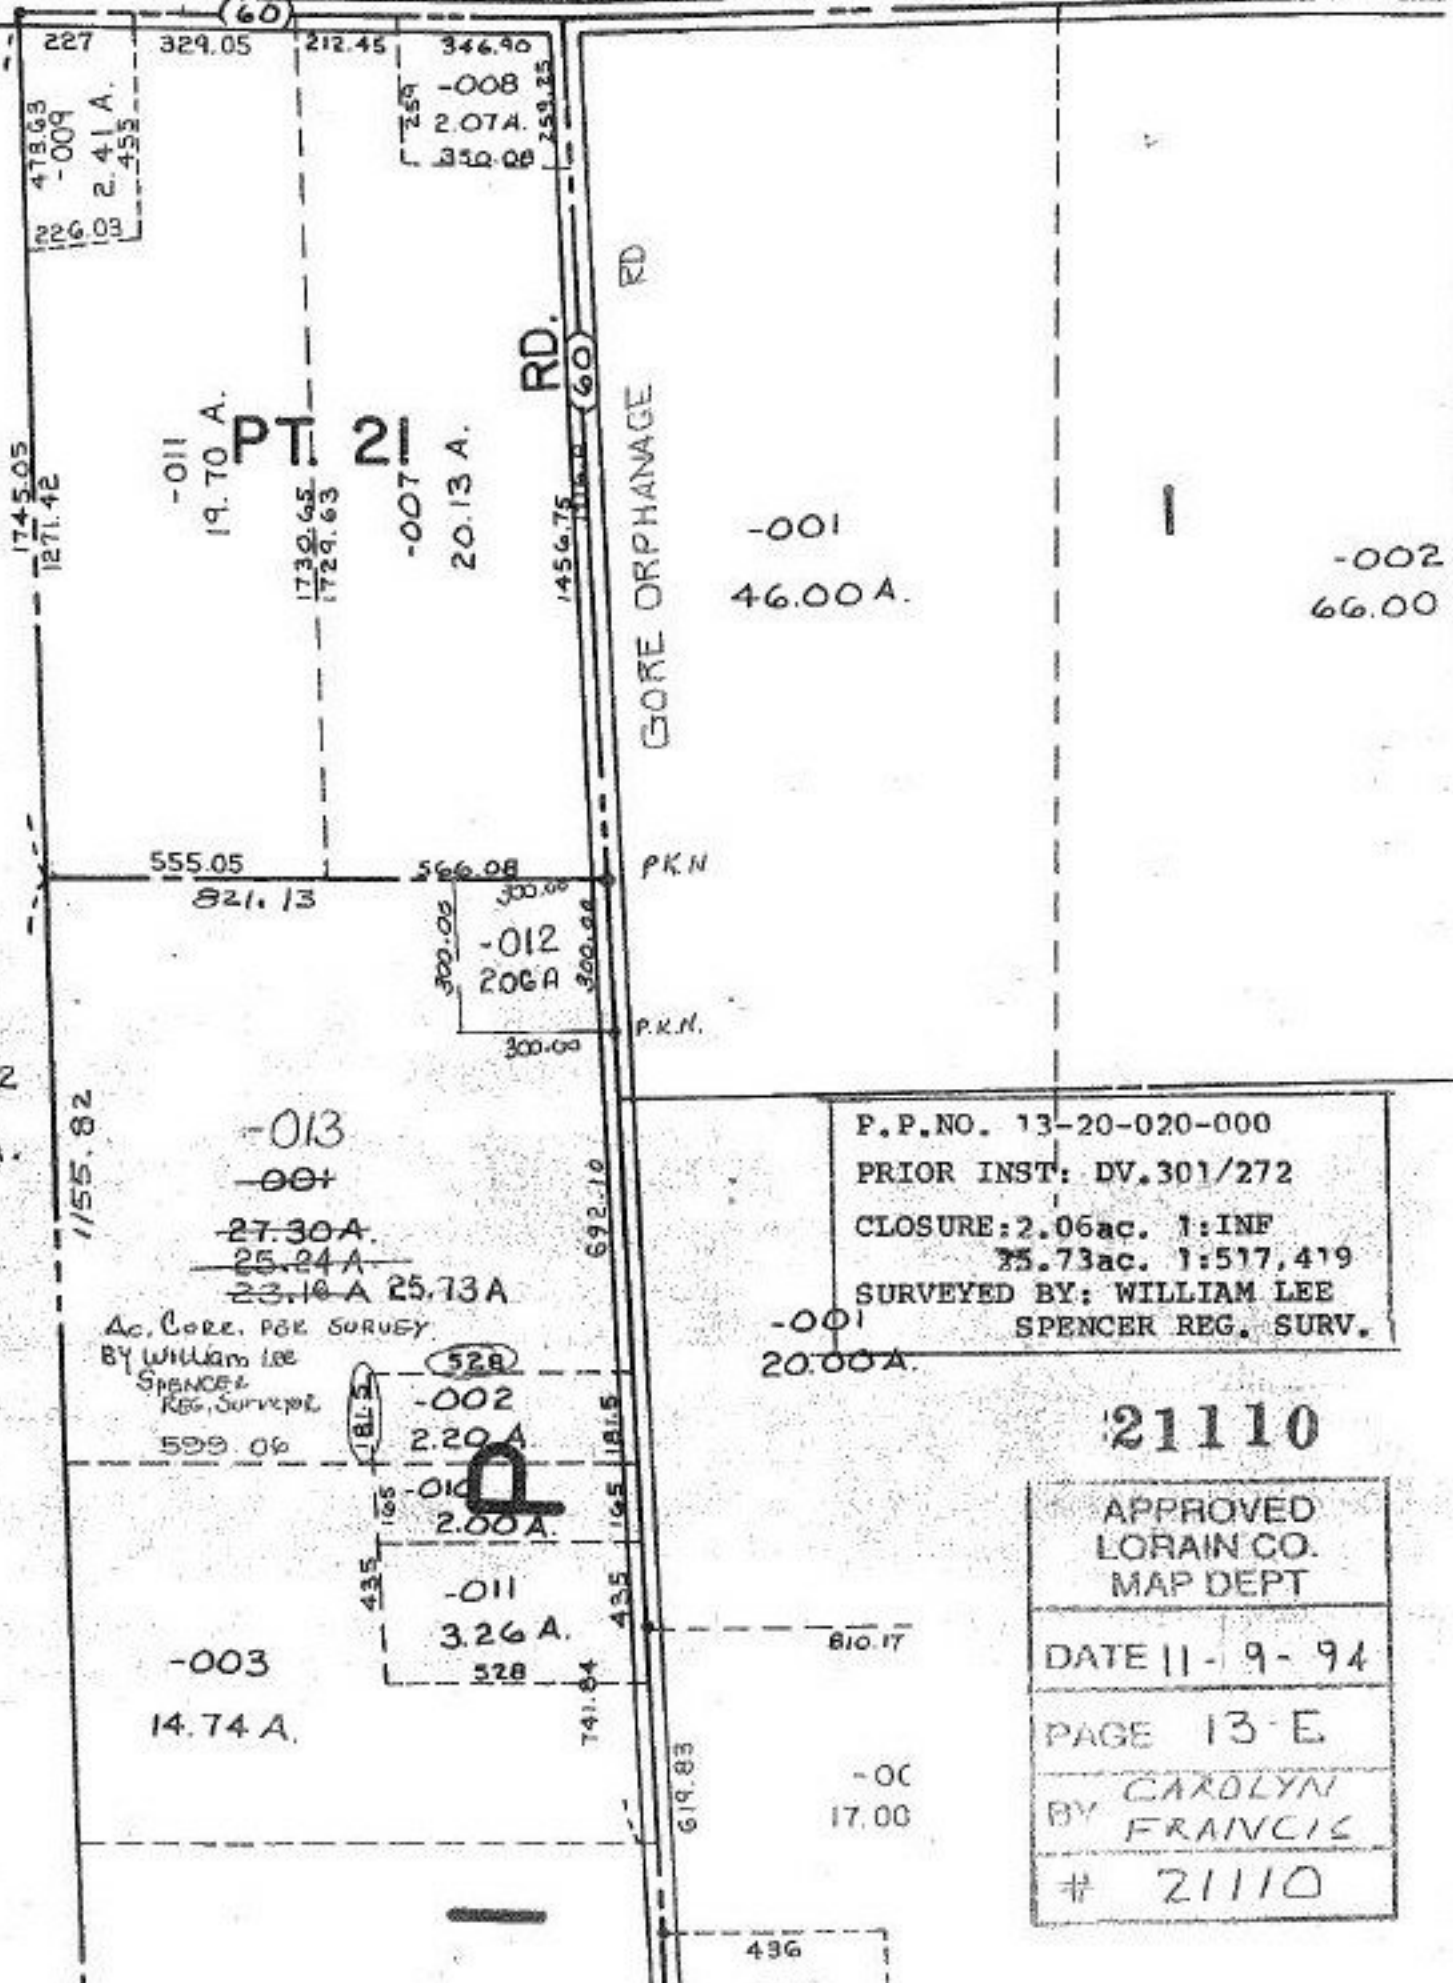

~~21.30 A~~
~~2.06 A~~
~~25.24 A~~
 DEED
 23-16-22
 CALC
 25.73A.

-013
 -004
~~27.30 A~~
~~25.24 A~~
~~23.18 A~~ 25.73A
 Ac. Core. per survey
 BY WILLIAM LEE
 SPENCER
 REG. SURVEYOR
 599.06

P.P. NO. 13-20-020-000
 PRIOR INST: DV.301/272
 CLOSURE: 2.06ac. 1:INF
 25.73ac. 1:517,419
 SURVEYED BY: WILLIAM LEE
 SPENCER REG. SURV.

21110

APPROVED
 LORAIN CO.
 MAP DEPT
 DATE 11-9-94
 PAGE 13-E
 BY CAROLYN
 FRANCIS
 # 21110