


21112

Pt -176 -180  
R. 16.15A 15.27Ac.

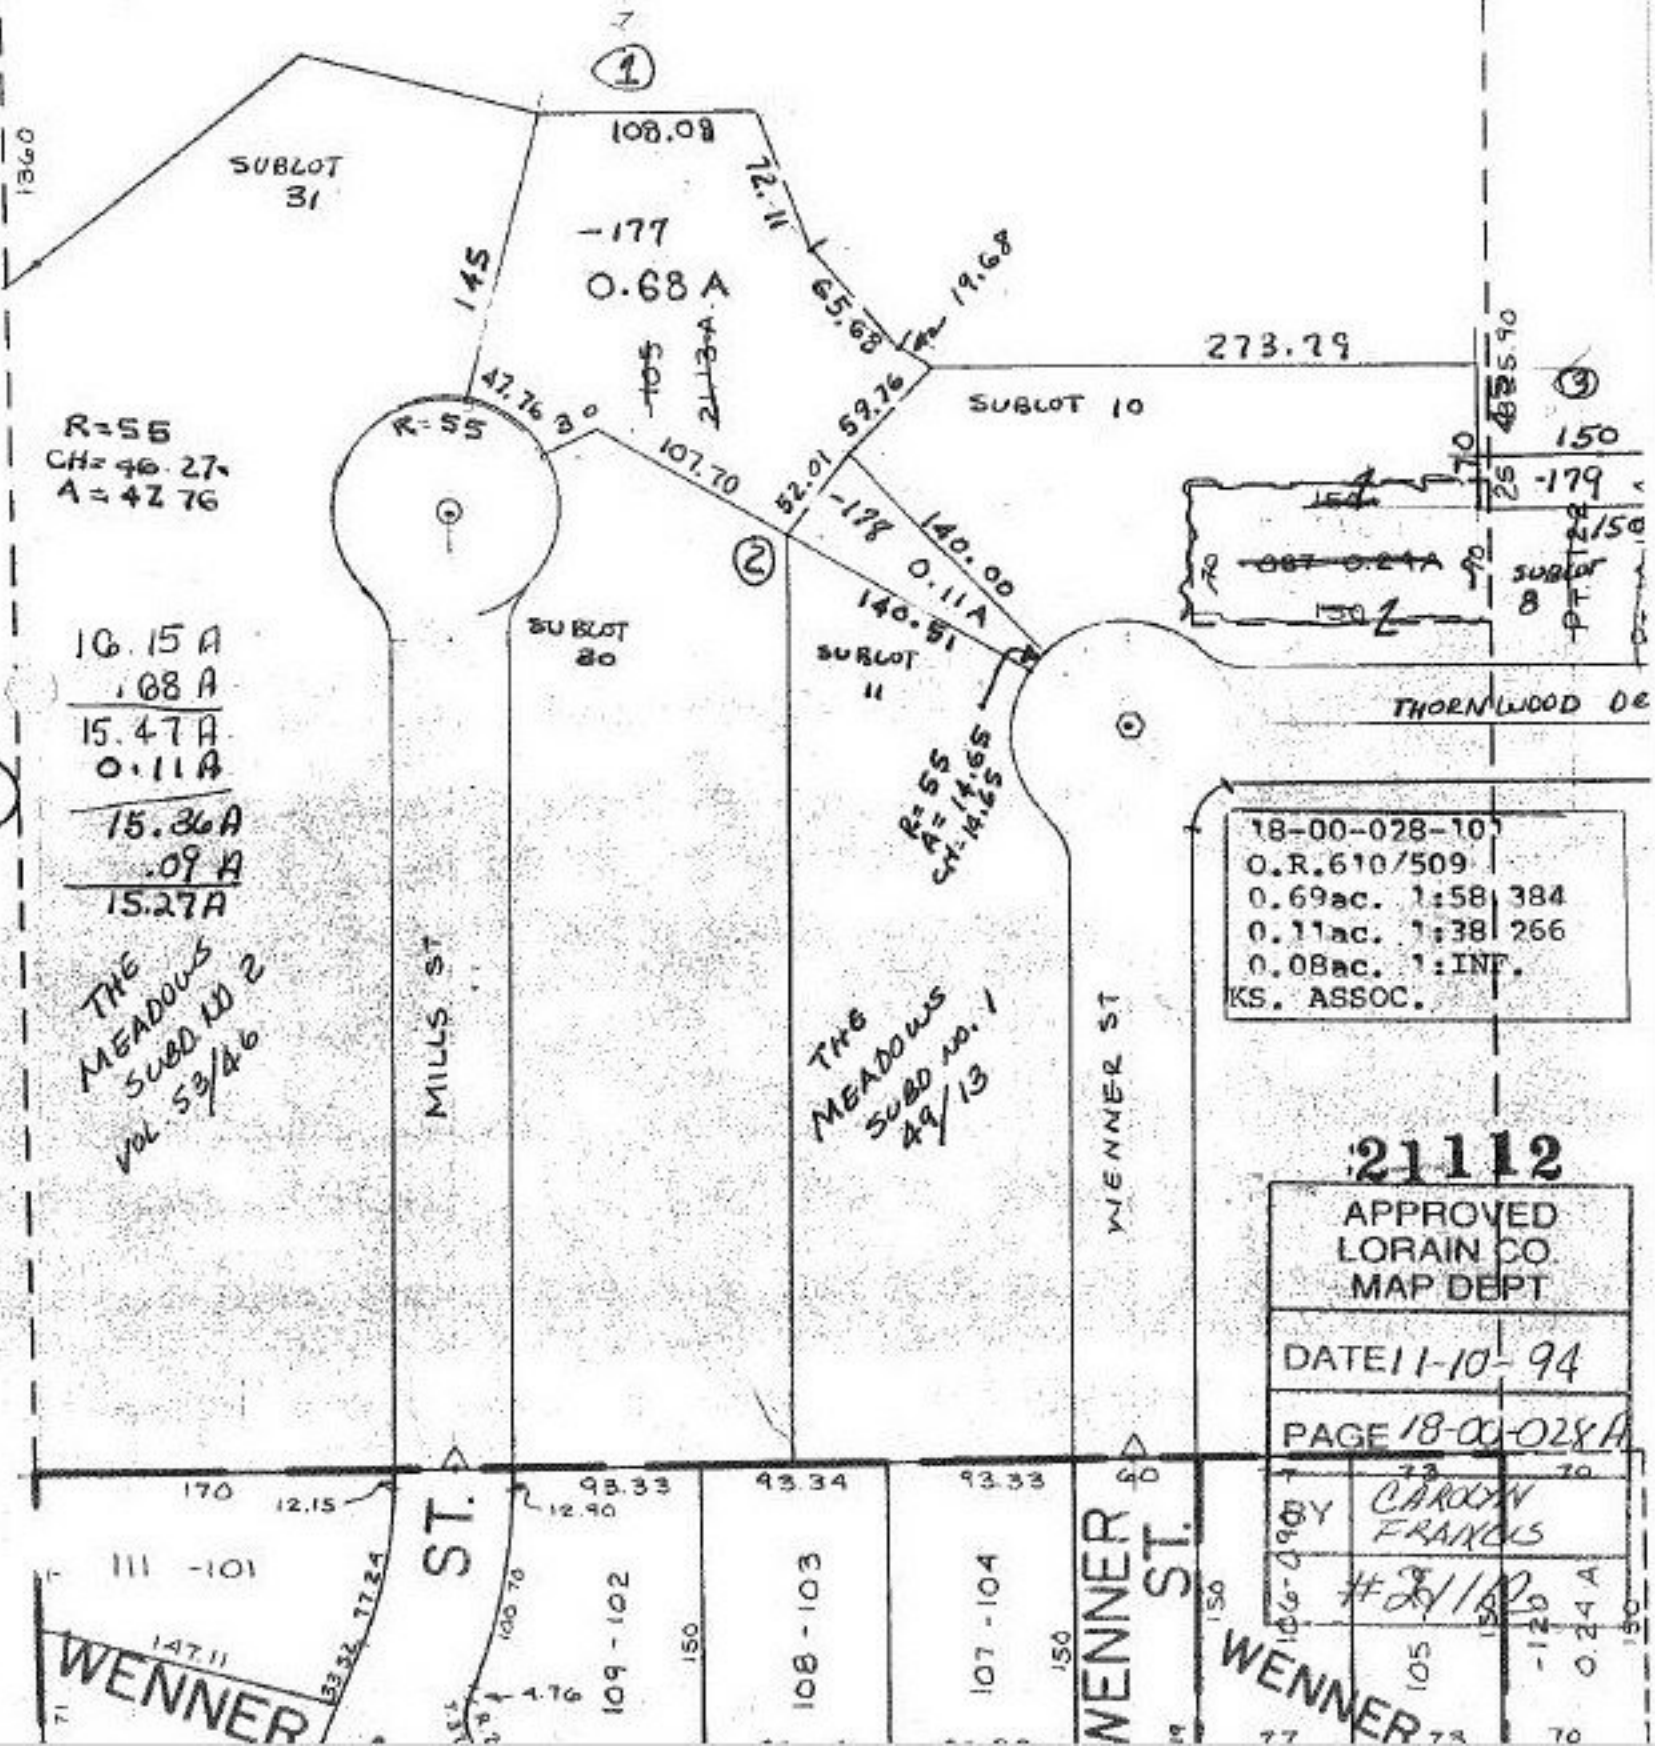

R=55  
CH=46.27  
A=42.76

10.15 A  
 .08 A  
 15.47 A  
 0.11 A  
 15.36 A  
 .09 A  
 15.27 A

THE MEADOWS  
SUBD NO 2  
VOL. 53/46

MILLS ST

THE MEADOWS  
SUBD NO. 1  
49/13

WENNER ST

18-00-028-10  
 O.R. 610/509  
 0.69ac. 1:58 384  
 0.11ac. 1:38 266  
 0.08ac. 1:INT  
 KS. ASSOC.

21112

APPROVED  
LORAIN CO.  
MAP DEPT

DATE 11-10-94

PAGE 18-00-028A

CAROLYN  
FRANCIS  
#2/100

WENNER ST

170 12.15  
 111 -101  
 147.11  
 WENNER ST  
 109 -102  
 108 -103  
 107 -104  
 WENNER ST