


#21123-X

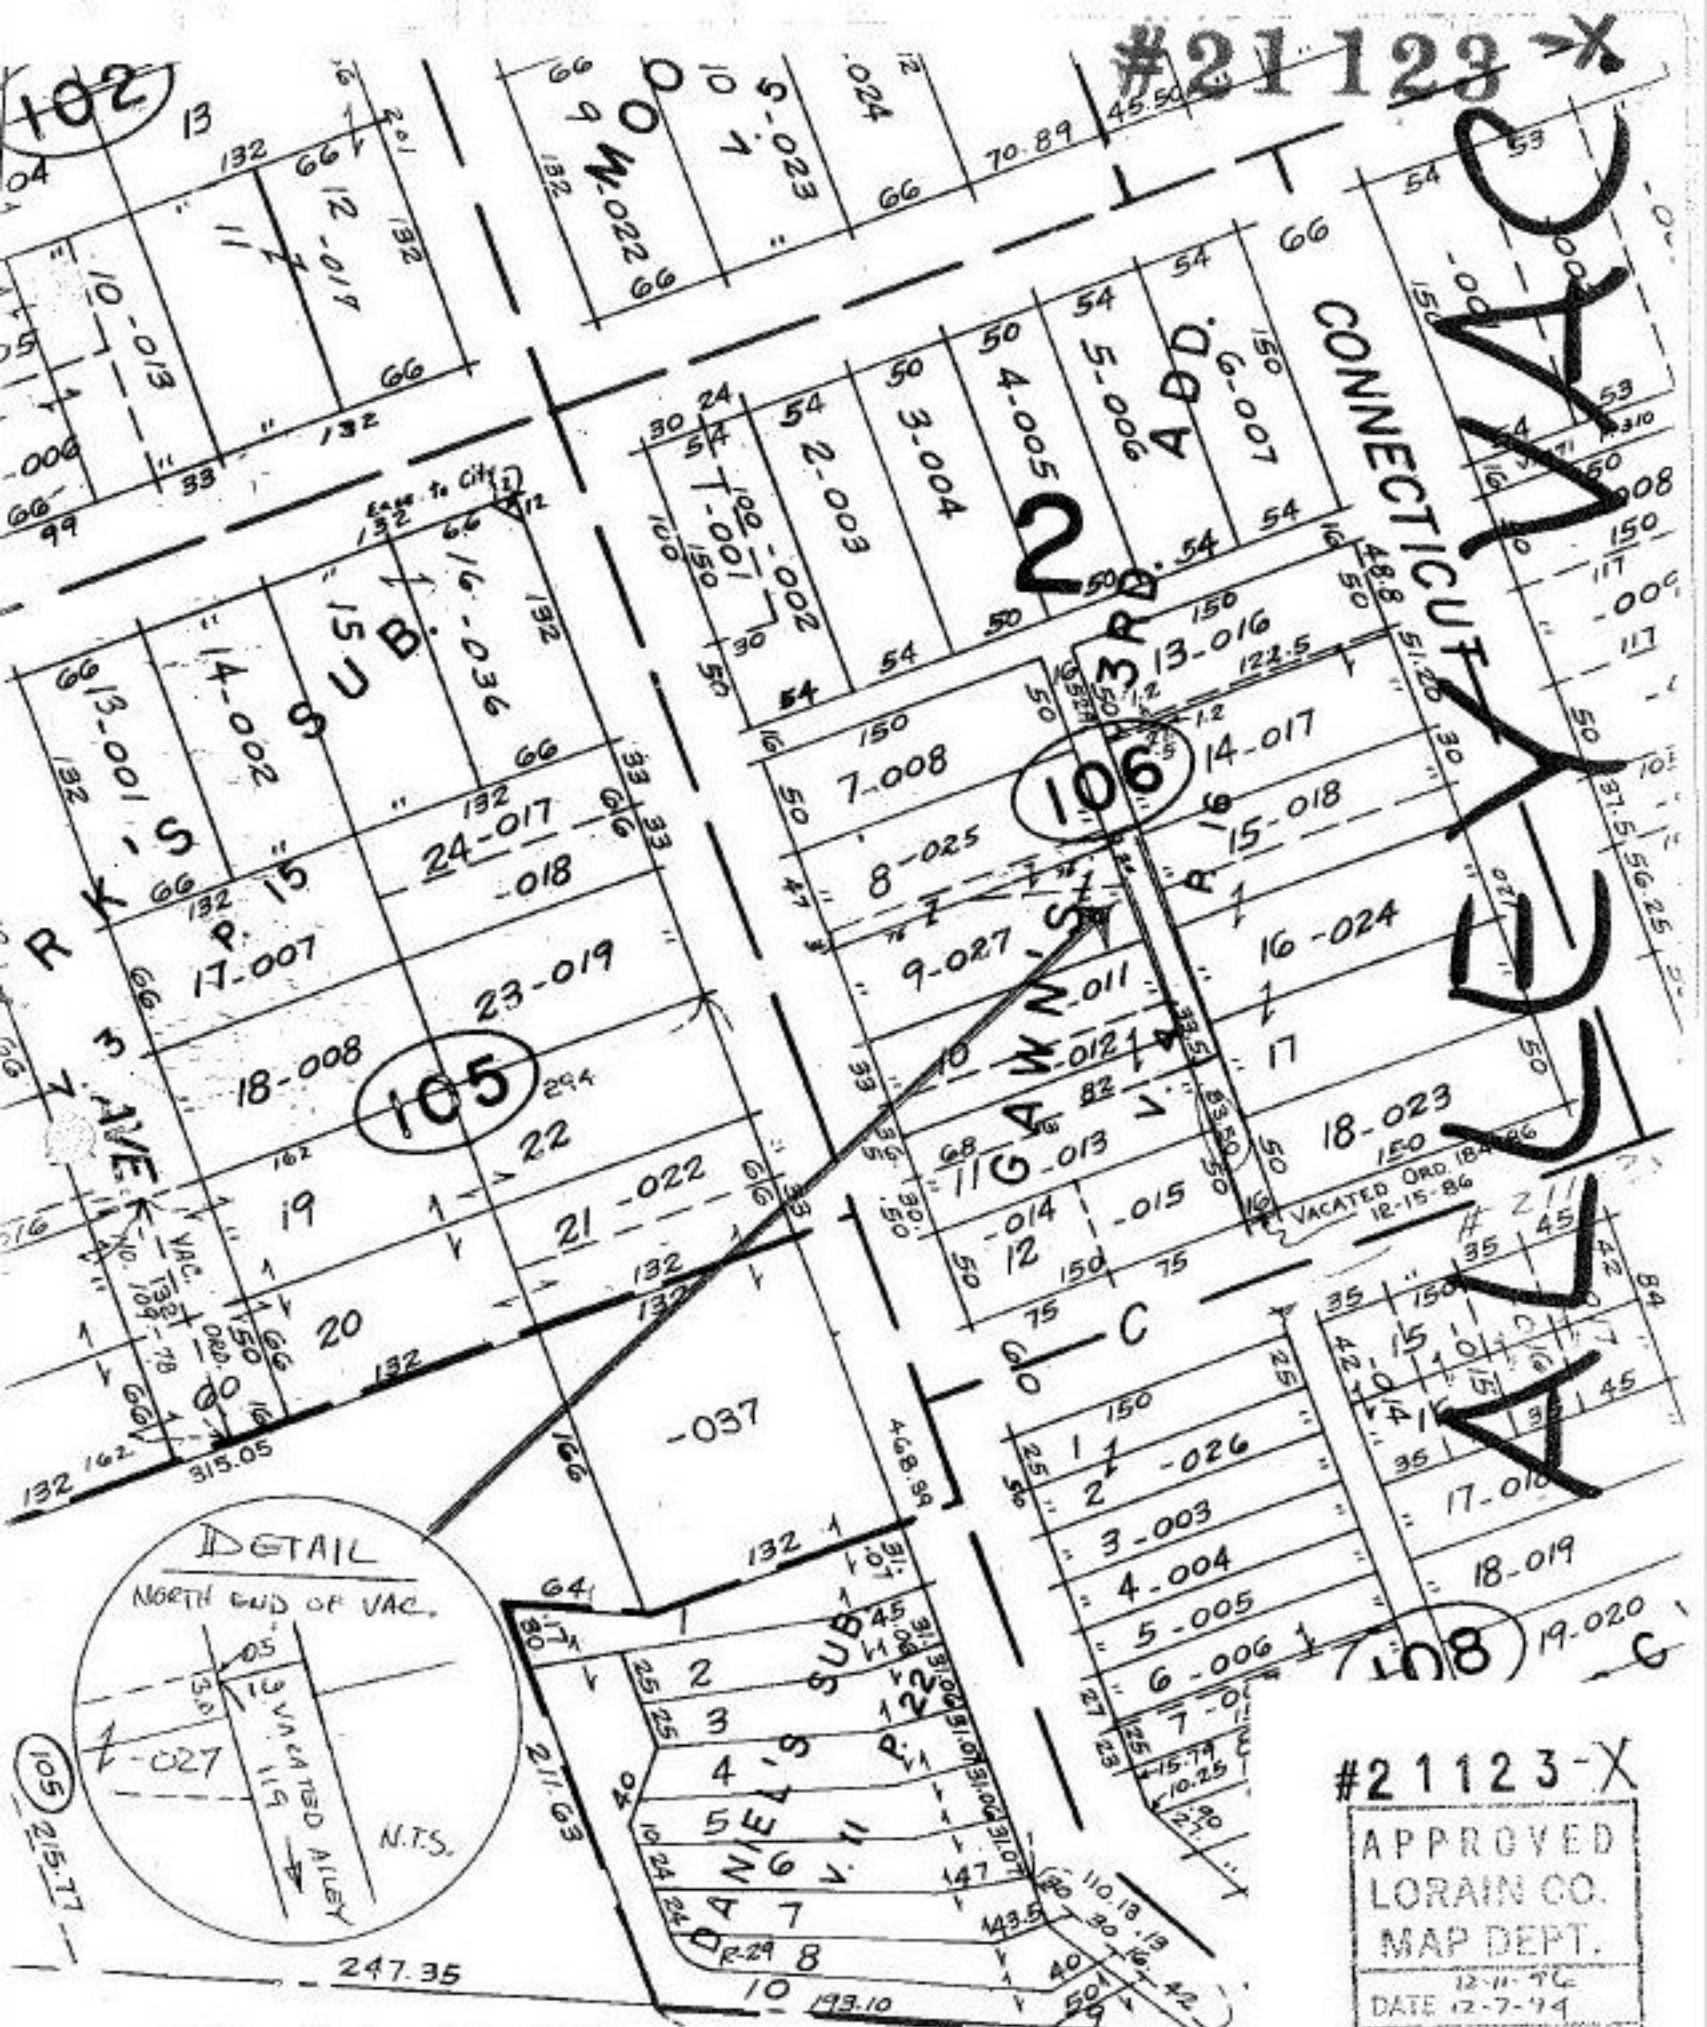

CONNECTICUT AVE

ADD.

2

106

105

108

#21123-X

APPROVED  
 LORAIN CO.  
 MAP DEPT.  
 DATE 12-11-96  
 12-7-94  
 PAGE 2 OF 003 A  
 BY J.M. Main  
 21123-X

ORD. NO. 127-94  
 PASSED 11-1-94  
 PARTIAL ALLEY VACATION