


JEE

21124

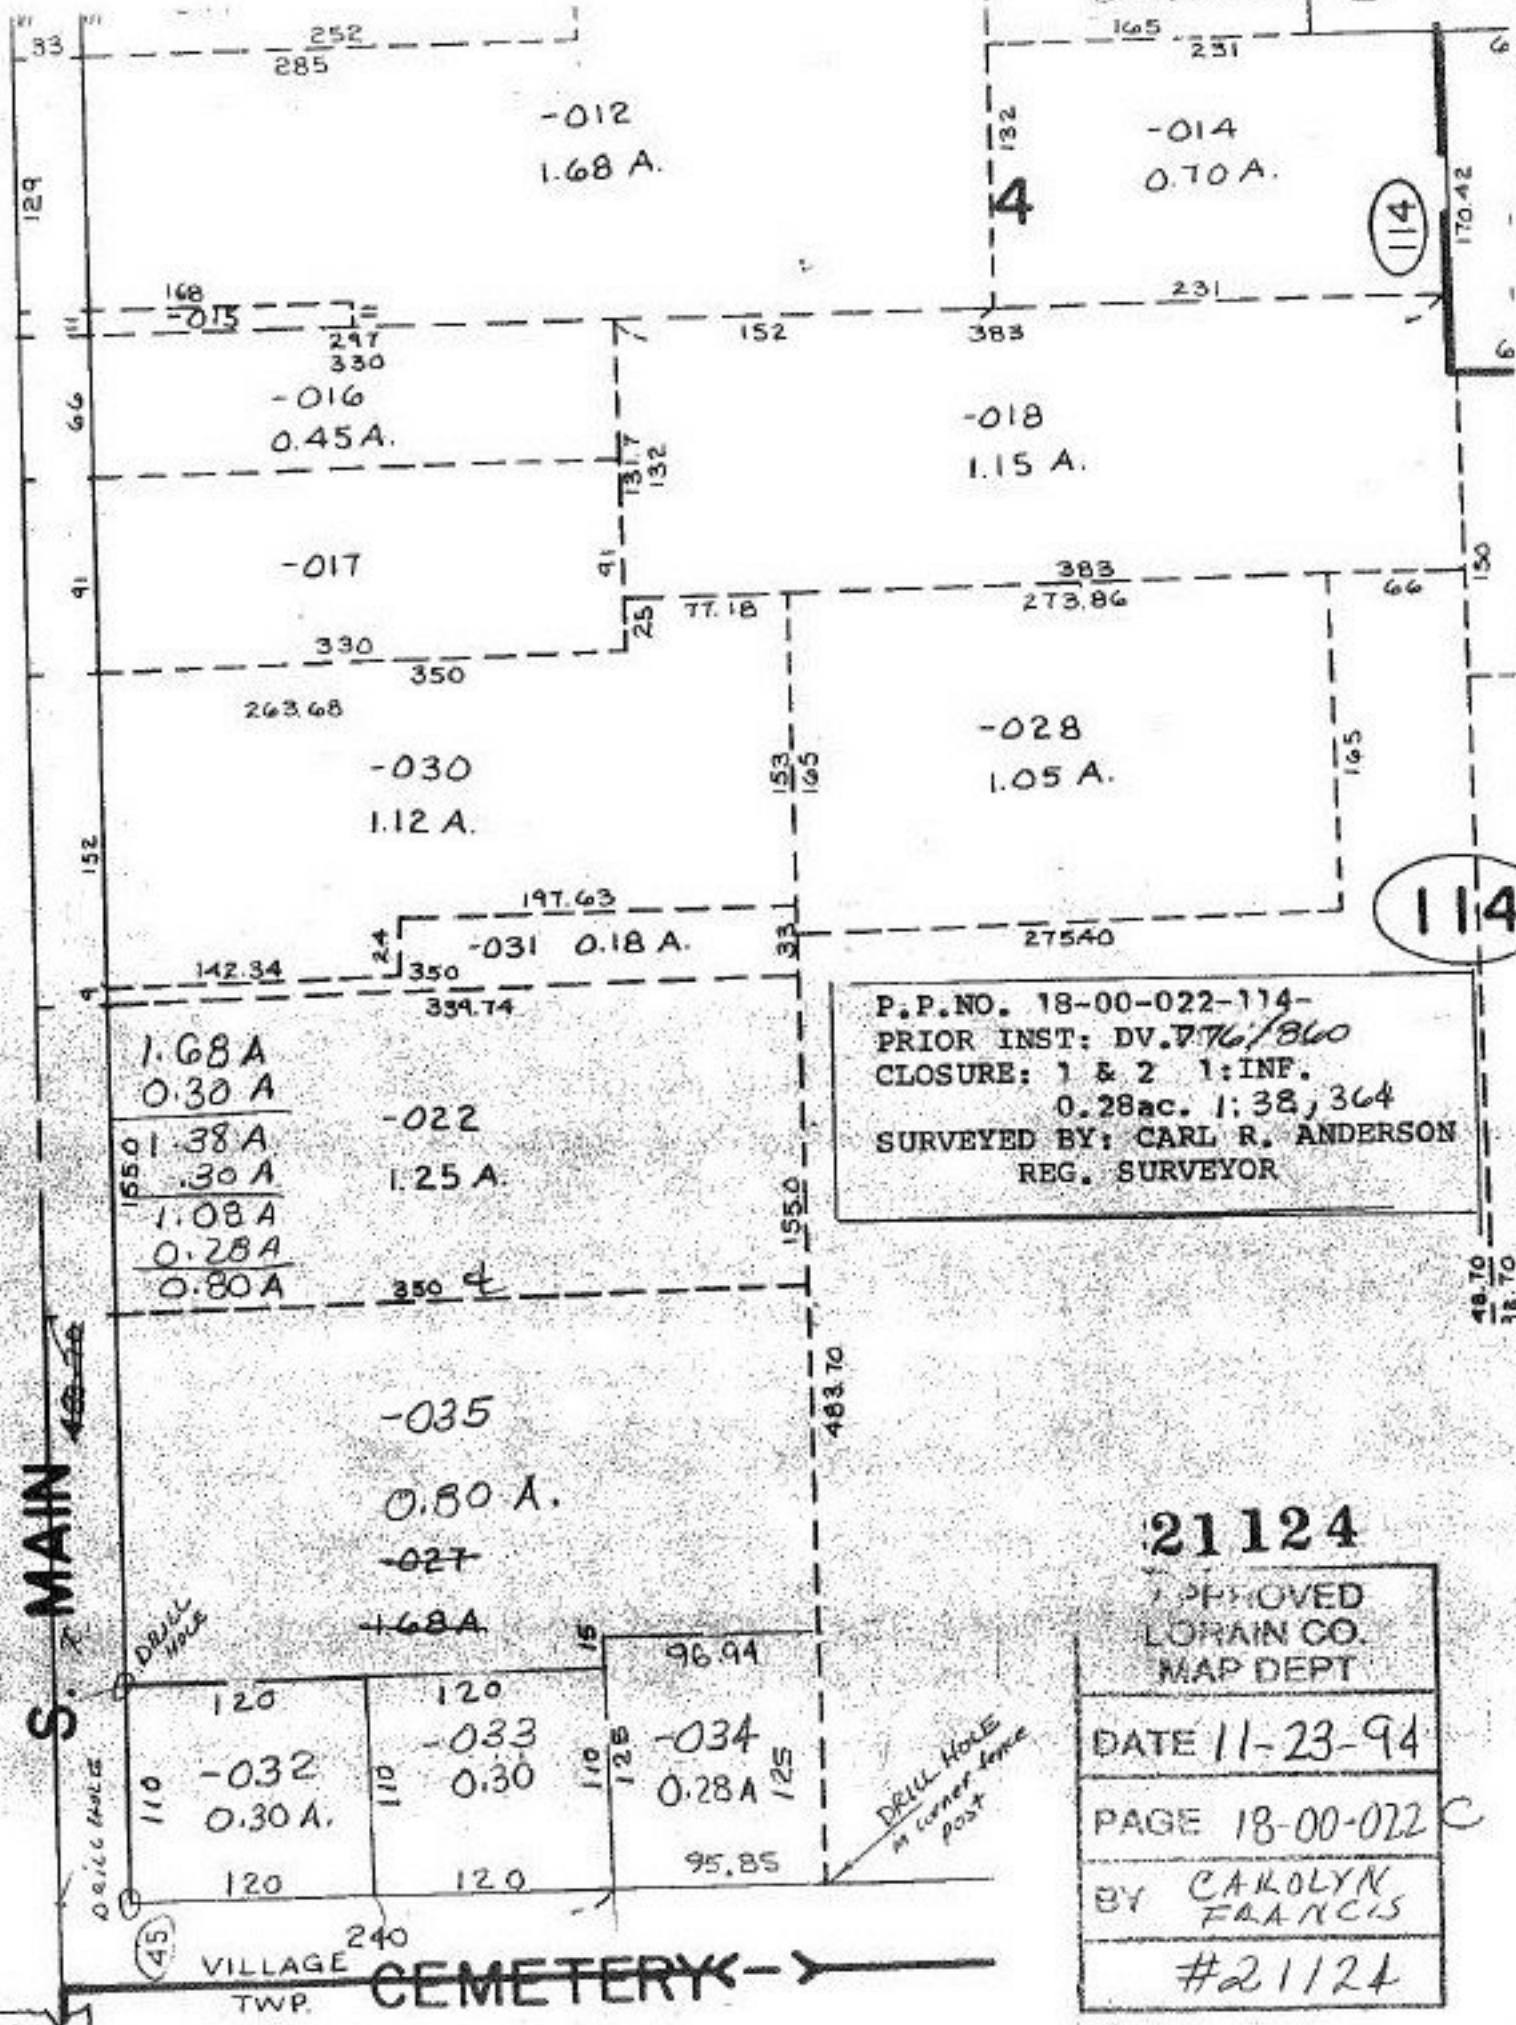

P.P. NO. 18-00-022-114-  
 PRIOR INST: DV. 776/860  
 CLOSURE: 1 & 2 1:INF.  
 0.28ac. 1: 38, 364  
 SURVEYED BY: CARL R. ANDERSON  
 REG. SURVEYOR

21124

APPROVED  
 LORAIN CO.  
 MAP DEPT

DATE 11-23-94

PAGE 18-00-022 C

BY CAROLYN FRANCIS

#21124

58