


2113

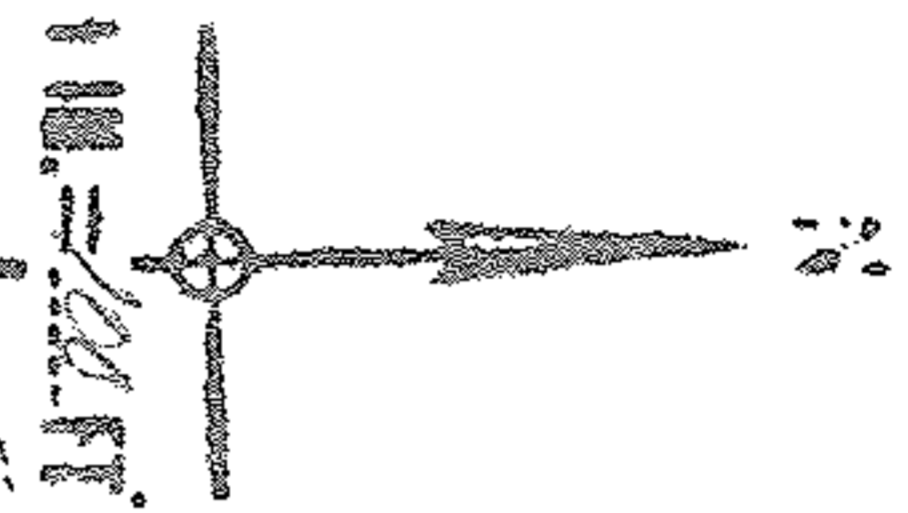

7-14-868m8

APPROVED
LORAIN CO.
MAP DEPT.
DATE 9-30-68
BY <i>J. J. [Signature]</i>


Done 11-3-68

PT. 039
PT. 50-00-A

046
1400 A

041
4.57 A

040
5.43 A

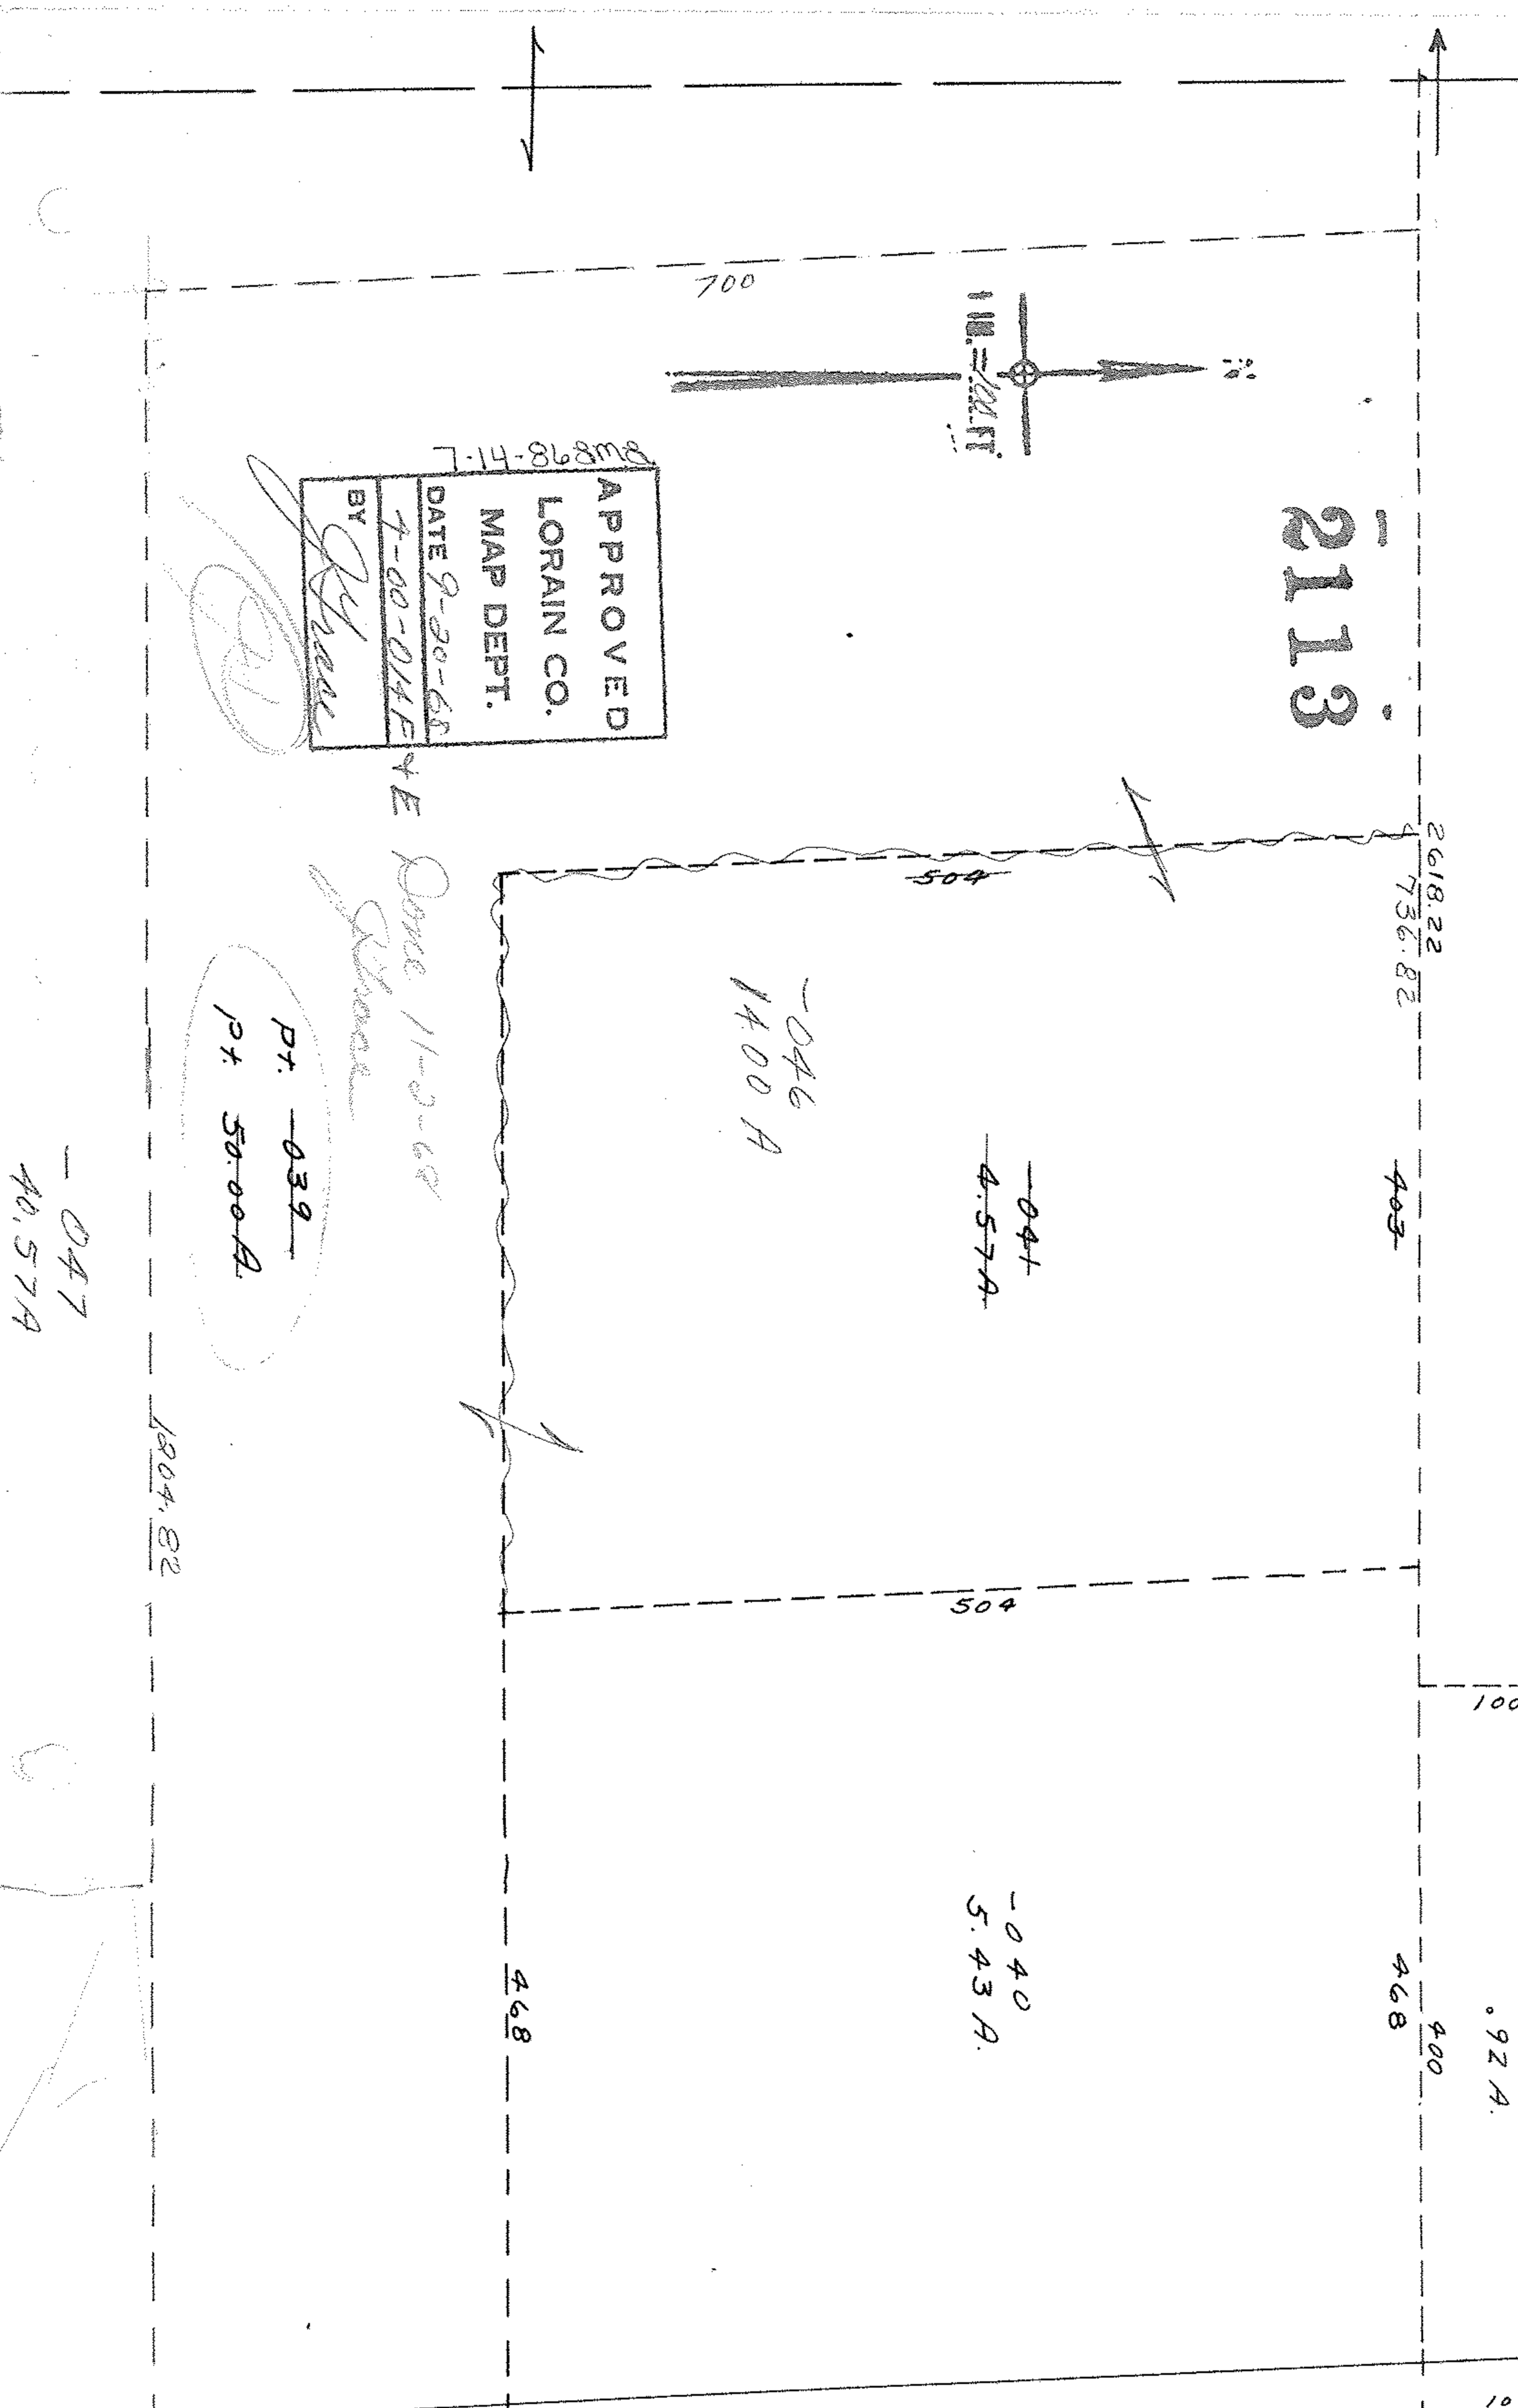

AVON LAKE

STER