


Pt. -030  
Pt. 23.54 A.


SPLIT OUT OF

050 5.71 A  
073 16.20 A  
21.91 A  
SPLIT 9.59 A  
RSM: 12.32 A

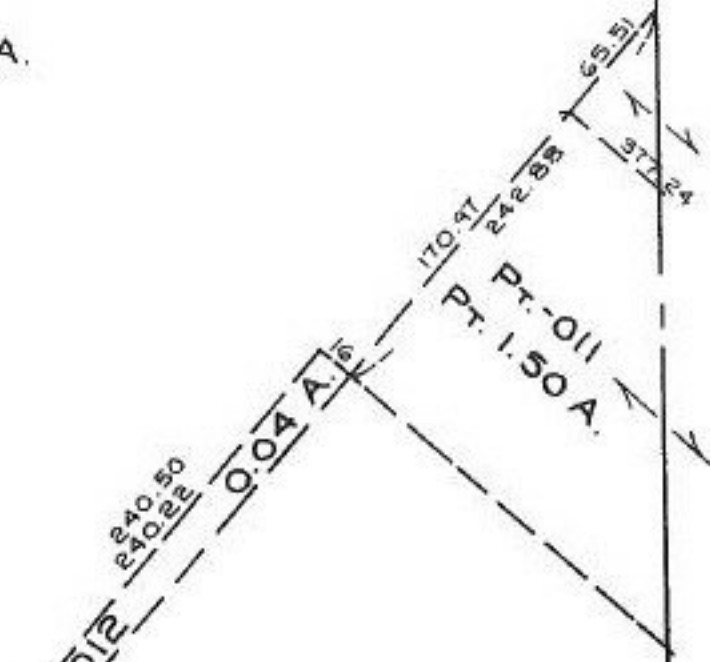

Pt. 5-12-95  
Pt. -010 21132

APPROVED LOHAIN CO. MAP DEPT
DATE 11-28-94
PAGE 7-00/014 B
BY CAROLYN FRANCIS
10 21132

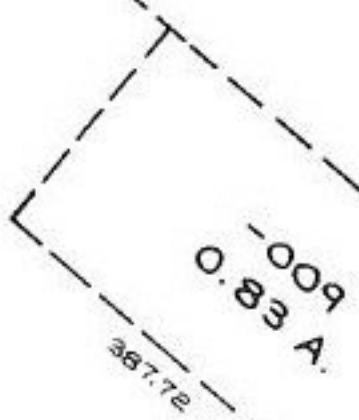

07-00-011-003  
07-00-014-  
PRIOR INST: DV. 1313/338

Pt. 07-00-011-103-059  
Pt. 5-71A  
9.59A  
-089

