


#21135-A

APPROVED
LORAIN CO.
MAP DEPT.
DATE 12-1-94
PAGE 500-982
BY T. M. Main
NO. 21135-A

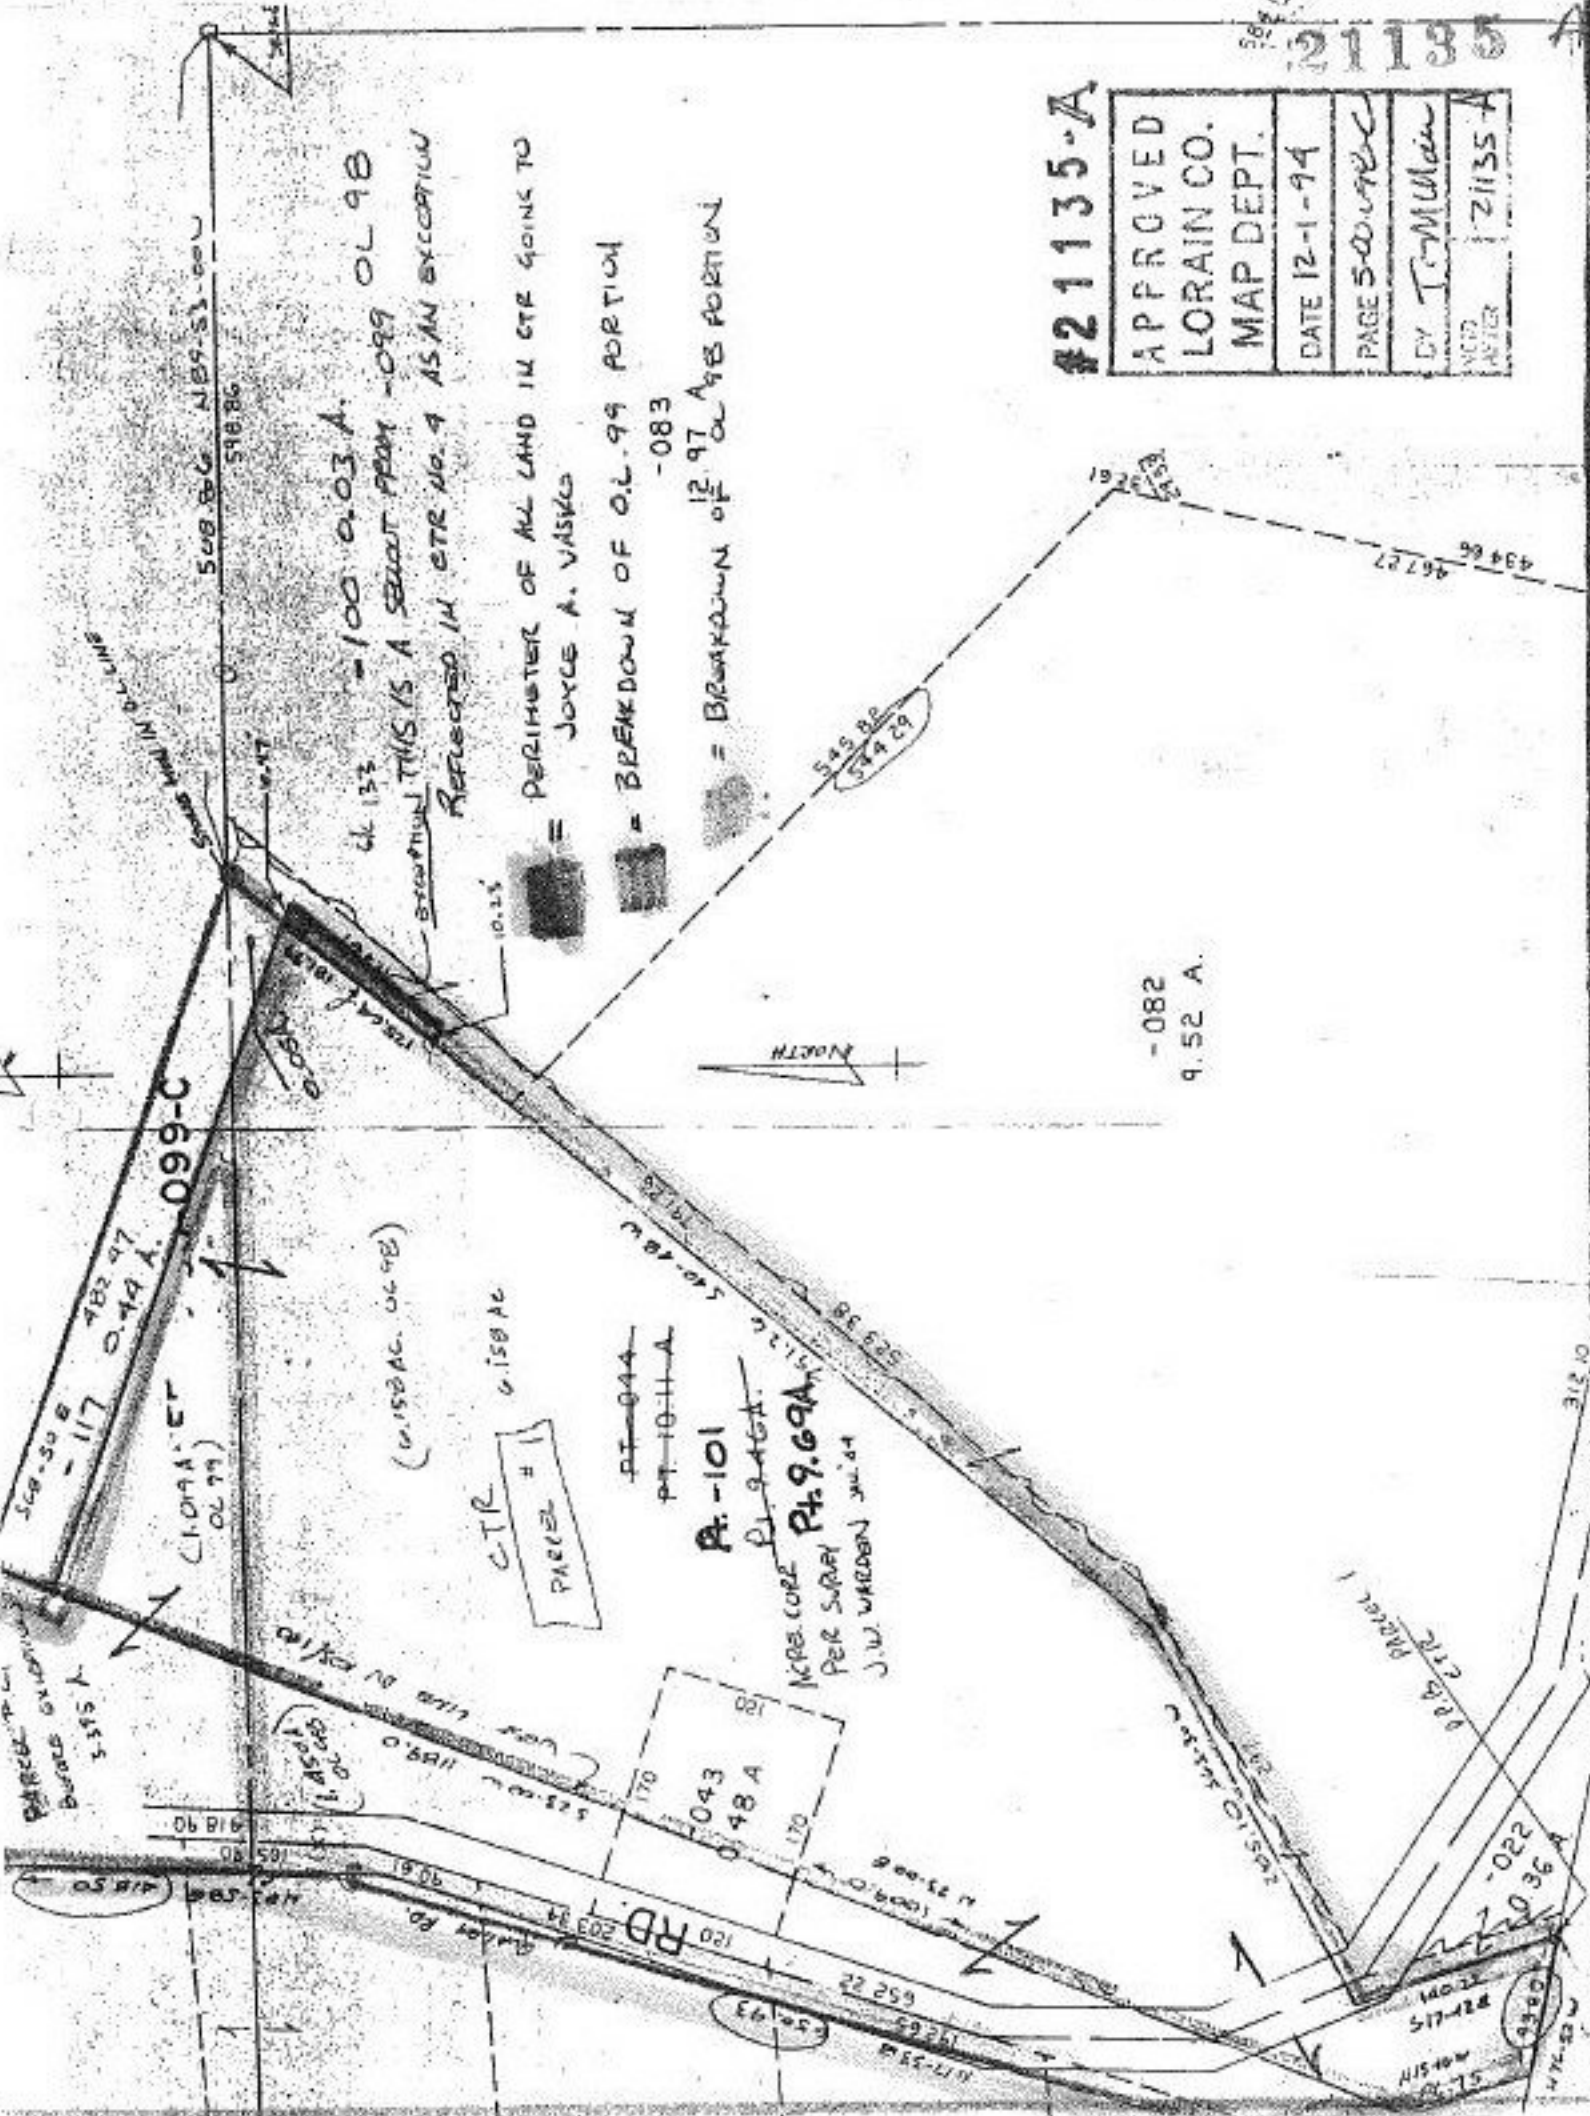

-082  
9.52 A.