


21142

W along Gifford

33

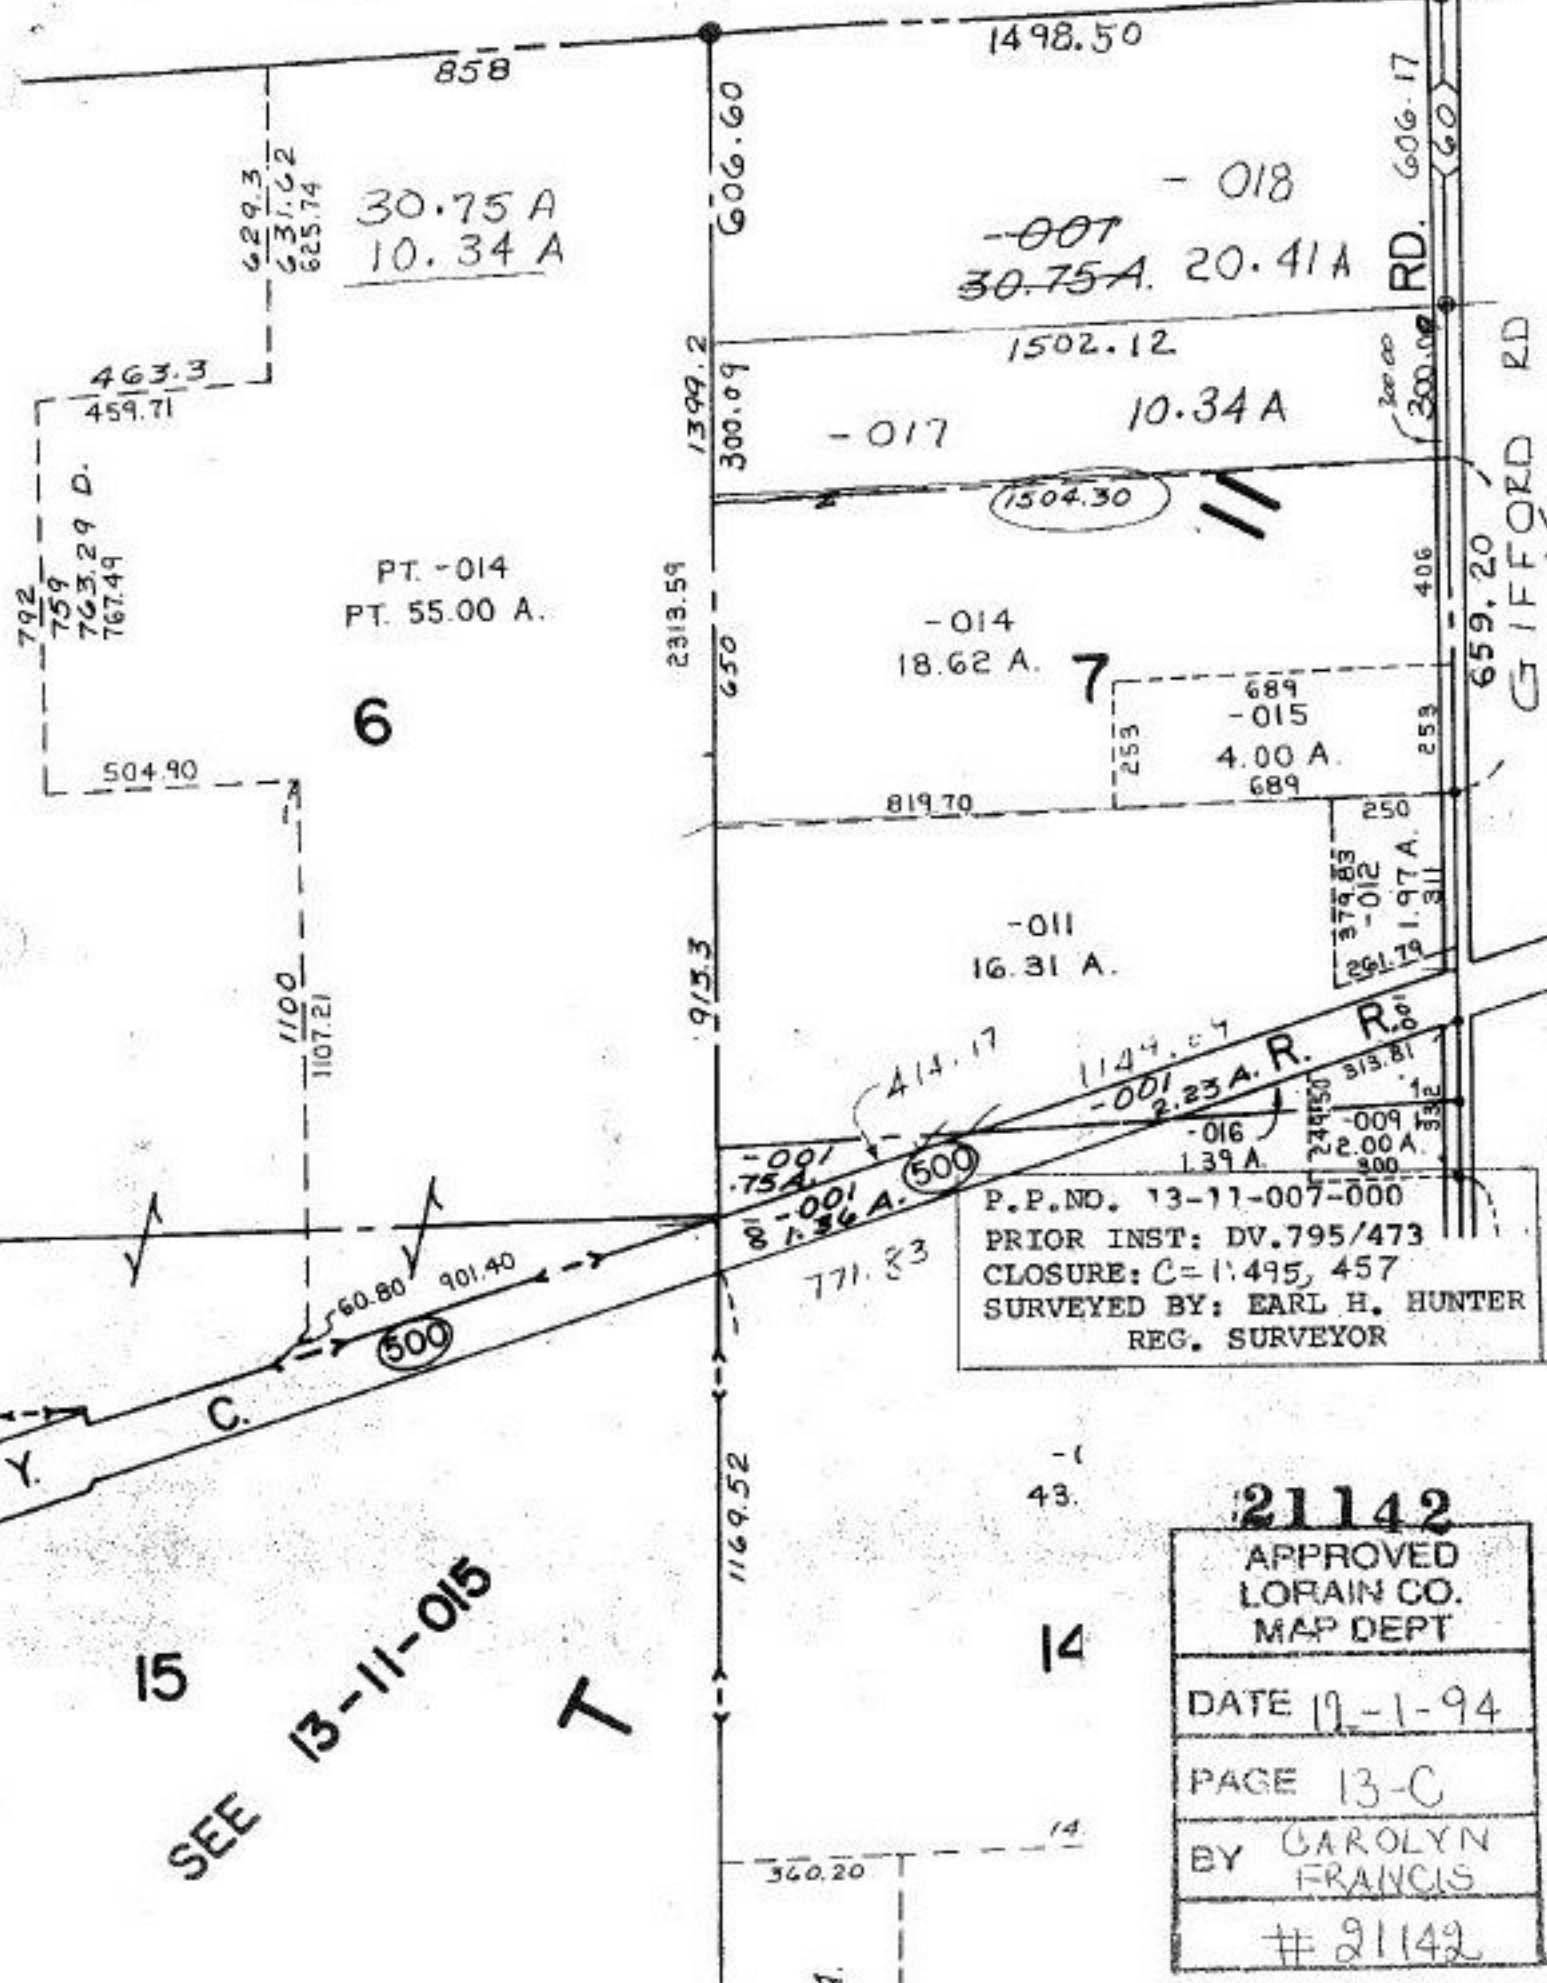

30.75 A  
10.34 A

- 018  
- 007  
30.75 A. 20.41 A

- 017  
10.34 A

- 014  
18.62 A

- 011  
16.31 A

689  
- 015  
4.00 A  
689

379.85  
- 012  
1.97 A  
261.79

- 001  
2.23 A.R. R.  
- 016  
1.39 A  
- 009  
2.00 A  
300

P.P. NO. 13-11-007-000  
PRIOR INST: DV. 795/473  
CLOSURE: C=1.495, 457  
SURVEYED BY: EARL H. HUNTER  
REG. SURVEYOR

PT. - 014  
PT. 55.00 A.

6

7

15

SEE 13-11-015

T

43.

14

14

21142

APPROVED  
LORAIN CO.  
MAP DEPT

DATE 12-1-94

PAGE 13-C

BY CAROLYN  
FRANCIS

# 21142

3365.54' FRODOY, South line of O.L. 14 T. 11'