


DRILL HOLE

MAPLE

MAPLE STREET DEDICATION PLAT

Pt. 900 -001 Pt. 4.09 A

501.89

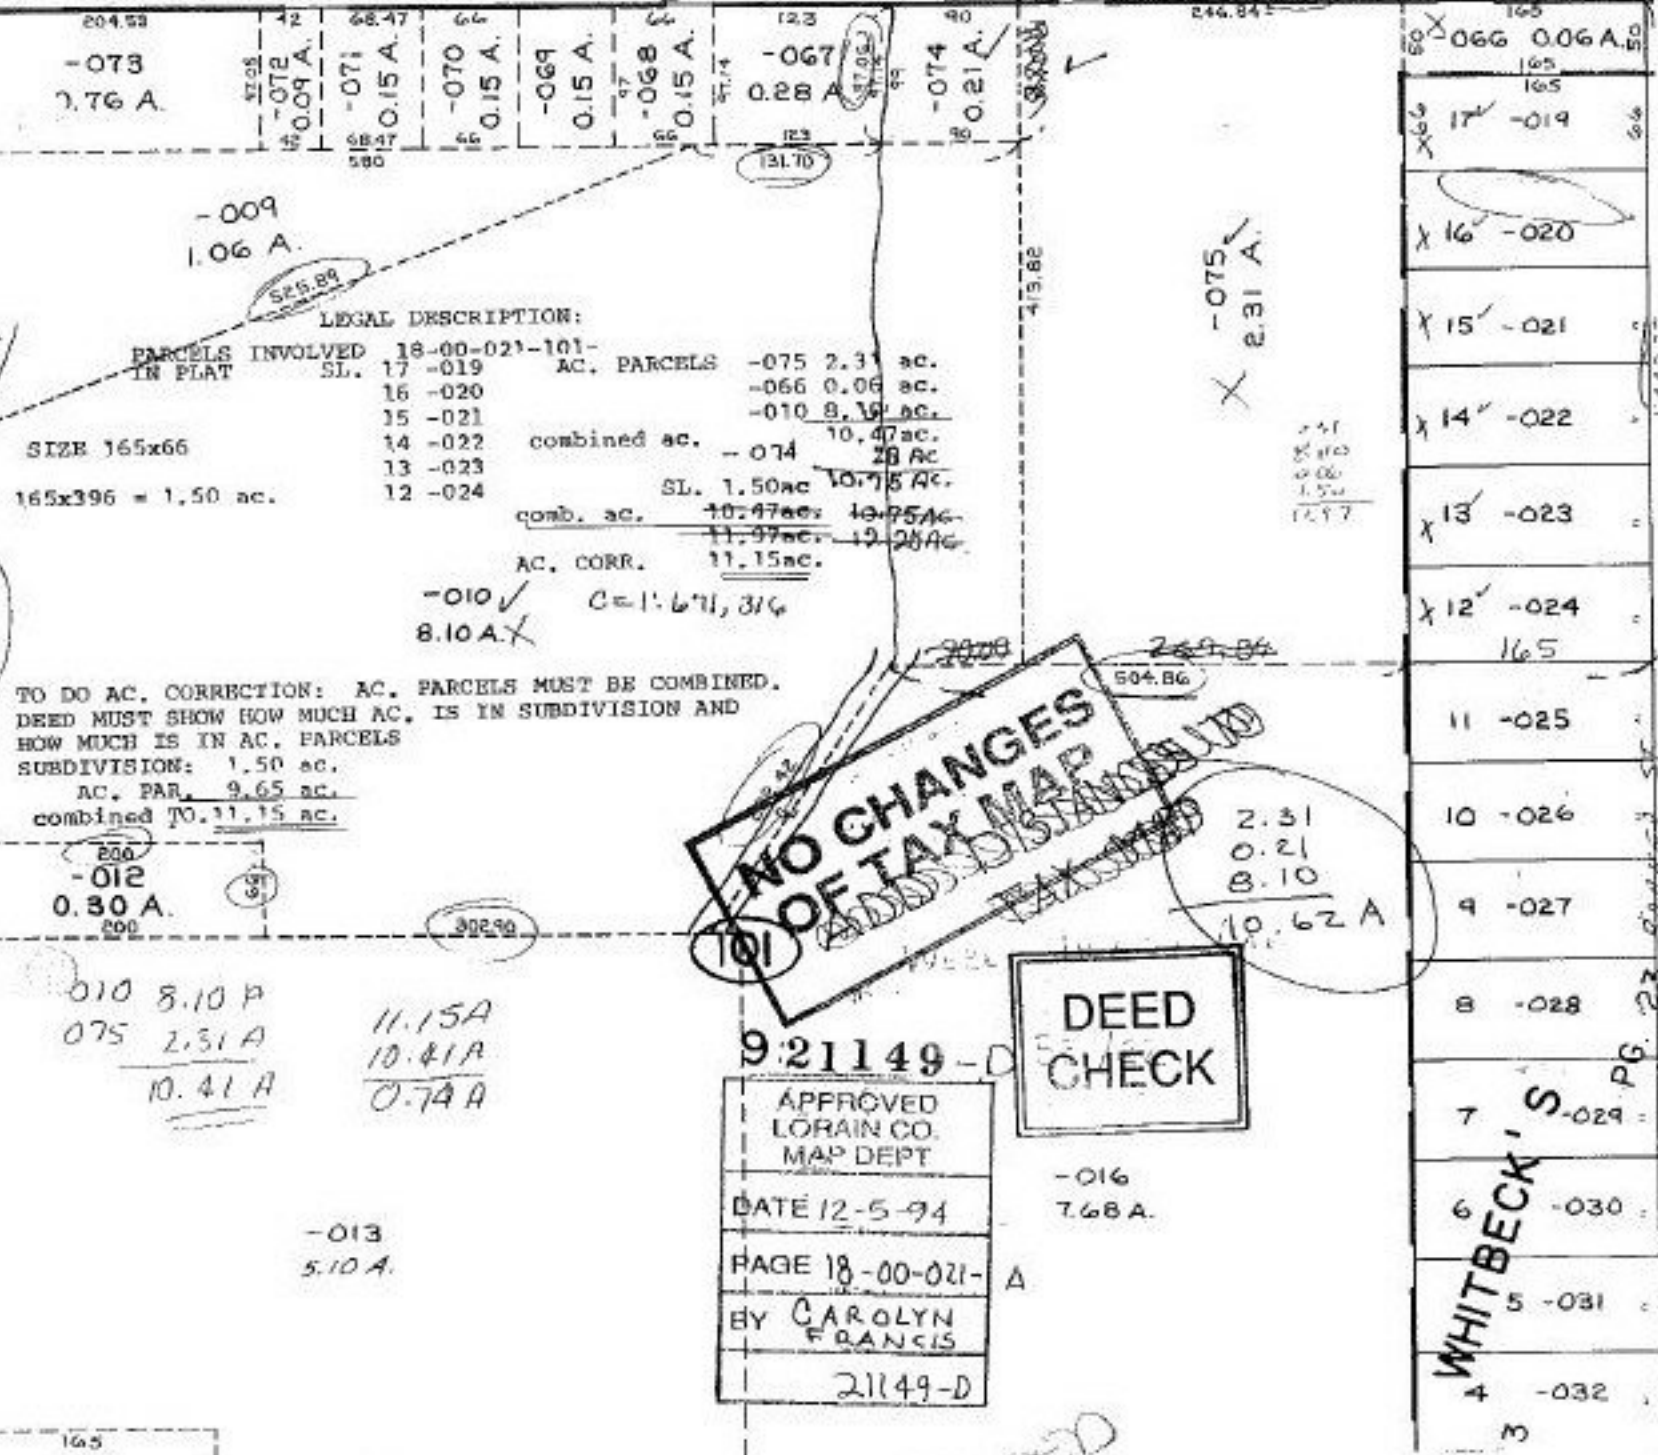

-009
1.06 A.

LEGAL DESCRIPTION:

PARCELS INVOLVED IN PLAT	18-00-021-101-	AC. PARCELS	-075 2.31 ac.
	SL. 17 -019		-066 0.06 ac.
	16 -020		-010 8.10 ac.
	15 -021		
	14 -022	combined ac.	-074 10.47 ac.
	13 -023		28 ac.
	12 -024	SL. 1.50 ac	10.75 ac.
		comb. ac.	10.47 ac. + 1.50 ac. = 11.97 ac.
		AC. CORR.	11.15 ac.

-010 ✓ C=1.671, 316
8.10 A X

TO DO AC. CORRECTION: AC. PARCELS MUST BE COMBINED.
DEED MUST SHOW HOW MUCH AC. IS IN SUBDIVISION AND
HOW MUCH IS IN AC. PARCELS
SUBDIVISION: 1.50 ac.
AC. PAR. 9.65 ac.
combined TO 11.15 ac.

NO CHANGES OF TAX MAP
ADDITIONAL TAXES

DEED CHECK

9:21149-D
APPROVED
LORAIN CO.
MAP DEPT
DATE 12-5-94
PAGE 18-00-021-A
BY CAROLYN FRANCIS
21149-D

- 30 X 066 0.06 A. 0
- 29 X 17 -019 6.5
- 28 X 16 -020
- 27 X 15 -021
- 26 X 14 -022
- 25 X 13 -023
- 24 X 12 -024 16.5
- 23 11 -025
- 22 10 -026
- 21 9 -027
- 20 8 -028
- 19 7 -029
- 18 6 -030
- 17 5 -031
- 16 4 -032
- 15 3

WHITBECK'S

REDUCED

010 8.10 A
075 2.31 A
10.41 A

11.15 A
10.41 A
0.74 A

-013
5.10 A.

-016
7.68 A.

2.31
0.21
8.10
10.62 A

165
114