


#21165-D

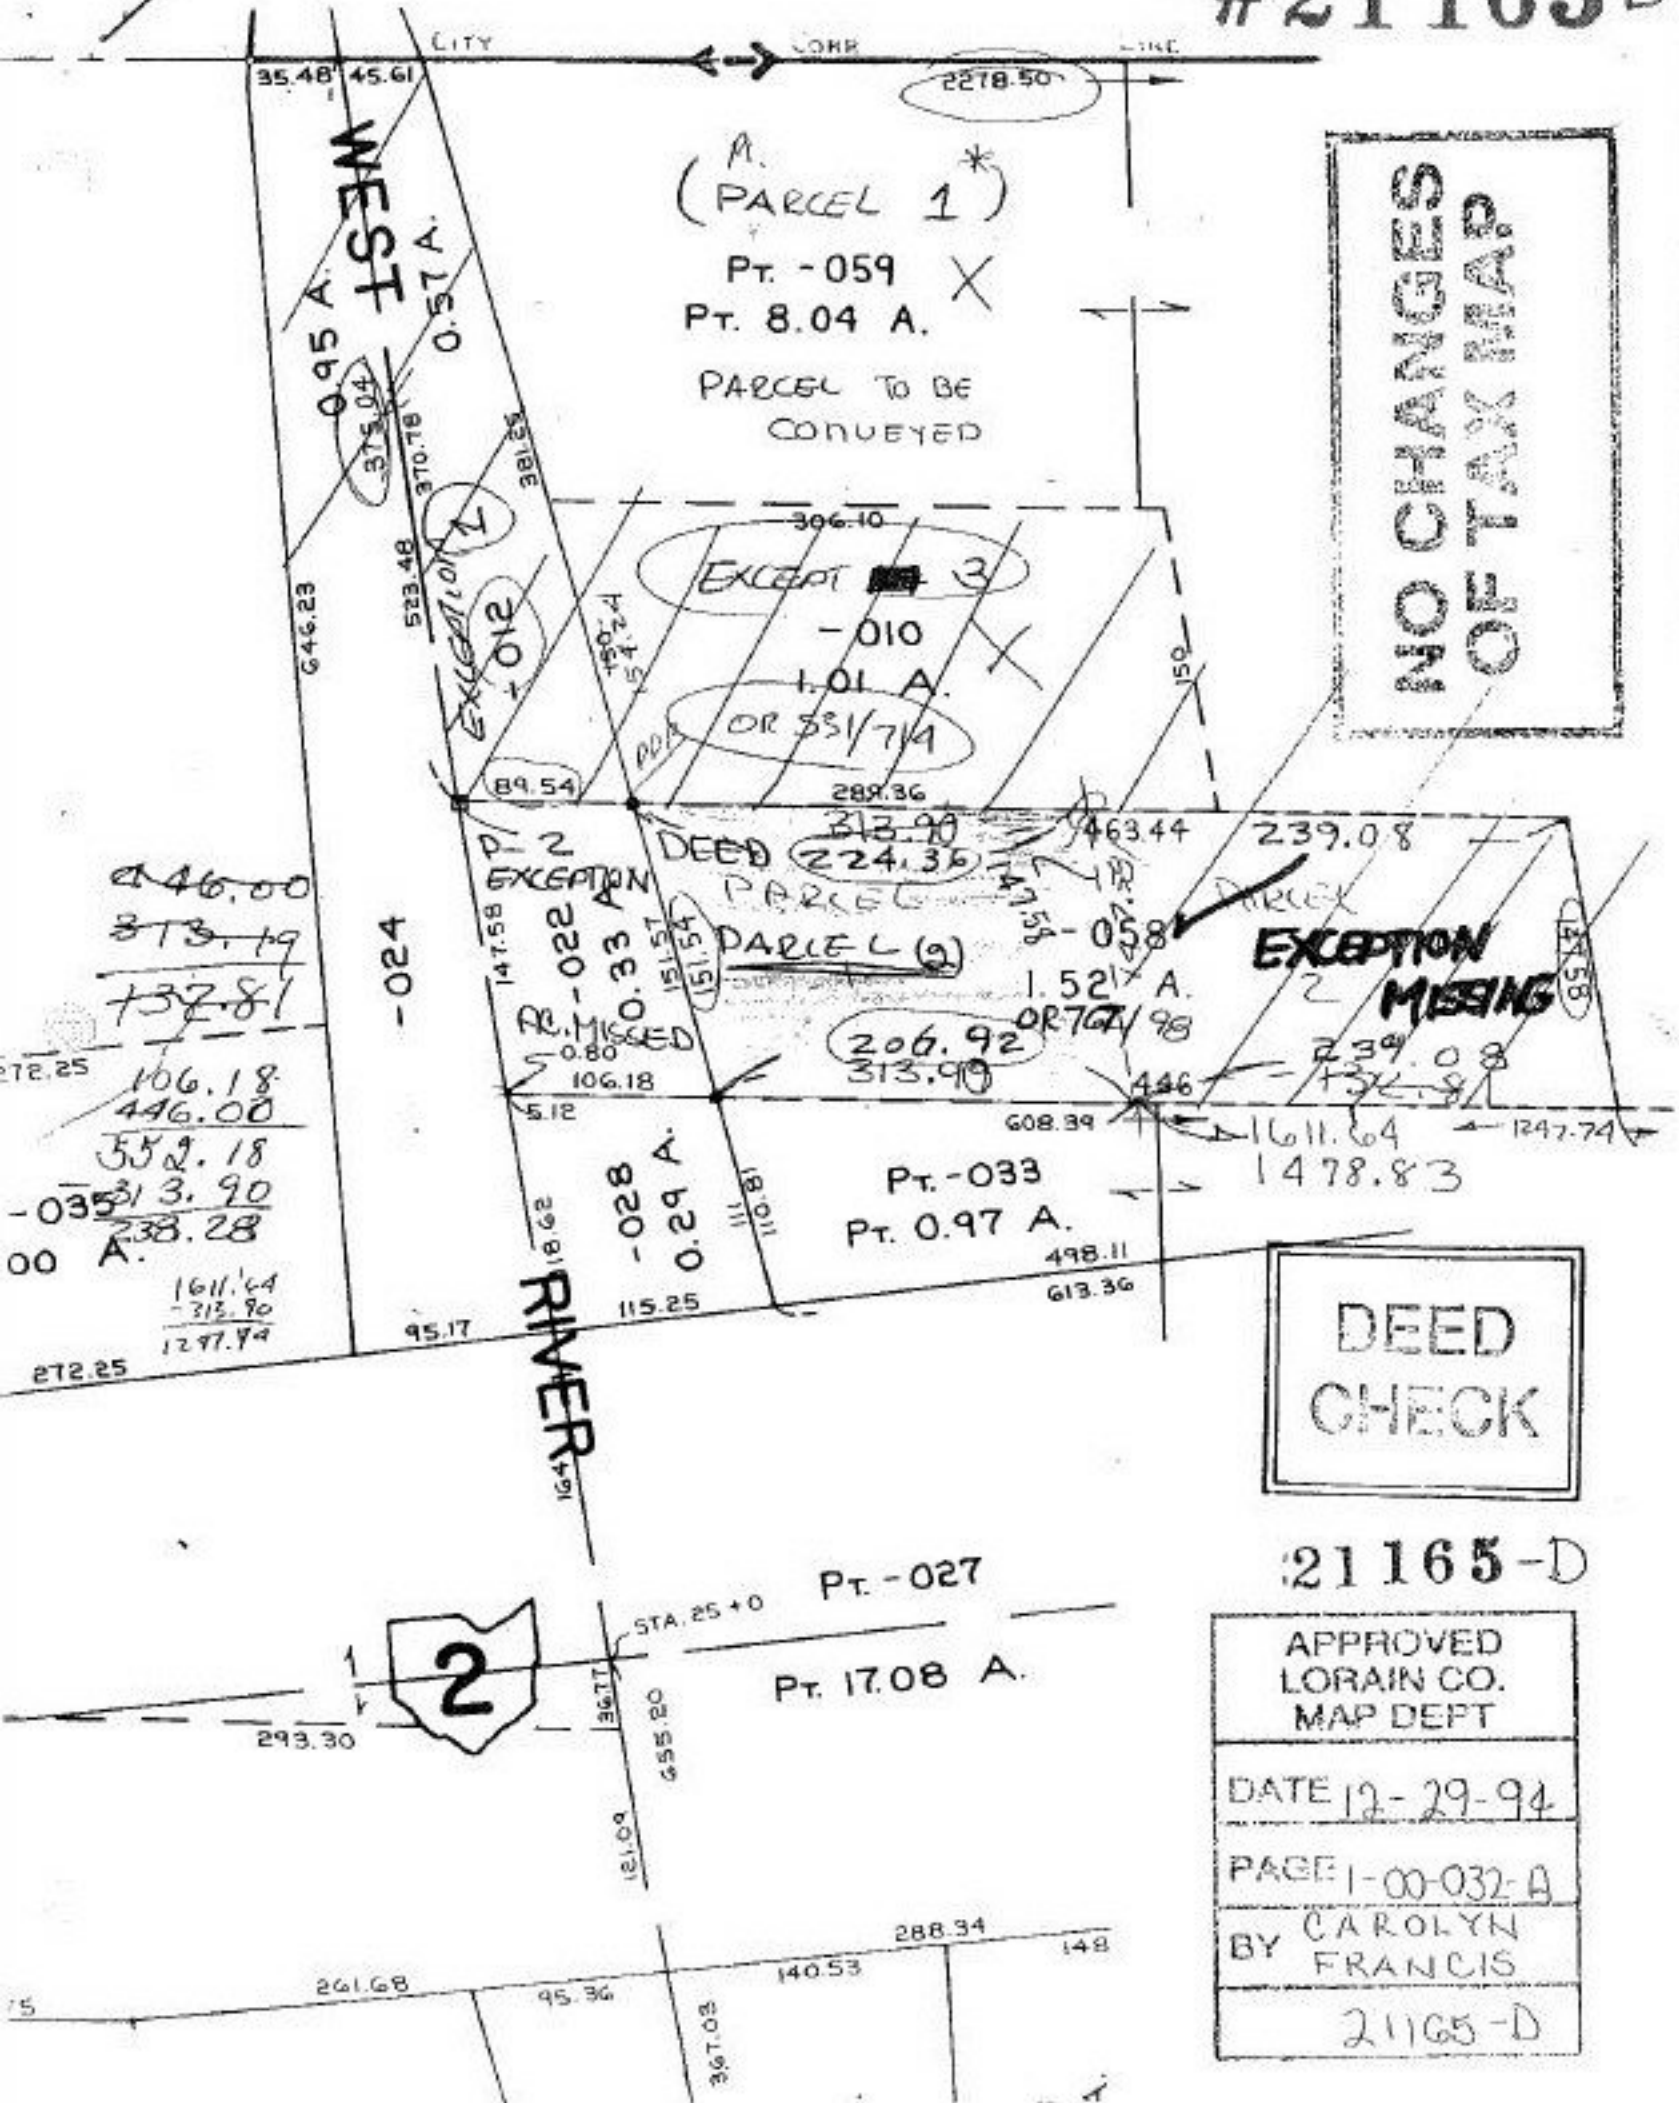

A.
 (PARCEL 1)
 Pt. -059 X
 Pt. 8.04 A.
 PARCEL TO BE
 CONVEYED

**NO CHANGES
 OF TAX MAP.**

EXCEPT 3
 -010
 1.01 A.
 OR 331/714

DEED PARCEL
 PARCEL (2)
 EXCEPTION MISSING
 1.521 A.
 OR 761/98

Pt. -033
 Pt. 0.97 A.

**DEED
 CHECK**

21165-D

APPROVED
 LORAIN CO.
 MAP DEPT

DATE 12-29-94

PAGE 1-00-032-A

BY CAROLYN
 FRANCIS

21165-D

446.00
 373.19
 +37.81

 72.25
 106.18
 446.00
 552.18
 -035
 313.90
 00 A. 238.28

 1611.64
 -313.90
 1297.74

-024

RIVER



Pt. -027

Pt. 17.08 A.

35.48 45.61

2278.50

WEST
 0.95 A.
 0.57 A.

CITY CORP. LINE

646.23

EXCEPTION 1
 +012

306.10

289.36

313.90

224.36

206.92

313.90

206.92

313.90

313.90

