


#21168-A

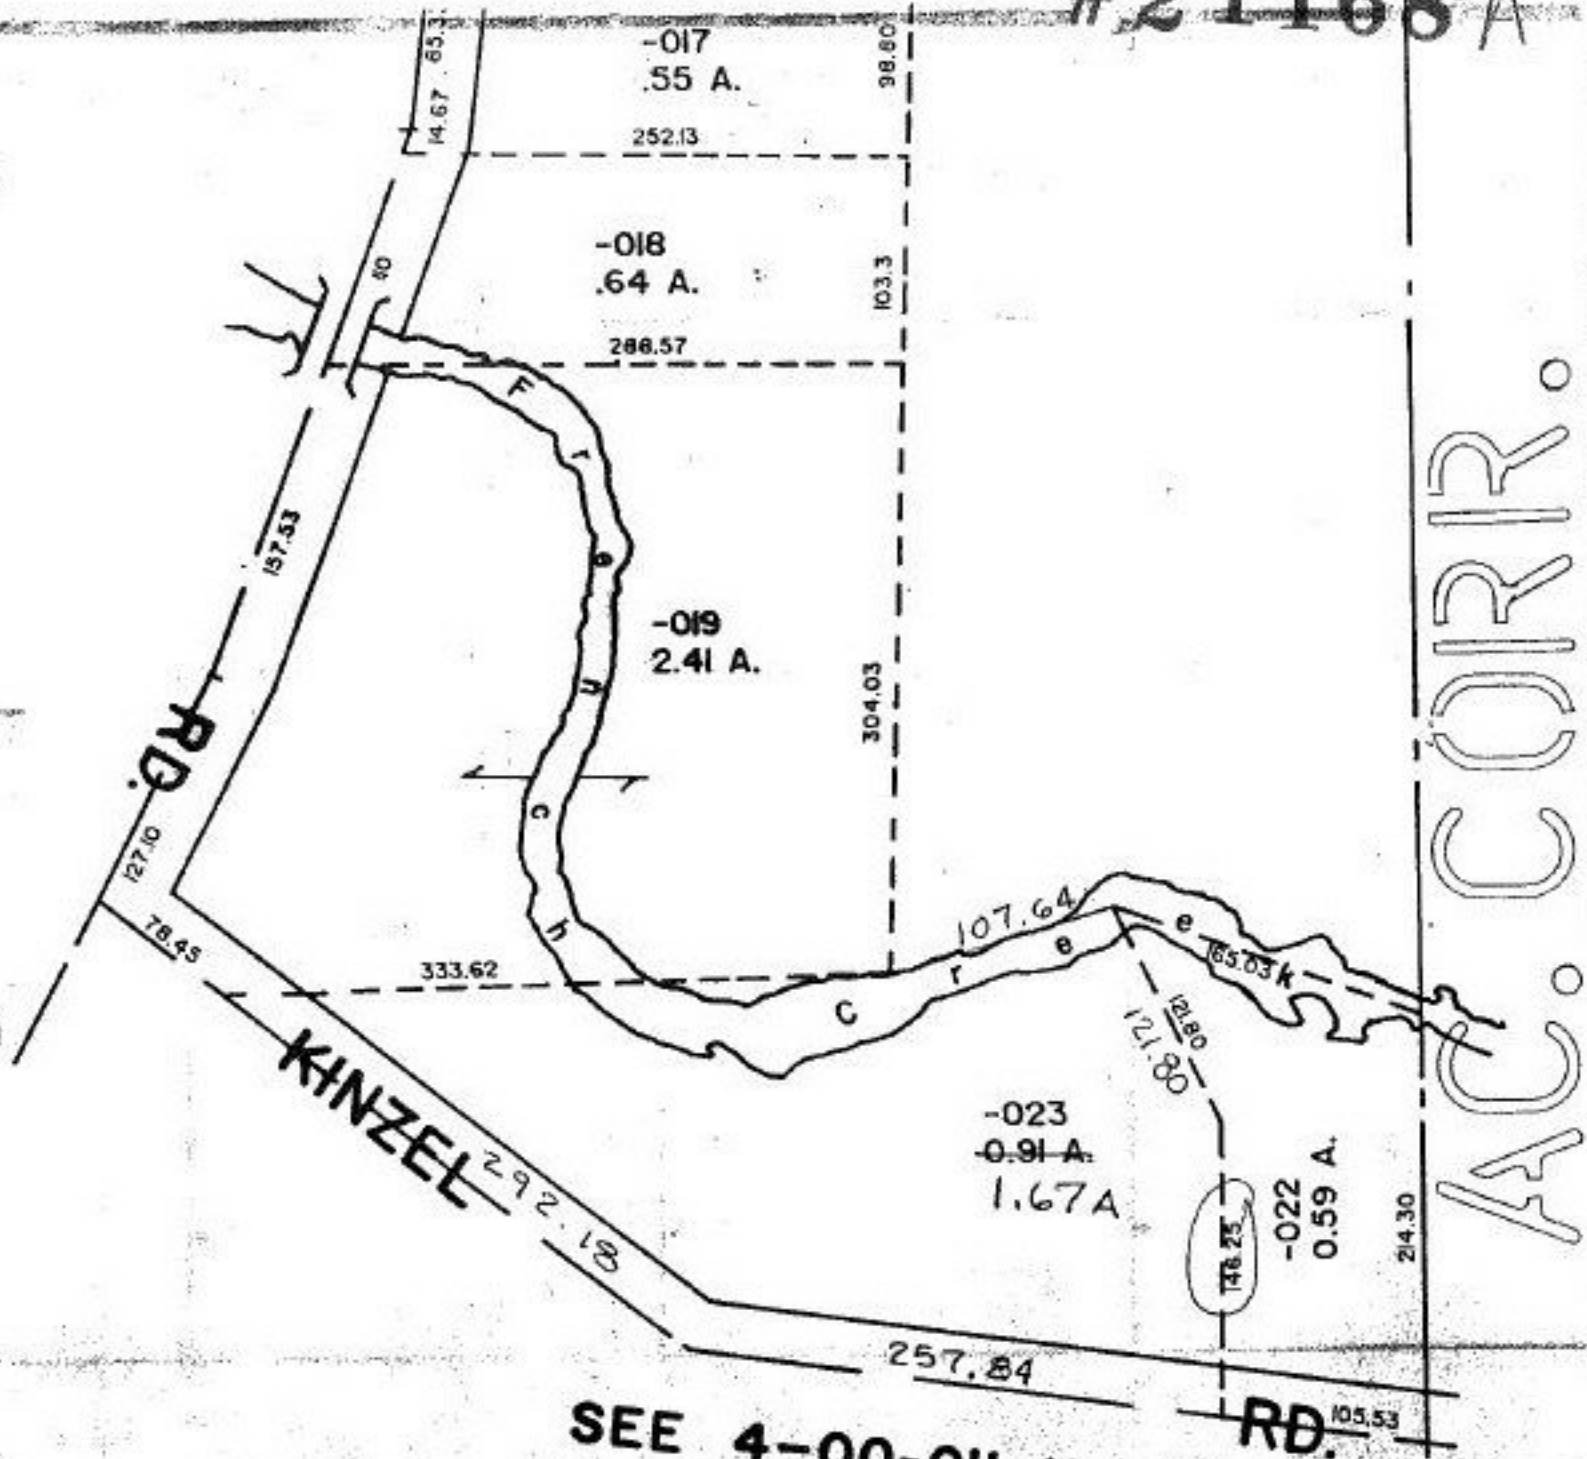

SEE 4-00-011-H

AC CORRECTION
 PRIOR INST. 1281/65 1282/56-58
 04-00-011-106-023 DEED FILE 12-13-94

21168 A

| |
|------------------------------------|
| APPROVED LORAIN CO. MAP DEPT |
| DATE 12-14-94 |
| PAGE 4-00-011-D |
| BY CAROLYN FRANCIS |
| 21168-A |

