


21171

0-016-A

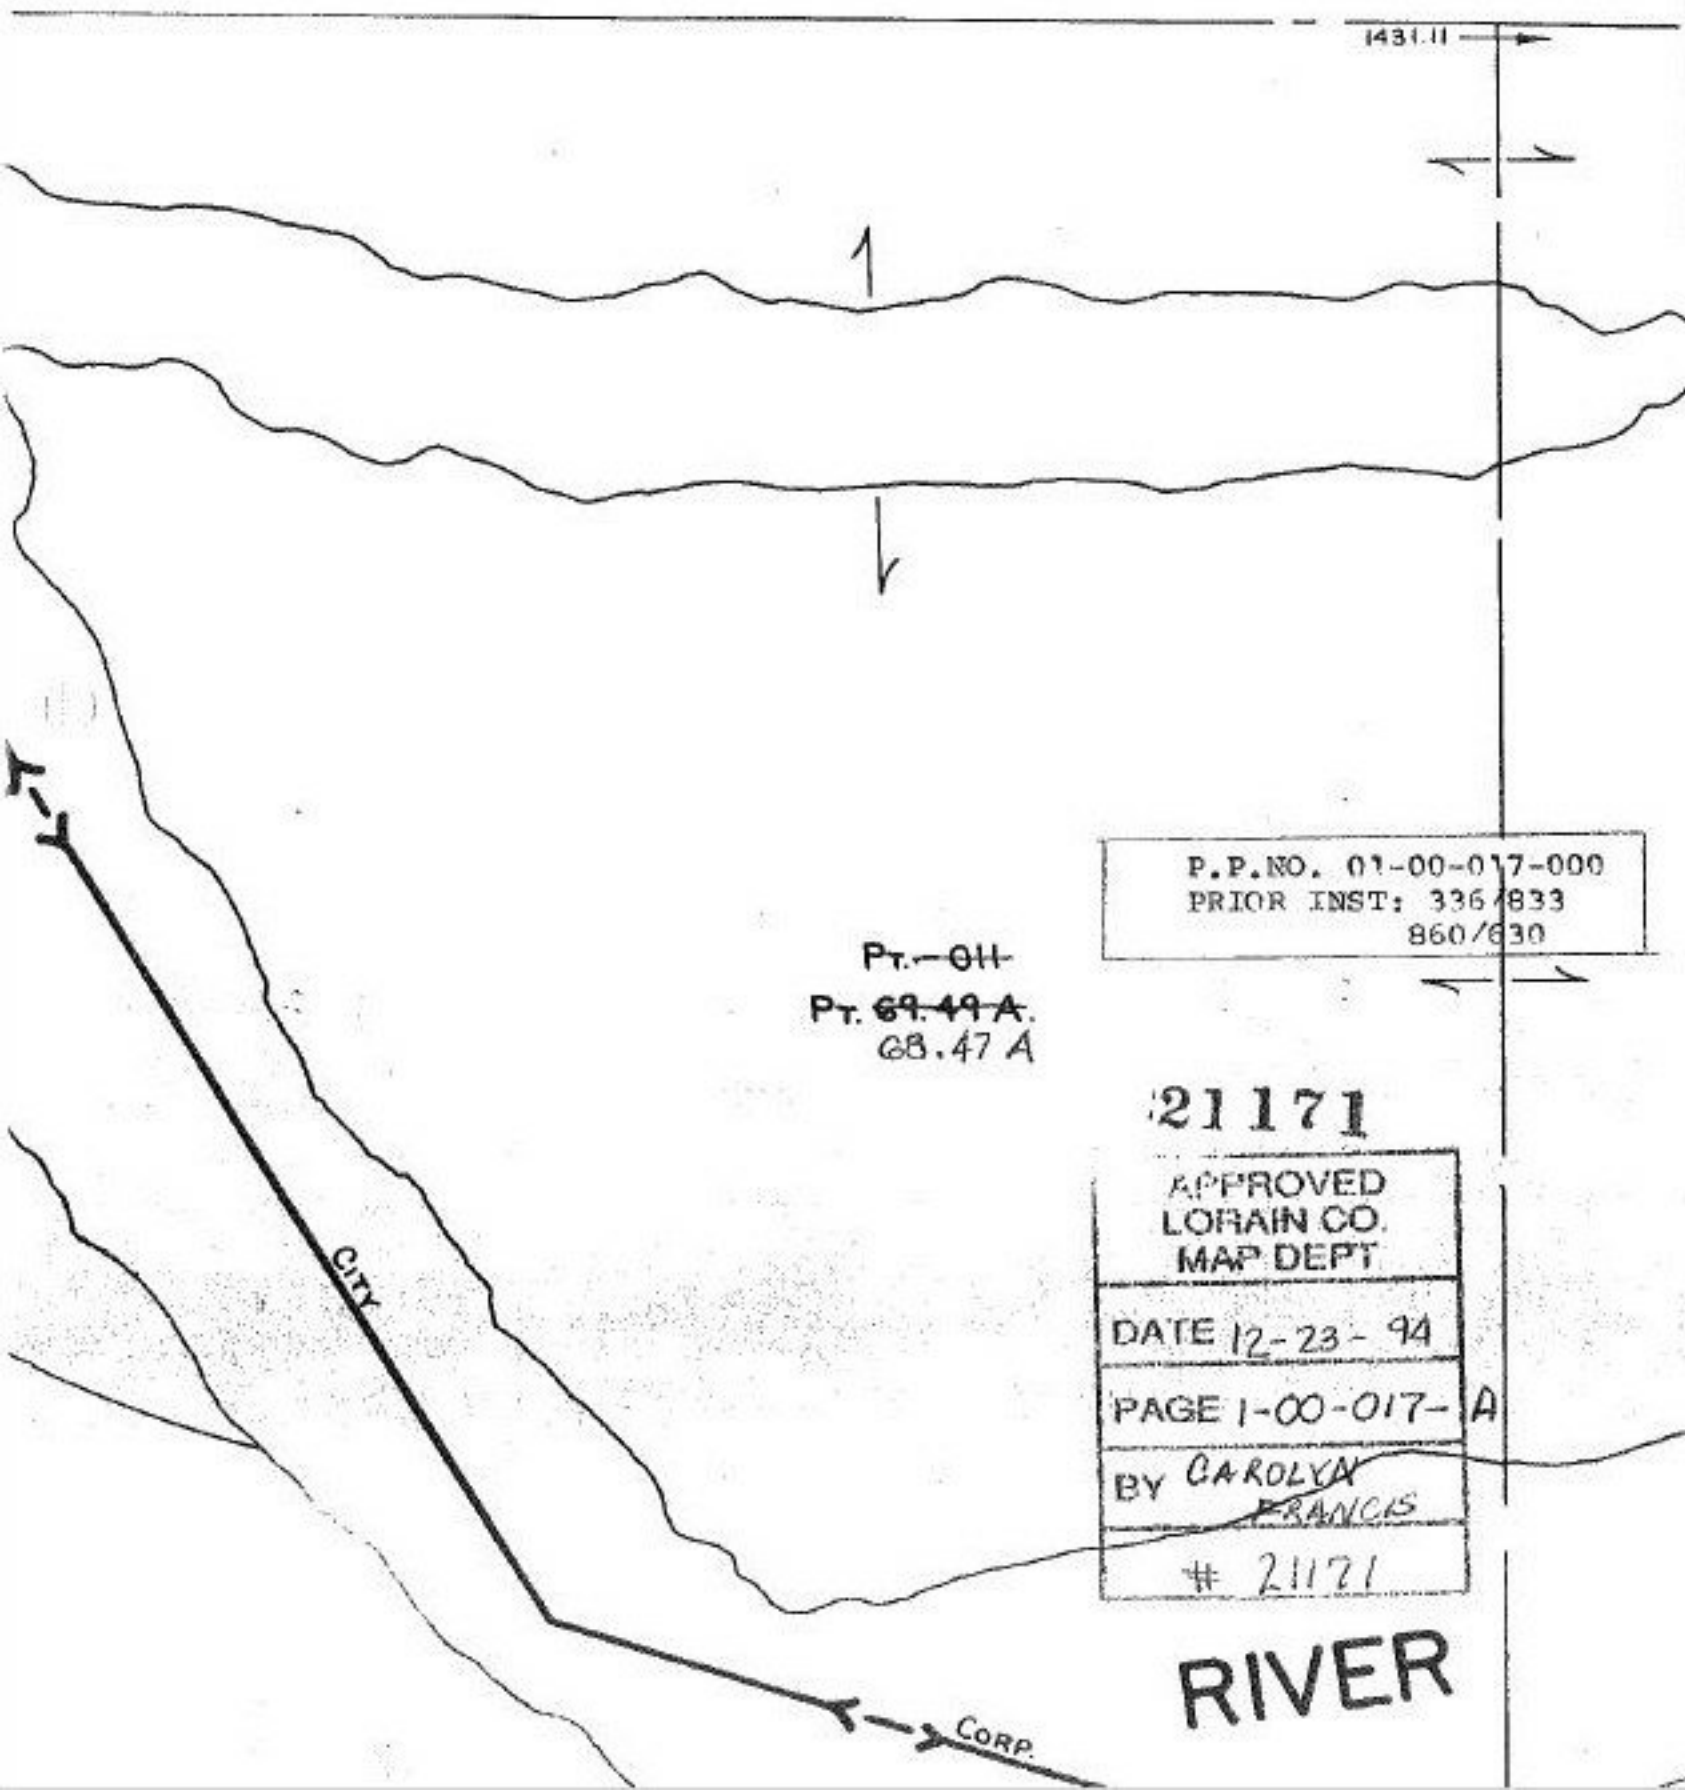

1431.11

1

P.P. NO. 01-00-017-000
 PRIOR INST: 336/833
 860/830

Pt. - 011
 Pt. 69.49 A.
 68.47 A

21171

APPROVED
 LORAIN CO.
 MAP DEPT

DATE 12-23-94

PAGE 1-00-017-A

BY CAROLYN
 FRANCIS

21171

RIVER

CITY

CORP.