


-053
7.44 A.

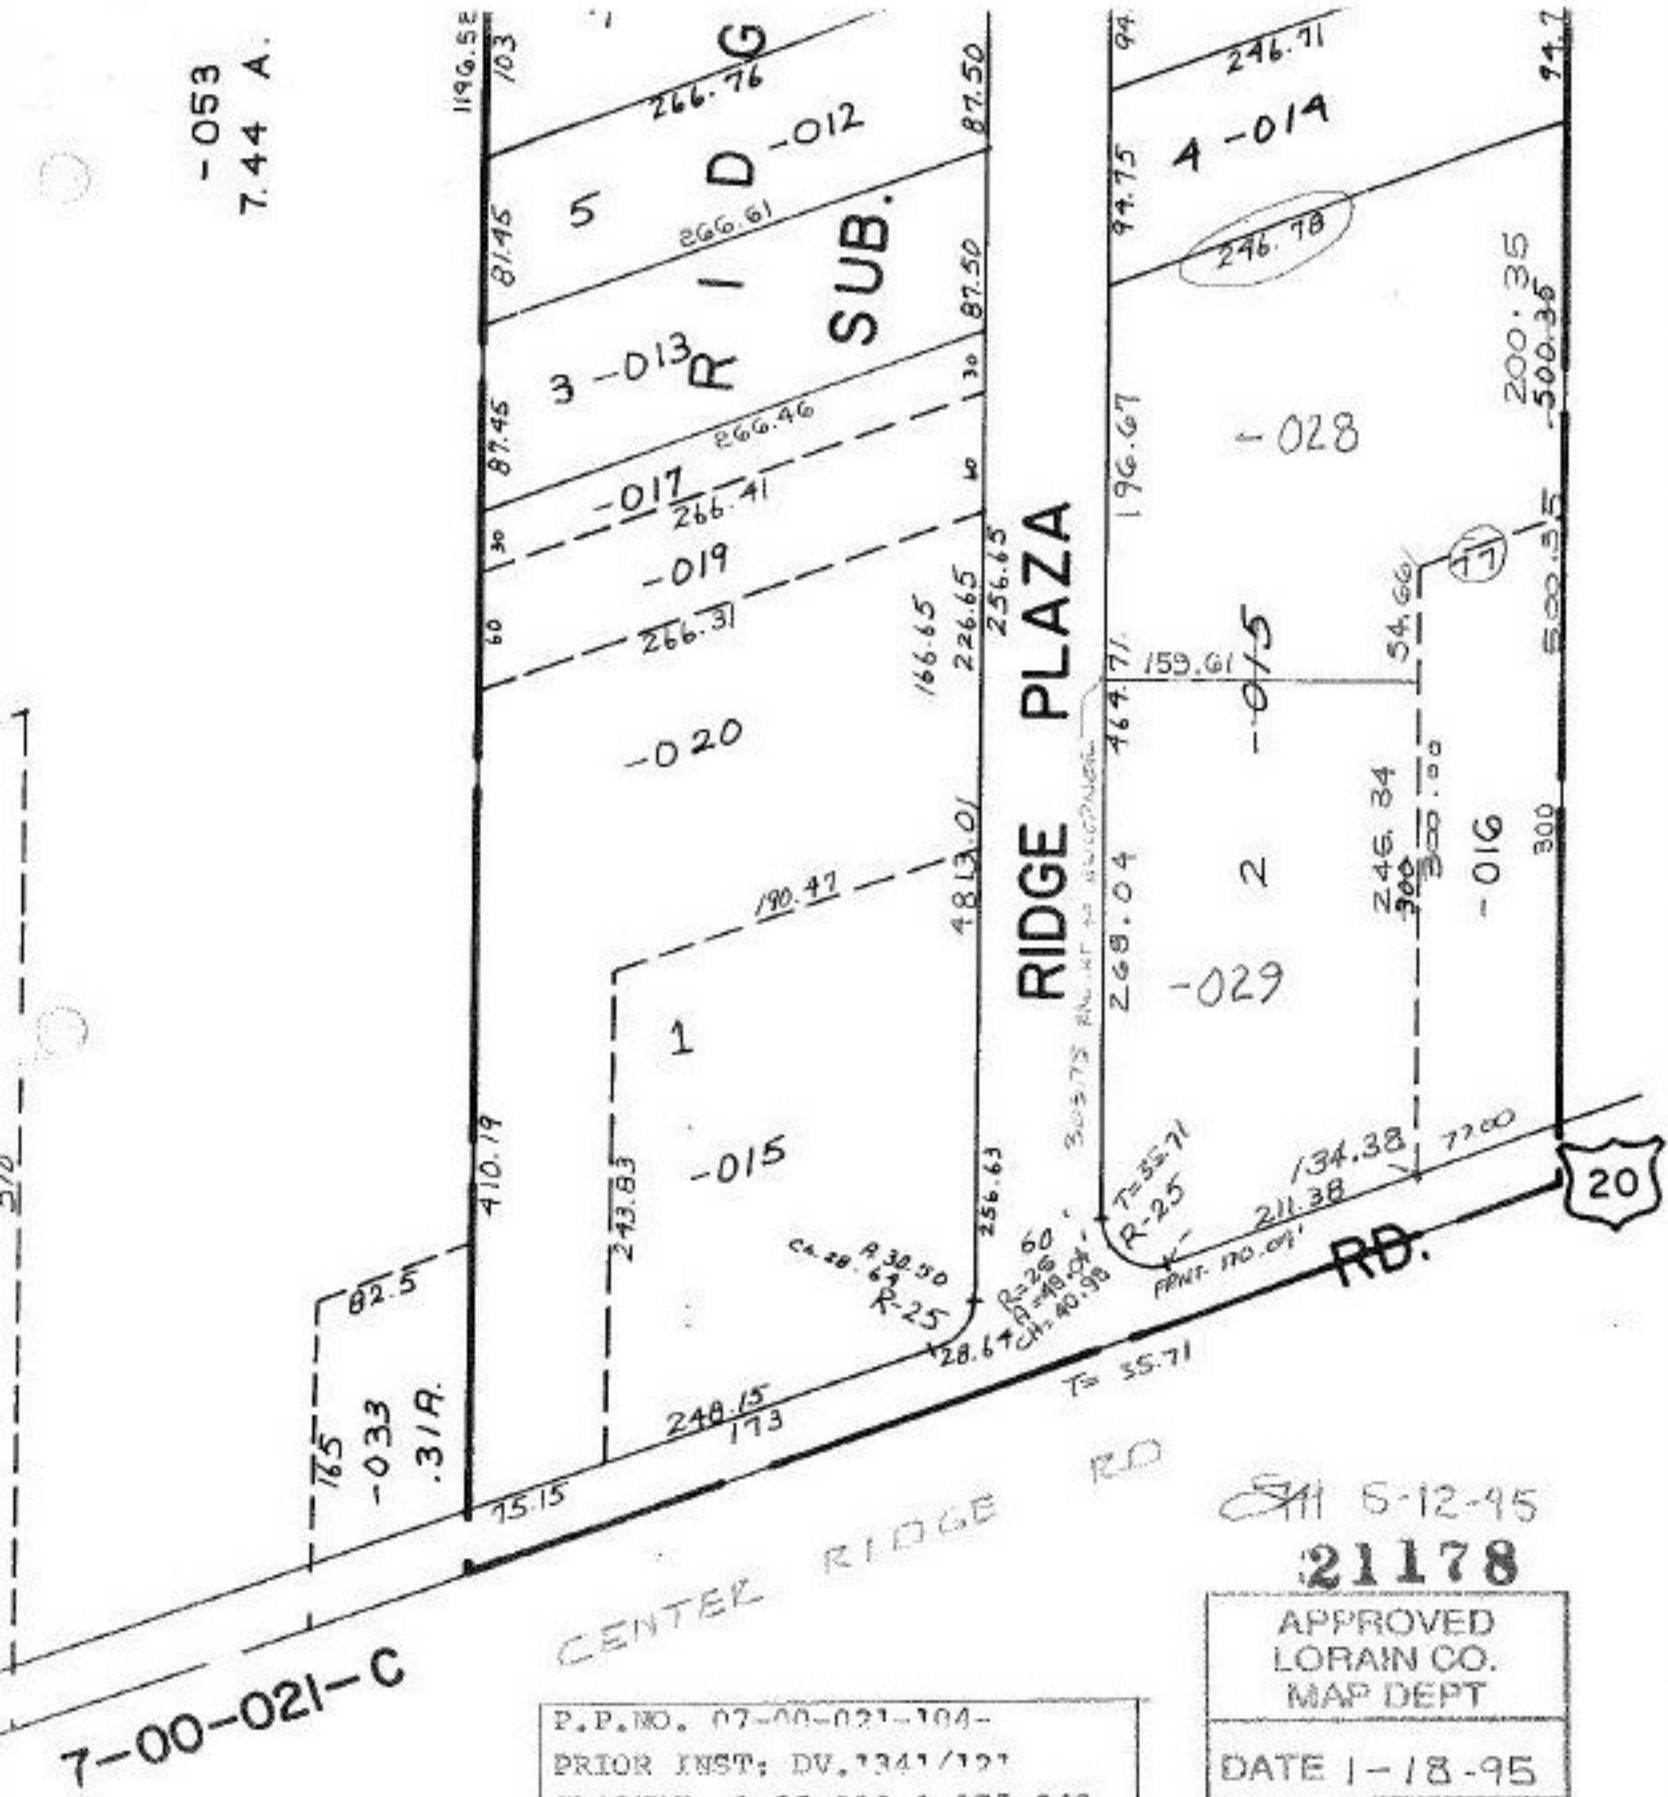

7-00-021-C

CENTER RIDGE RD

RIDGE PLAZA

RD.

P.P. NO. 07-00-021-104-
PRIOR INST: DV. 1341/121
CLOSURE: 1:85, 122 1:175, 240
SURVEYED BY: WESTERN & ASSOC.

5-12-95
21178

APPROVED LORAIN CO. MAP DEPT
DATE 1-18-95
PAGE 7-00-021-A
BY CAROLYN FRANCIS
21178