


# WAKEMAN - LAGRANGE - RICHFIELD

(60)

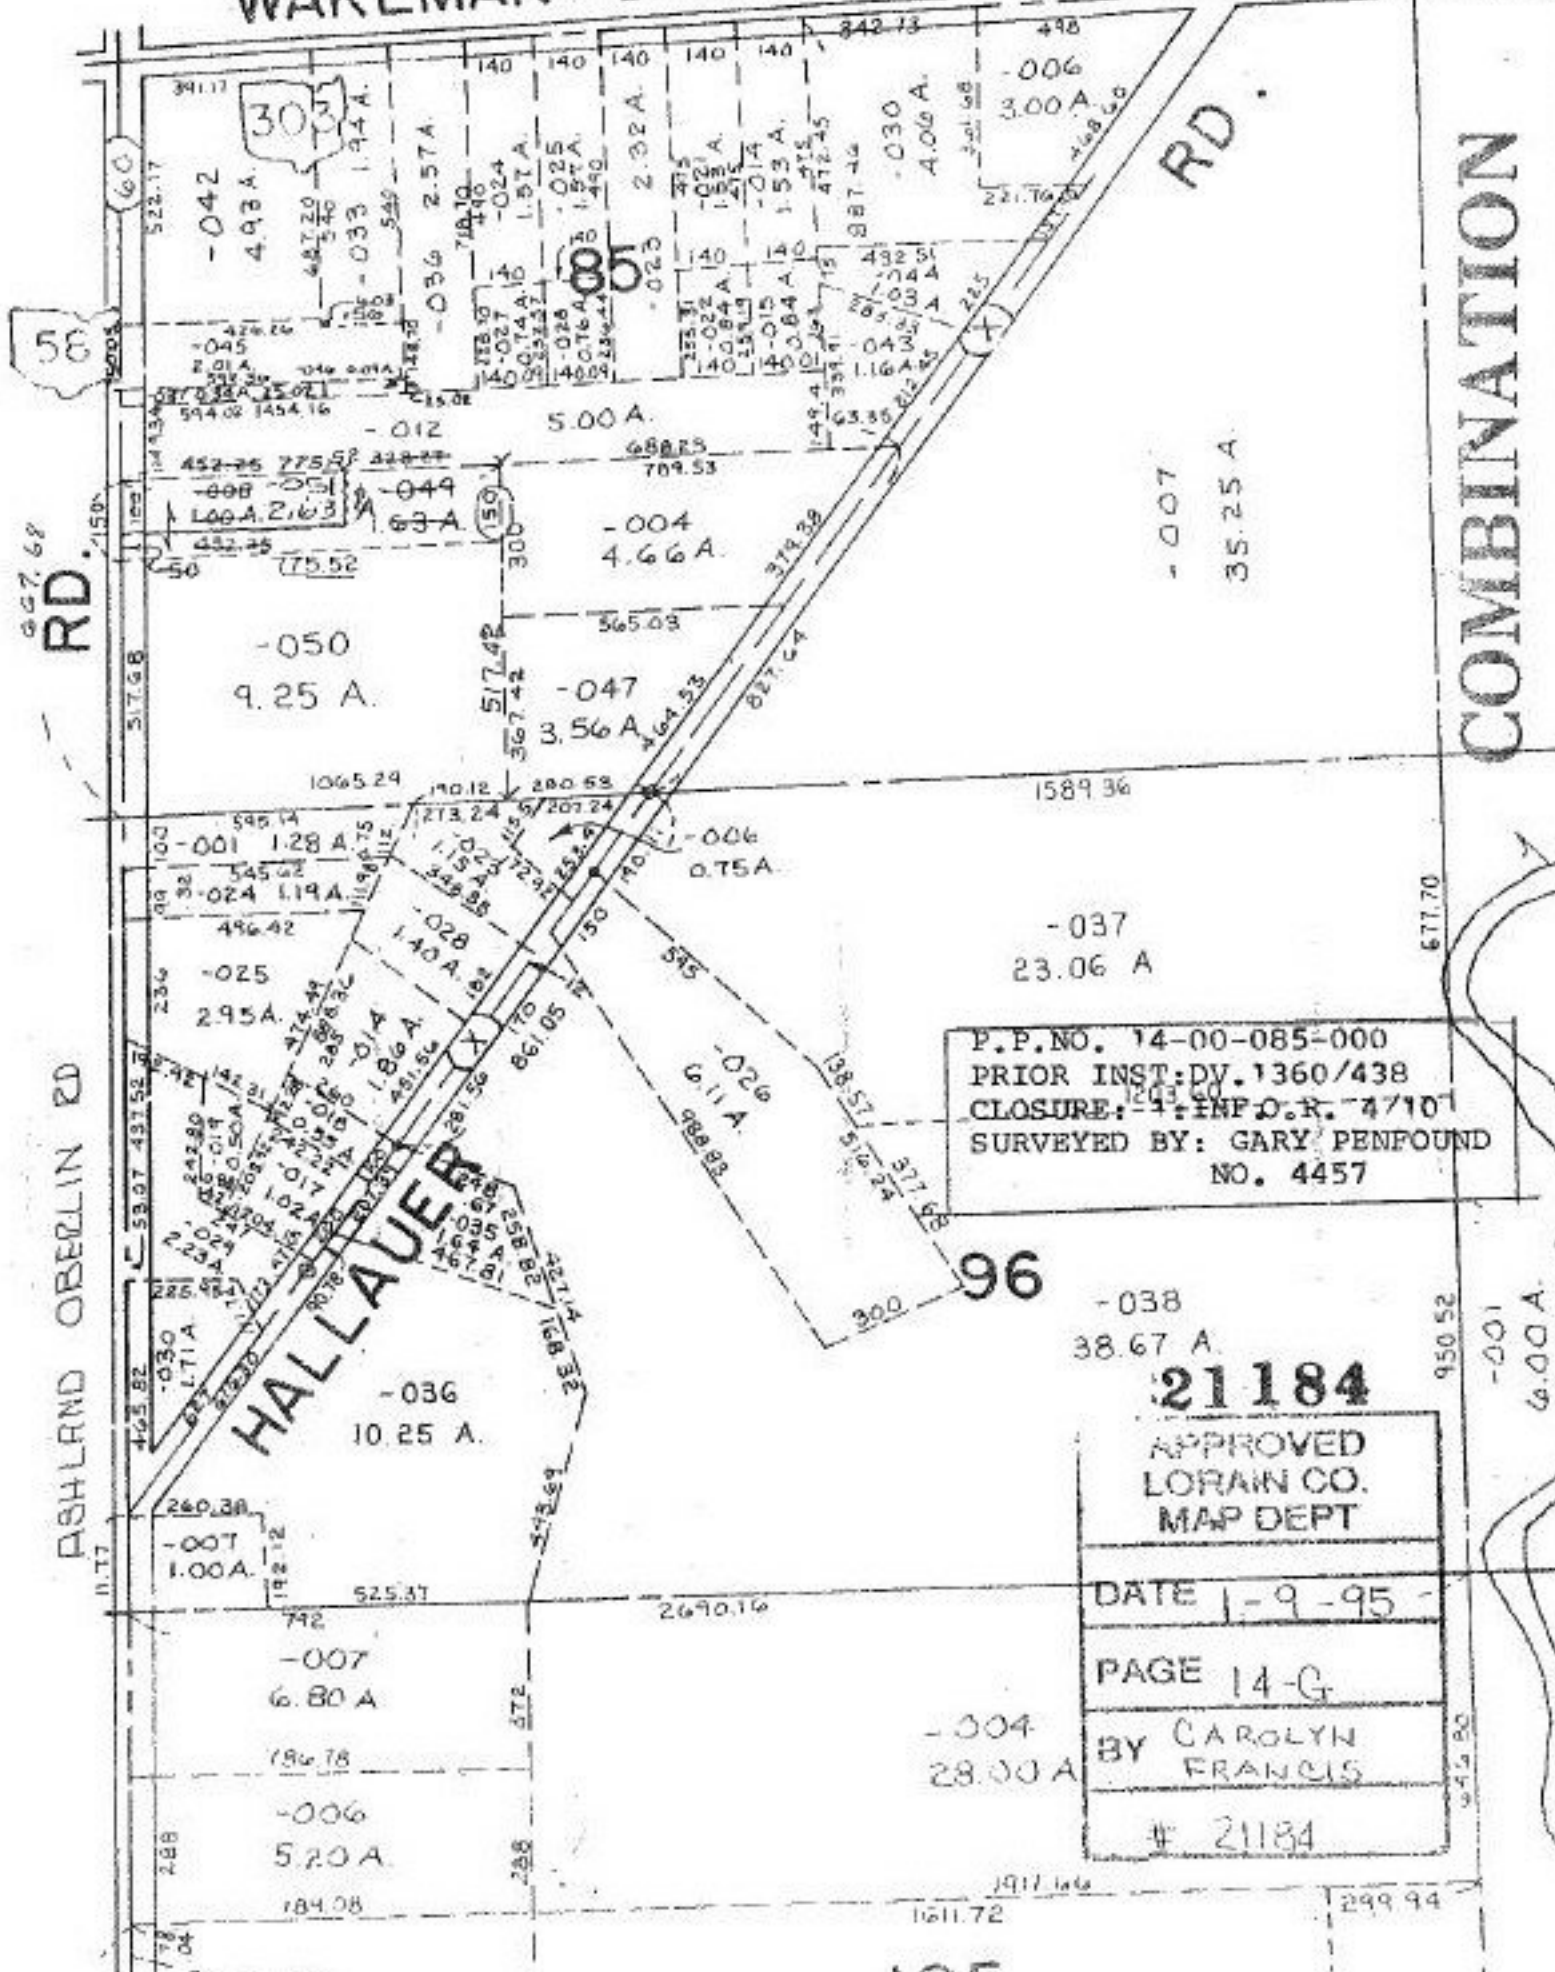

P.P.NO. 14-00-085-000  
 PRIOR INST. DV. 1360/438  
 CLOSURE: 4: INF. O.R. 4/10  
 SURVEYED BY: GARY PENFOUND  
 NO. 4457

96

-038  
38.67 A.

## 21184

APPROVED  
LORAIN CO.  
MAP DEPT

DATE 1-9-95

PAGE 14-G

BY CAROLYN  
FRANCIS

# 21184

-004  
28.00 A.

-007  
6.80 A.

-006  
5.20 A.

-006  
5.20 A.

-006  
5.20 A.