


Pt. -050  
 Pt. 69.40A.

21207

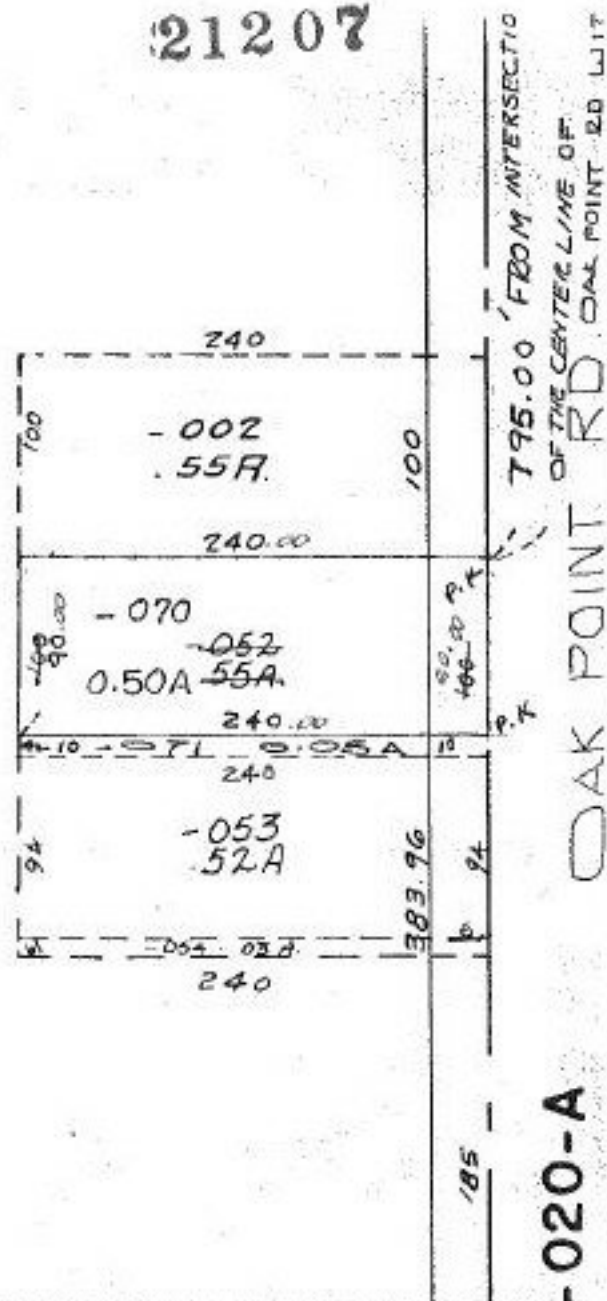

0-020-A

P.P. NO. 05-00-001-000  
 PRIOR INST: DV. 1293/37  
 CLOSURE: 1: INF.  
 SURVEYED BY: CHARLES P. WARYU REG. SURVEYOR

-003  
 15.00R.

21207

APPROVED LORAIN CO. MAP DEPT
DATE 1-26-95
PAGE 5-00-001-B
BY CAROLYN FRANCIS
21207